

Consulting
Engineers and
Scientists



Terminal Dam Inundation Technical Study

State Dam No. 1055.002
National Dam No. CA00888

Prepared for:

San Luis Obispo County Flood Control and
Water Conservation District
County Government Center, Room 206
San Luis Obispo, CA 93408

Prepared by:

GEI Consultants, Inc.
2868 Prospect Park Drive, Suite 310
Rancho Cordova, CA 95670
916-631-4550

December 2017
Project No. 1704408
District Contract No. 552R235715

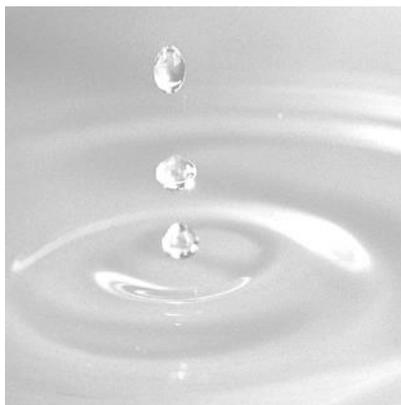


Table of Contents

Executive Summary	v
1. Introduction	1
1.1 Purpose	1
1.2 Horizontal and Vertical Datum	2
2. Project Description	3
2.1 Dam and Reservoir	3
2.2 Watershed and Hydrology	3
2.3 Downstream Impact Areas	4
2.4 Topographic Data and Field Survey	4
3. Previous Studies and Records	7
3.1 DSOD Record Documents	7
4. Dam Breach Inundation Analysis	9
4.1 Hydraulic Model	9
4.2 HEC-RAS Model Development	9
4.2.1 2D Flow Area	9
4.2.2 SA/2D Area Connections	10
4.2.3 Land Cover	10
4.2.4 Boundary Conditions	11
4.2.5 Computational Settings	11
4.3 HEC-RAS 2D Modeling Limitations	11
5. Dam Breach Failure Analysis	13
5.1 Dam Breach Parameters	13
5.2 Dam Breach Sensitivity Analysis	13
6. Results	15
6.1 Dam Sunny-Day Failure Results	15
6.2 Floodplain Inundation Results	15
7. Limitation of Liability	19
8. References	21

Tables

- Table 1. Terminal Dam Statistics Summary (Source: DSOD)
Table 2. Hydraulic Structures Downstream of Terminal Dam

- Table 3. Field Measurement of Bridges (December 2017)
- Table 4. 2D Flow Area Gridded Model Sensitivity Comparison
- Table 5. NLCD Land Cover and Assigned Manning's N-Value
- Table 6. Assigned Manning's N-Value Model Sensitivity Results Comparison
- Table 7. Ranges of Possible Values for Breach Characteristics (Source: *HEC-RAS Dam Break Study, August 2014*)
- Table 8. Sunny-Day Breach Parameters (Base Case)
- Table 9. Terminal Dam Breach Sensitivity Analysis Parameters
- Table 10. Terminal Dam Breach Sensitivity Hydrograph Comparison
- Table 11. Terminal Dam Inundation Cross Sectional Results
- Table 12. Terminal Dam Sunny Day Failure Impact Facilities

Figures

- Figure 1. Project Location
- Figure 2. Terminal Dam Aerial View
- Figure 3. Elevation – Storage Capacity Curve
- Figure 4. Drainage Watersheds
- Figure 5. HEC-RAS Model Extents & Geometry Features
- Figure 6. Terminal Dam Breach Hydrograph Comparisons
- Figure 7. Downstream Flood Wave Hydrograph Attenuation

Appendices

- Appendix A. Terminal Dam Design/As-Built Drawings
- Appendix B. Survey Field Notes Performed by the District
- Appendix C. Flood Inundation Maps

AUTHOR INITIALS: CV

J:\San Luis Obispo County\Project\1705077 SLO Lopez and Terminal Dams Inundation Mapping\9.0 Technical Documents\01 Reports\Terminal Dam Inundation Study\Terminal Dam Inundation Study Dec2017 v3.docx

Engineer's Certifications

I, Mark Fortner, hereby certify on December 27, 2017, that I supervised the preparation of this study, *Terminal Dam Inundation Technical Study*, as a professional engineer licensed in the State of California.

I, Chong Vang, hereby certify on December 27, 2017, that I performed the dam failure and inundation analysis of this study, *Terminal Dam Inundation Technical Study*, as a professional engineer licensed in the State of California.

This page left blank intentionally.

Executive Summary

San Luis Obispo County Flood Control and Water Conservation District (District) retained GEI Consultants, Inc. (GEI) to perform an analysis to estimate the downstream flooding due to a hypothetical failure of Terminal Dam for a fair weather (sunny day) event. The District is required to submit inundation maps to the California Department of Water Resources (DWR) Division of Safety of Dams (DSOD) for Terminal Dam by January 1, 2018, per recently adopted “Emergency Regulations for Inundation Maps.” The analysis was performed to assess the potential adverse incremental consequences, including loss of life and significant property damage. The dam is currently classified as an “extremely high” hazard dam by California Department of Water Resources (DWR) Division of Safety of Dams (DSOD). This analysis does not refer to the structural integrity of the dam itself, but rather the potential impacts if a dam failure should occur.

Terminal Dam was constructed in 1969 as part of the Lopez Water Supply Project. Terminal Dam is owned and operated by the District, under the purview of the County of San Luis Obispo Public Works Department. Terminal Dam and reservoir is a tributary to the Arroyo Grande Creek in San Luis Obispo County, California, approximately 4.7 miles northeast of the center of the town of Arroyo Grande, California. Terminal Reservoir has a drainage area of 0.63 square miles and provides storage and agricultural water uses for the local communities. The reservoir has an area of 37 acres and a storage capacity of 844 acre-feet (DSOD). The normal operating reservoir level is 330.8 ft (NAVD 88).

GEI simulated a hypothetical piping failure of the Terminal Dam starting at full reservoir pool to the upstream toe at El. 287.8 ft with an average breach width of 121.9 ft, and a time to failure of 0.5 hours.

The hypothetical failure of Terminal Dam for the sunny day mode would create a flood wave that could reach 33 ft-high downstream of the dam in the Arroyo Grande Creek with a peak breach flow of 25,391 cubic feet per second (cfs). The flood wave would travel 8.9 miles downstream, inundating approximately 1,373 acres of floodplain downstream of the dam through the City of Arroyo Grande and town of Oceano before discharging into the Pacific Ocean; 105 acres of the City of Arroyo would be inundated by the dam failure. The peak flood wave for the sunny day failure would take 2 hours and 55 minutes to reach the ocean.

The inundation maps for the sunny day, full reservoir storage dam failure analyses are provided in **Appendix C**.

This page left blank intentionally.

1. Introduction

1.1 Purpose

Under a newly enacted state law, effective July 1, 2017, all dam owners are required to prepare an Emergency Action Plan (EAP) for their dams and critical appurtenant structures under certain conditions and specific time limits (California Water Code Sections 6160 – 6162). Terminal Dam, classified as an “extremely high” hazard dam by the California Department of Water Resources (DWR) Division of Safety of Dams, an EAP is to be submitted to DSOD and California Governor’s Office of Emergency Services (CalOES) by the end of January 1, 2018. As owner of Terminal Dam, San Luis Obispo County Flood Control and Water Conservation District (District) retained GEI Consultants, Inc. (GEI) to develop inundation maps for a Terminal Dam failure mode analysis to be submitted to DSOD per recent adopted “Emergency Regulations for Inundation Maps.” The EAP for dams are a guidance document identifying the potential emergency conditions at the dam and specific actions to be followed to minimize loss of life and property damage. The level of detail to be included in the EAP consists of dam break inundation maps identifying the extents of the breach flood wave attenuation downstream of Terminal Dam.

The dam break analyses and inundation mapping are to be consistent with California Code of Regulations, Title 23. Waters, Division 2. Department of Water Resources, Chapter 1. Dams and Reservoirs, Article 6. Inundation Maps. GEI performed dam breach analyses by modeling a fair weather (sunny day) breach in accordance with Federal Emergency Management Agency (FEMA) guidelines and routed the breach hydrograph downstream with the latest hydraulic numerical model program from the US Army Corps of Engineers (USACE) called Hydrologic Engineering Center’s River Analysis System (HEC-RAS).

A summary of the scope of work performed by GEI for this study is presented below:

Data Collection

1. Research and collect information of the dam at DSOD record library and identify potential downstream flood wave extents. Coordinate with the District to obtain data of obstruction structures that may impact the flood wave downstream.

Dam Inundation Technical Study

1. Develop floodplain terrain based on light detection and ranging (LiDAR) collected from Pacific Gas and Electric Company (PG&E), California Coastal Conservancy Coastal LiDAR Project, and US Geological Survey (USGS) National Elevation Dataset (NED). Assigned roughness values for the channels and overland flow areas are based on National Land Cover Database (NLCD) 2011 Land Cover by USGS.
2. Develop breach parameters for the hypothetical dam failure and develop dam breach outflow hydrographs.

3. Perform dam breach parameter sensitivity analyses.
4. Route the base case scenario dam breach hydrograph through the downstream area to create inundated floodplains using HEC-RAS software for unsteady flow conditions.
5. Perform sensitivity analyses to test influence of key assumptions on the flow modeling results.
6. Develop downstream inundation maps with the use of Geographic Information System (GIS) software, ArcMap.
7. Prepare report to summarize the dam breach analyses, present key assumptions of the unsteady flow model input and output results.

1.2 Horizontal and Vertical Datum

The projection used in preparation of this report is in California State Plane Coordinate System Zone 5. The horizontal datum is in the North American Datum of 1983 (NAD83), GRS80 spheroid. Elevations in this report are in feet and referenced with respect to the North American Vertical Datum of 1988 (NAVD88) unless noted on the description. The vertical datum conversion from National Geodetic Vertical Datum 1929 (NGVD29) to NAVD88 is +2.848 feet based on VERTCON conversion at Terminal Dam. The abbreviation “EI” represents elevation.

2. Project Description

2.1 Dam and Reservoir

Terminal Dam and Reservoir are in San Luis Obispo County, California, approximately 4.7 miles northeast of the City of Arroyo Grande. The dam is owned and operated by the District. A site location map is shown on **Figure 1**. Terminal Dam is an earth fill dam that was completed in 1969 to provide storage, municipal, and domestic water uses for downstream communities. The reservoir acts as a raw water impoundment providing 30 to 45 days of detention time for Lopez Lake, located at the headwaters of Arroyo Grande Creek, water prior to being treated at the Lopez Water Treatment Plant. Runoff from a half mile segment of Orcutt Road drains into the reservoir but a diversion channel encircles the remainder of the reservoir and prevents runoff from entering the reservoir.

The center core of the dam is composed of materials identified as Random Core Zone “F” at 15 ft wide at the dam crest with slopes at 1H: 2V to upstream and downstream toe, and Random Zone “C”. See As-Builts drawings in **Appendix A**. The 53 ft high dam impounds a volume of 844 ac-ft of water with a crest length of 550 ft. A summary of the dam and reservoir data for Terminal Dam is presented in **Table 1**. See **Figure 2** for dam aerial view. See **Figure 3** for storage-elevation capacity curve of Terminal Dam. The analysis is based on the original capacity curve (**Figure 3**) of the reservoir and does not reflect the current reservoir capacity that may have diminished over time through sediment build-up from upstream basin surface water run-off.

A concrete poured uncontrolled spillway is located on the southwest end of the dam with an ogee crest at elevation at El. 331.8 ft. The crest has an approximate length of 35 ft and design head of 2 ft. The invert slope of the spillway side channel is at 0.01 ft/ft until reaching 145 ft downstream of the center axis of the dam to transition to steeper slopes of 0.178 ft/ft. The spillway side channel is a trapezoidal chute with upstream width of 3 ft and widen to a 10 ft base rectangular chute that is 12 ft downstream. At that location, the spillway becomes a 10 ft wide rectangular chute.

Terminal Dam has outlet structures comprised of an intake tower on the upstream side with four 24-inch butterfly valves at various elevations and one 36-inch isolation butterfly valve to isolate the tower from the low-level outlet pipe. The low-level outlet pipe is a 36-inch concrete encased steel pipe with eight concrete collars along the alignment. The downstream blow-off is a 20-inch butterfly valve, which daylights into the spillway side wall. The valves can be adjusted when necessary to adjust flows into the downstream treatment plant.

2.2 Watershed and Hydrology

Terminal Dam is in the Lower Arroyo Grande Creek sub-basin watershed (USGS Watershed Boundary Dataset [WBD], Hydrologic Unit 10) of the Arroyo Grande Creek watershed (WDB Unit 12) (shown on **Figure 4**). The Lower Arroyo Grande Creek sub-basin has a

drainage area of approximately 30.3 square miles and drains into Meadow Creek-Frontal Pacific Ocean sub-basin watershed. Within the sub-basin, an approximate land area of 0.63 square miles drains into Terminal Reservoir.

The climate in the County of San Luis Obispo is mild with precipitation ranges from less than 10 inches per year in the eastern portion to more than 40 inches per year at higher elevations in the Santa Lucia Mountain range. In Arroyo Grande, CA the beginning of a water year can reach mean precipitation of 1.7 inches in November to 3.87 inches in February to March (Hydrology Report 2005). Record low temperatures can reach 23 degrees Fahrenheit in the winter season to record highs of 108 degrees Fahrenheit in summer months.

2.3 Downstream Impact Areas

Downstream of Terminal Dam are the cities of Arroyo Grande, Grover Beach, and unincorporated community Oceano. Arroyo Grande has an estimated population of 18,097 (US Census, 2016) and a total area of 5.83 square miles, Grover Beach has an estimated population of 13,641 (US Census, 2016) and with a total area of 2.31 square miles, and Oceano with a population of 7,286 (US Census, 2010) and total area of 1.55 square miles. The cities are in the coastal plains between the Pacific Ocean and the coastal mountain and valleys with majority of the cities in the low lying flat area with average elevations of El. 130 ft in the northeast city limits of Arroyo Grande close to the mountain terrains to southwest area with average elevations of 50 feet towards Grover Beach and Oceano. The flow path downstream of the dam will flow into Arroyo Grande Creek traveling southwest. Dense residential neighborhoods, commercial and industrial developments, recreational facilities, public facilities, and schools are concentrated in the southern portions of the cities of Arroyo Grande and Grover Beach and northern portion of Oceano.

Eight in-line bridge/structures are identified as impact structures due to a hypothetical dam failure from Terminal Dam to the termination point into the ocean. These structures are considered significant in that they can impact and impede the flood wave of the dam breach and are incorporated in the hydraulic model development. **Table 2** includes the list of structures that are included in the hydraulic model evaluation.

2.4 Topographic Data and Field Survey

The best available topographic data was obtained through National Oceanic and Atmospheric Administration (NOAA) Office for Coastal Management, Digital Coast. The Digital Coast houses data sets which ranges from economic data to satellite imagery. A data request for the San Luis Obispo County area through the Digital Coast retrieved LiDAR data by PG&E (2011 and 2013 dataset) and the California Coastal Conservancy Coastal LiDAR Project (2010). Additional terrain data from the National Elevation Dataset (NED) raster product produced and distributed by the USGS were collected. The NED is derived from diverse source data and processed to a common coordinate system and unit of vertical measure. The NED was available at a resolution at 1/3-arc-second (approximately 10 meters) for San Luis Obispo County. The NED raster was used as a supplemental dataset for data gaps within the PG&E and Coastal LiDAR Project.

The LiDAR was mosaic with the Geographic Information Systems (GIS) software ArcMap with the PG&E data set as the priority set, Coastal data set as secondary, and the USGS NED set as last priority. The gridded raster resolution was set as the finest grid from the data sets which was the PG&E data at 1 foot grid. The three data were projected to the same projection, California State Plane Coordinate System Zone 5, in units of feet.

GEI staff coordinated with the District staff to obtain data of bridge structures along Arroyo Grande Creek. A developed hydraulic model, HEC-RAS, was provided to GEI showing the bridge crossings from Highway 101 downstream to the railway crossing. Field survey and measurement of the structures performed by the District is listed on **Table 3**.

This page left blank intentionally.

3. Previous Studies and Records

3.1 DSOD Record Documents

Recorded documents of Terminal Dam were retrieved from DSOD. The documents listed below are documents considered relevant to this study and does not include all documents at DSOD. The documents included:

1. Dam Statistics Summary Information Summary.
2. Record of Inspection of Dam performed by DSOD.
3. Certificate of Approval.
4. DSOD Analysis of Spillway.
5. DSOD Embankment Dam Stability Analysis.
6. Lopez Water Supply Project Terminal Dam and Reservoir.
7. Hydrology for Terminal Dam and Reservoir, Lopez Water Supply Project.
8. Spillway Hydraulic Calculation for Terminal Dam and Reservoir, Lopez Water Supply Project.

No previous studies of inundation maps of Terminal Dam were provided or available at the time of this study.

This page left blank intentionally.

4. Dam Breach Inundation Analysis

4.1 Hydraulic Model

A hydraulic model was developed to evaluate a hypothetical dam failure analysis of Terminal Dam using HEC-RAS, version 5.0.3. This version of HEC-RAS can perform one-dimensional (1D), two-dimensional (2D), as well as combined 1D and 2D unsteady-flow modeling (Saint Venant equations or Diffusive Wave equations). The hypothetical dam failure produced outflow hydrographs that was routed downstream into the floodplain. The advantages of using 2D modeling for the hypothetical dam failure are:

- Detailed dam breach analyzes.
- Detailed 2D channel and floodplain modeling.
- Direct connection of Terminal Reservoir storage area into the 2D floodplain areas with a hydraulic structure connection (Terminal Dam), and/or the ease of transfer of the dam break hydrograph as an indirect inflow hydrograph boundary condition to the 2D floodplain downstream of the dam.
- One floodplain area modeled from the reservoir to the termination point.
- Mixed flow regime is applied for this application. The 2D capability can handle supercritical and subcritical flow, flow transition from subcritical to super critical, and super critical to subcritical (hydraulic jumps).

2D modeling of the reservoir and floodplain are accomplished by using HEC-RAS geometric feature of adding or drawing *Storage Area* and *2D Flow Area* elements/polygons into the model, developing the 2D computational mesh (structured and unstructured), then linking the 2D flow areas to 1D elements such as hydraulic structures and/or directly connecting boundary conditions to the 2D areas. Associating the terrain to the 2D flow area, HEC-RAS will run a 2D geometric pre-processor for each mesh to establish a list of hydraulic properties table. Additional explanation and detailed procedure are included in the HEC-RAS 2D Modeling User's Manual.

4.2 HEC-RAS Model Development

The developed hydraulic 2D model encompasses the downstream floodplain simulated as an open area under unsteady state flow condition. **Figure 5** shows the topographic terrain extents and the hydraulic model geometric features detailed in HEC-RAS.

4.2.1 2D Flow Area

A HEC-RAS geometry *2D Flow Area* was developed downstream of Terminal Dam to the Pacific Ocean to evaluate the floodplain. To determine the appropriate grid selection for the

2D Flow Area, a model with 2D mesh cell spacing of 50 ft x 50 ft, a model of 100 ft x 100 ft, and a model of 200 ft x 200 ft was analyzed for comparison. The three models were evaluated for floodplain inundation extents downstream of the dam using the same inflow hydrograph with a peak discharge of 25,391 cfs and a volume of 840 ac-ft. Comparing the three gridded models, the 50 ft gridded model inundated a total area of 3,439 acres, the 100 ft gridded model inundated a total area of 3,537 acres, and the 200 ft gridded model inundated a total area of 3,492 acres. The comparison of the additional results are provided in **Table 4**. From the comparison, the grid spacing of 100 ft x 100 ft was selected as the optimal grid size to perform detailed floodplain modeling. Although the time to finish the simulation was not as short as the 200 ft gridded model, the 100 ft gridded model inundation results are within a tolerable range with the 50 ft gridded model, which can capture reasonable results for urban area flood mapping.

HEC-RAS geometric *2D Area Breaklines* was added to capture the alignment of ridges, berms, and high grounds. The *2D Area Breaklines* forced the generated mesh to align its cell faces along the line. This feature will provide additional details to the floodplain area to direct flood wave to the appropriate flow path.

4.2.2 SA/2D Area Connections

HEC-RAS hydraulic connection features called *SA/2D Area Connections* was included in the 2D flow area to represent in-line structures (such as bridges) listed on **Table 3**. *SA/2D Area Connections* is a feature to input data for bridges into the model, such as elevation of top deck, bridge dimensions, culverts, piers, bridge coefficients, etc. The dimensions were referenced from the field survey collected by the District and a previous hydraulic model (HEC-RAS) developed by the District.

4.2.3 Land Cover

Land cover was based on USGS National Land Cover Database (NLCD) of 2011. Calibration efforts were not performed due to unavailable data, therefore, roughness (Manning's N-Value) values were assigned based on values reported for natural stream channels (Chow 1959) and based on best engineering judgement. **Table 5** includes the list of land cover type and the assigned roughness in the hydraulic model.

Additional sensitivity testing was performed for the land cover and by increasing and decreasing the base n-values by 10 percent. The land cover sensitivity test was performed to test the n-value sensitivity associated with the floodplain. The analyses will determine if the selected base n-values should be changed based on the percentage of depth difference at specific locations downstream of the dam. The 100 ft x 100 ft gridded *2D Flow Area* described in Section 4.2.1 was used with the n-values from **Table 5** as the base land cover model. Comparing the base land cover model to the +10 percent increase of n-value and 10 percent decrease of n-value models, the base land cover model inundated a total area of 3,537 acres, 3,551 acres for the +10 percent case, and 3,492 acres for the -10 percent case. **Table 6** summarizes the comparison of depth results at specific locations within the floodplain.

By increasing the base n-values, the +10 percent results generally decreased the inundation depths. By decreasing the n-values, the inundation depths increased. As the inundation depth increases in the floodplain, the comparative depth percent differences decreased, meaning the inundation depths were marginally the same with an increase of inundation depth. Example, on **Table 6** the Huasna Road Bride percent differences were -0.7 percent for 10 percent increase of n-value, and 0.7 percent for 10 percent decrease when comparing to the base n-value. From the n-value comparative results, the base n-values were used for the Terminal Dam failure inundation analysis.

4.2.4 Boundary Conditions

In accordance with the FEMA guidelines for a sunny day dam failure, the reservoir was modeled at normal storage capacity with the starting water surface elevation set at the spillway elevation of El. 331.8 feet. A constant inflow of 10 cubic feet per second (cfs) into the reservoir was applied to account for upstream inflow.

The downstream boundary condition at the model termination point, Pacific Ocean, was assigned a normal depth, friction slope of 0.001. The termination point was extended downstream to a point such that the hydraulic calculated energy slope will not impact the results upstream.

4.2.5 Computational Settings

The dam break model evaluation utilized a 1-second computation time step. This provided a balance between the level of accuracy desired and numerical tolerance stability for expected high velocities, exceeding 20 feet per second (fps). The dam break analysis used a mixed-flow regime along with the Diffusive Wave equation. These options are can be used for rapidly varied flows such as flow transitions from subcritical to supercritical flow and hydraulic jumps.

4.3 HEC-RAS 2D Modeling Limitations

HEC-RAS can perform 2D modeling with known limitations. The following is a list of items HEC is working on to improve the software, and will be available in future versions:

1. More flexibility for adding internal hydraulic structures inside of a 2D flow area.
2. Cannot perform sediment transport erosion/deposition in the 2D flow areas.
3. Cannot perform water quality modeling in 2D flow areas.
4. Cannot connect pump stations to 2D flow area cells
5. Cannot use the HEC-RAS bridge modeling capabilities inside of a 2D flow area, but can be added as culverts, weir, and breaching by using the *SA/2D Area Conn* tool.

This page left blank intentionally.

5. Dam Breach Failure Analysis

5.1 Dam Breach Parameters

Breach parameters for Terminal Dam were developed based on published guidance documents, the foundation profile, and dam composition. Breach parameters were not selected to achieve a predetermined breach hydrograph but to provide basis of potential breach hydrographs due to different conditions that could cause a dam failure. A fair weather (sunny day) non-hydrologic dam breach sensitivity analysis was performed for the earthen fill dam. The sunny day failure mode was selected to evaluate the dam breach and are based on the FEMA P-946 guidelines. The selection of parameters of the dam failure were based on best available data collected during this study and may not reflect real time conditions (e.g., weather conditions, vegetation and land cover, location of potential dam failure, reservoir conditions, etc.). For this case study, the parameters are kept consistent to test the dam breach peak, the release of volume, and attenuation. The sunny day dam failure is analyzed by establishing an initial reservoir water level and commencing a breach analysis with minimal inflow into the reservoir.

The Federal Energy Regulatory Commission (FERC) engineering guidelines recommends an average breach width of 1 to 5 times the height of the dam for earthen fill embankments. FERC guidelines for side slopes for engineered earthen structure is 0H: 1V to 1H: 1V and the time to failure is equal to 0.1 to 1 hour. **Table 7** is a summary of the possible estimates for breach characteristics for the various types of dam composition.

The dam breach was not evaluated with the National Weather Service BREACH Model due to lack of information to perform a breach analysis. The NWS BREACH model is a mathematical model used to simulate piping and/or over topping failure of earthen dams, either man-made or naturally formed by a landslide. To perform the dam breach analysis required the soil composites, and the geometric and material properties of the dam which are not currently available.

Referencing the dam breach characteristics set by FERC, the base case scenario for Terminal Dam breach was modeled as a sunny day, full reservoir, linear piping failure initiating at El. 315 ft, with a final bottom breach width of 100 feet, a side slopes of 0.5H: 1V, and a breach formation time of 0.5 hours. The breach geometry resulted in an average breach width of 121.9 ft. The bottom elevation of the breach was set at El. 288 feet. The failure was initiated with the lake pool at El. 331.8 feet. The breach parameters used for the modeling efforts are summarized in **Table 8**.

5.2 Dam Breach Sensitivity Analysis

In addition to the selection of the dam breach parameters for the base case, three sensitivity scenarios of parameter changes were analyzed by increasing and decreasing the breach width, time to failure, and side slope of the failure of the dam (Case 1, 2, and 3). The

sensitivity analysis was performed to test the sensitivity of the sunny day base case modeling scenarios with different dam breach parameters.

The minimum and maximum breach parameters were selected based on engineering judgement. The minimum and maximum times to fail the earthen fill dam breach varied from 0.2 to 1 hour. The side slopes were varied from 0.2H: 1V to 1H: 1V and the minimum and maximum bottom breach widths were selected as 40 feet and 150 feet. This resulted in average breach widths varying from a minimum of 48.8 feet to a maximum of 193.8 feet.

The three failure cases are summarized below:

- Case 1 (maximum breach width, short time to failure, and maximum side slopes): Terminal Dam average breach width of 193.8 feet, 0.2 hour to time to failure, and side slopes of 1H: 1V.
- Case 2 (minimum breach width, long time to failure, and minimum side slopes): Terminal Dam average breach width of 48.8 feet, 1 hour to time to failure, and side slopes of 0.2H: 1V.
- Case 3 (medium breach width, medium time to failure, and medium side slopes): Terminal Dam average breach width of 96.3 feet, 0.6 hour to time to failure, and side slopes of 0.6H: 1V.

In addition to the sensitivity analyses recommended in the FERC Engineering Guidelines, analyses were performed to evaluate the model results with breach parameters developed from Froehlich (2008), Von Thun & Gillette (1990), and Xu & Zhang (2009) methods. The regression equations developed by Froehlich, Von Thun & Gillette, and Xu & Zhang have been used for several dam safety studies found in literature and are presented in greater detail in the *HEC-RAS for Dam Break Study, August 2014*.

Following the recommendations from the dam break study, the three additional failure cases are summarized below:

- Case 4 (Froehlich method, 2008): Terminal Dam average breach width of 78.7 feet, 0.38 hour to time to failure, and side slopes of 0.7H: 1V.
- Case 5 (Von Thun & Gillette method, 1990): Terminal Dam average breach width of 126.9 feet, 0.52 hour to time to failure, and side slopes of 0.5H: 1V.
- Case 6 (Xu & Zhang, 2009): Terminal Dam average breach width of 79.3 feet, 0.82 hour to time to failure, and side slopes of 0.76H: 1V.

The breach parameters used for each sensitivity analysis are shown on **Table 9**. The sensitivity analysis results for Terminal Dam and selected locations downstream are discussed in the Results Section.

6. Results

The results indicate that a hypothetical failure of the Terminal Dam for the sunny day conditions would potentially cause adverse consequences such as loss of life, property damage, and economic, social, and environmental impacts. There may also be potential impacts upstream of the dam due to backwater flooding or landslides around the reservoir.

Sections 6.1 and 6.2 summarize the results of the hypothetical sunny day failure and the floodplain inundation. **Table 11** provides a summary of the model results at selected cross sections. The tabulated results include the flood wave arrival time, time to peak, peak water surface elevation (WSEL), peak flow, peak velocity, and maximum depth.

The “initial wave arrival time” is the elapsed time from breach initiation to a 1 ft increase in WSEL at a cross section. The “time to peak” is the elapsed time from breach initiation to peak WSEL at a cross section. The “deflood time” is the time elapsed from the flood wave arrival time until water recedes to within 1 ft of its pre-flood water elevation at a cross section. The “peak inundation depth” is the maximum water depth at a station resulted across the cross section. The “peak velocity” is the maximum velocity at a station resulted across the cross section. The “peak discharge” is an estimate of the maximum flow rate integrated over the entire cross section. The “peak water elevation” is the maximum water surface elevation reached at a station resulted across the cross section.

The inundation maps for the hypothetical sunny day failure base case are provided in **Appendix C**.

6.1 Dam Sunny-Day Failure Results

The hypothetical dam failure resulted in hydrographs that was used for the hydraulic inundation model analysis. The analysis for the dam breach, base case scenario indicates that a sunny day hypothetical failure of Terminal Dam would produce a peak discharge of 25,391 cfs at the dam approximately 21 minutes after the breach initiates. The breach would drain the reservoir in approximately 5 hours and 4 minutes. The dam breach hydrograph is shown on **Figure 6**. Comparing the base case scenario to the sensitivity analysis of Case 1 to Case 6 (as shown on **Table 10**), the base case scenario was within the median of maximum flows from all seven scenarios. The maximum peak flow occurred on scenario Case 1 with a discharge of 51,125 cfs. This maximum flow can be attributed to the fastest time to failure of 0.2 hour and the widest breach opening that resulted with a fast and intense release of water from the dam breach. The lowest peak flow occurred on scenario Case 2 with a discharge of 13,339 cfs which can be attributed to the long time to failure of one hour with a small breach width opening compared to the seven scenario cases.

6.2 Floodplain Inundation Results

The base case of the hypothetical Terminal Dam sunny day failure results at specific

locations are presented in **Table 11**. The tabular table includes the time to peak, maximum water surface elevation, maximum flow, and deflood time. The flood inundation extents and details are provided in **Appendix C**. The results for the sunny day failure assume the flood wave is not diverted into the city stormwater drainage system, no loss of water due to soil infiltration, no pumps are active, and no buildings in place to obstruct, divert, or store the flood wave.

The model results of the sunny day hypothetical failure of the Terminal Dam produced a peak discharge of 25,391 cfs at the dam approximately 23 minutes after the breach initiates. The breach would drain the reservoir in approximately 5 hours and 4 minutes. As the peak flood wave is routed downstream of the dam, the flood wave is dispersed and attenuated through the meandering Arroyo Grande Creek and water flowing out of the channel into the overbanks. The flood wave will travel 8.9 miles downstream reaching the Pacific Ocean at approximately 2 hours and 55 minutes. **Figure 7** shows the flood wave attenuation at specific cross sections detailed below (**Appendix C** shows the cross sections location). The maximum depth of the flood wave would reach 33 ft in the Arroyo Grande Creek and inundate the overbanks with depths up to 5 ft. Approximately 105 acres of the City of Arroyo Grande is inundated within the areas along the Arroyo Grande Creek. Southern communities of Oceano would be inundated at the south bend of Arroyo Grande Creek downstream of Cabrillo Highway. Within the town of Oceano limits, one healthcare facility is impacted by the flood wave. **Table 12** details the impacted facility.

Cross Section #1, located about 0.2 miles downstream of the reservoir and water treatment plant, the flood wave would arrive about 6 minutes after the breach initiates. About 23 minutes after the breach, the peak water surface elevation would be at El. 285 ft resulting in an incremental maximum rise of 18.3 ft. The flow would be approximately 24,941 cfs and 12.6 fps.

Cross Section #2, the flood wave would arrive at Cecchetti Road located 1.6 miles downstream of Terminal Dam at approximately 20 minutes after the breach initiates. The peak water surface elevation could potentially reach the bridge deck at flows of 23,473 cfs with a maximum depth of 15.5 ft in Arroyo Grande Creek and average depths of 4 ft in the overbanks.

Cross Section #3, 2.5 miles downstream at Huasna Road crossing over Arroyo Grande Creek reaches flows of 15,177 cfs. The flood wave would arrive about 33 minutes after the breach and result in a maximum inundation depth of 33.1 ft in Arroyo Grande Creek in 50 minutes.

Cross Section #4, located about 2.9 miles downstream and south of the Tar Spring Creek, the flood wave would arrive about 42 minutes after the breach initiates. About 1 hour after the breach, the peak inundation depths would reach 18.7 ft. The flood wave would reach peak flows of 13,299 cfs and peak velocities of 5.6 fps. It would take 3 hours and 37 minutes for the water to recede below 1 ft.

Cross Section #5, the flood wave would reach 3.4 miles downstream of the dam at approximately 58 minutes after the breach initiates. The peak water surface elevation would

reach El. 139 ft at flows of 10,644 cfs with a maximum depth of 23.7 ft in Arroyo Grande Creek. The peak flood wave would peak at 1 hour and 16 minutes.

Cross Section #6, 4.8 miles downstream at Traffic Way crossing over Arroyo Grande Creek reaches flows of 9,246 cfs with velocities of 6.0 fps. The flood wave would arrive at 1 hour and 12 minutes after the breach and results in an incremental rise of 23.0 ft at 1 hour and 37 minutes in Arroyo Grande Creek. The maximum depth would overflow the channel and inundate low-laying areas of the overbank.

Cross Section #7, located approximately 6.1 miles downstream of the dam at US Highway 101, the flood wave would arrive at 1 hour and 20 minutes after the breach initiates. About 19 minutes thereafter the peak water surface elevation would reach El. 96 ft resulting in an incremental rise of 19.6 ft in the channel. The peak flow would be at 9,067 cfs. Within the cross-sectional extents, the flood wave would recede below 1 ft at 9 hours and 43 minutes.

Cross Section #8, the flood wave would arrive at Fair Oaks Avenue located 6.8 miles downstream of the dam at approximately 1 hour and 32 minutes after the breach initiates. The peak flows would reach 8,358 cfs with a maximum depth of 20.6 ft in the channel. Peak velocities would reach 6.3 fps.

Cross Section #9, 7.7 miles downstream at Cabrillo Highway (Highway 1) reaches flows of 7,178 cfs. The flood wave would arrive at 1 hour and 55 minutes after the breach and results in an incremental rise to 11.4 ft at 2 hours and 21 minutes in the channel and average depths of 3 ft in the overbanks.

Cross Section #10, located approximately 8.7 miles downstream of the dam at the railway crossing Arroyo Grande Creek, the flood wave would arrive at 2 hours and 20 minutes after the breach initiates. About 2 hours and 57 minutes the flood wave would reach the peak water surface elevation of El. 31 ft, resulting in a maximum inundation depth of 8.0 ft in the channel. The peak flow would be at 3,219 cfs with velocities of 3.5 fps. Within the cross-sectional extents, the flood wave would recede below 1 ft at 13 hours and 30 minutes.

Cross Section #11, the extents of the flood wave would reach the outlet of Arroyo Grande Creek into the coastal shores, at approximately 2 hours and 55 minutes. At 8.9 miles downstream, the peak flood wave would take 3 hours and 48 minutes to reach peak flows before being attenuated through the channel and overbanks. Peak flows would reach 1,119 cfs. The incremental rise would reach a maximum depth would reach 6.2 ft in the channel with maximum velocities of 2.1 fps.

This page left blank intentionally.

7. Limitation of Liability

Our professional services for preparing the Terminal Dam Inundation Technical Study were performed in accordance with generally accepted engineering practices; no other warranty, expressed or implied, is made. This report presents the results of a hypothetical failure of the Terminal Dam and the subsequent downstream flooding. The hypothetical failure of the Terminal Dam and the subsequent flood wave routing results are based on our best judgment and the suggested breach parameters and hydraulic modeling techniques as recommended in the Federal Emergency Management Agency (FEMA) Federal Guidelines for Inundation Mapping of Flood Risks Associated with Dam Incidents and Failures, First Edition, July 2013 (FEMA P-946). The results of this analysis should only be used to estimate potential downstream impacts based on the assumed breach conditions. If any portion of the Terminal Dam were to fail, actual breach conditions, peak flows, and peak water surface elevation may vary from those presented in this report.

The hypothetical failure, and assumed breach conditions, do not indicate or represent the actual integrity, condition, or safety of Terminal Dam. Reuse of this report for any other purposes, in part or in whole, is at the sole risk of the user.

This page left blank intentionally.

8. References

- California Department of Transportation Division of Maintenance (2016). Structure Maintenance and Investigations. Bridge Inspection Records Information System (BIRIS). Bridge Number: 49 0175R. Facility Carried: US Highway 101 NB. Bridge Inspection Reports.
- California Department of Transportation Division of Maintenance (2016). Structure Maintenance and Investigations. Bridge Inspection Records Information System (BIRIS). Bridge Number: 49 0175L. Facility Carried: US Highway 101 SB. Bridge Inspection Reports.
- Federal Emergency Management Agency (FEMA) (2017). Flood Insurance Study, San Luis Obispo County, California and Incorporated Areas. FIS 06079CV001C.
- Federal Emergency Management Agency (FEMA) (2013). FEMA 64, Federal Guidelines for Dam Safety: Emergency Action Planning for Dams.
- Federal Emergency Management Agency (FEMA) (2013). FEMA 94, Selecting and Accommodating Inflow Design Floods for Dams.
- Federal Emergency Management Agency (FEMA) (2013). FEMA 148, Federal Guidelines for Dam Safety: Glossary of Terms.
- Federal Emergency Management Agency (FEMA) (2013). FEMA 333, Federal Guidelines for Dam Safety: Hazard Potential Classification System for Dams.
- Federal Emergency Management Agency (FEMA) (2013). FEMA 946, Federal Guidelines for Inundation Mapping of Flood Risks Associated with Dam Incidents and Failures.
- Froehlich, D.C. (1995). Embankment Dam Breach Parameters Revisited. *Water Resources Engineering*, 887-891.
- MacDonald, T. C., and Langridge-Monopolis, J. (1984). *Breaching characteristics of dam failures*. *Journal of Hydraulic Engineering*, 110:5, 567–586.
- San Luis Obispo County Flood Control and Water Conservation District (1970). Lopez Water Supply Project, Terminal Dam and Reservoir. Volume II Specification No. 0803-68-3. DSOD Record Copy 1055-2.
- San Luis Obispo County Flood Control and Water Conservation District (1967). Spillway Hydraulic Calculations for Terminal Dam and Reservoir, Lopez Water Supply Project, San Luis Obispo County, California. DSOD Record Copy 1055-2.

San Luis Obispo County Flood Control and Water Conservation District (1967). Spillway Hydraulic Calculations for Terminal Dam and Reservoir, Lopez Water Supply Project, San Luis Obispo County, California. DSOD Record Copy 1055-2.

San Luis Obispo County Flood Control and Water Conservation District – Zone 3 (2012). Lopez Lake and Terminal Reservoir Watershed Sanitary Survey Update – 2010.

San Luis Obispo County Public Works Department (2005). Water Years 2001-02 and 2002-03 Hydrologic Report.

US Army Corps of Engineers (USACE) (2012). HEC-GeoRAS GIS Tools for Support of HEC-RAS using ArcGIS User's Manual, Version 10.1, Davis, CA.

US Army Corps of Engineers (USACE) (2014). Using HEC-RAS for Dam Break Studies, Davis, CA.

US Army Corps of Engineers (USACE) (2016). HEC-RAS, River Analysis System, 2D Modeling User's Manual, Version 5.0, Davis, CA.

US Army Corps of Engineers (USACE) (2016). HEC-RAS, River Analysis System, Hydraulic Reference Manual, Version 5.0, Davis, CA.

US Geological Survey (USGS), 2013. USGS NED n36w121 1/3 arc-second 2013 1 x 1 degree ArcGRID. <http://ned.usgs.gov/>

Watershed Sciences, Inc. (2011). LiDAR Remote Sensing Data Collection: Los Osos, CA.

Watershed Sciences, Inc. (2013). Technical Data Report Diablo Canyon Power Plant (DCCP), San Simeon LiDAR & Orthoimagery Survey.

Table 1. Terminal Dam Statistics Summary (Source: DSOD)

Description	Value
Elevation of dam crest (feet)	337.8
Elevation of spillway crest (feet)	331.8
Upstream slope	2H: 1V
Downstream slope	2H: 1V
Elevation of upstream toe (feet)	287.8
Elevation of streambed (downstream toe) (feet)	277.8
Storage capacity at dam crest (estimated, acre-feet)	1,100
Storage capacity at spillway elevation (estimated, acre-feet)	844
Dam height (feet)	53
Dam crest length (feet)	550
Dam crest width (feet)	24
Total Freeboard (feet)	6

1. Elevation datum NAVD 88

Table 2. Hydraulic Structures Downstream of Terminal Dam

Structures	Distance Downstream of Dam
Cecchetti Road crossing over Arroyo Grande Creek	1.6 miles
Huasna Road crossing over Arroyo Grande Creek	2.5 miles
Mason Street crossing over Arroyo Grande Creek	4.5 miles
Bridge Street crossing over Arroyo Grande Creek	4.7 miles
Traffic Way crossing over Arroyo Grande Creek	4.8 miles
US Highway 101 crossing over Arroyo Grande Creek	6.1 miles
Fair Oaks Avenue crossing over Arroyo Grande Creek	6.8 miles
Cabrillo Highway (Hwy 1) crossing over Arroyo Grande Creek	7.7 miles
2 nd Street crossing over Arroyo Grande Creek	8.6 miles
Railroad bridge crossing over Arroyo Grande Creek	8.7 miles

Table 3. Field Measurement of Bridges (December 2017)

Structures	Deck Width (ft)	Deck Length (ft)	Abutment Length (ft)	# Piers
Grieb Ranch Way	24	130		24
Talley Farms Road	24	94		
Huasna Road	22	87	43	
Mason Street	28	169	22	
Bridge Street	36	141		
Traffic Way	45	225		
Fair Oaks Avenue	76	130		5 groups

Table 4. 2D Flow Area Gridded Model Sensitivity Comparison

Results	50 ft Grids	100 ft Grids	200 ft Grids
Area of Inundation Extents (acre)	3,439	3,537	2,394
Model Simulation Time (hh:mm:ss)	1:28:28	0:42:37	0:06:36
Maximum Depth (feet)	58.1	51.1	38.2
Model Cells (No.)	269,980	67,360	16,791

Table 5. NLCD Land Cover and Assigned Manning's N-Value

USGS ID	Description	Manning's N-Value
11	Open Water	0.03
12	Perennial Ice/Snow	0.03
21	Developed, Open Space	0.08
22	Developed, Low Intensity	0.1
23	Developed, Medium Intensity	0.15
24	Developed, High Intensity	0.2
31	Barren Land (Rock/Sand/Clay)	0.04
41	Deciduous Forest	0.1
42	Evergreen Forest	0.1
43	Mixed Forest	0.1
52	Shrub/Scrub	0.07
71	Grassland/Herbaceous	0.035
81	Pasture/Hay	0.04
82	Cultivated Crops	0.035
90	Woody Wetlands	0.05
95	Emergent Herbaceous Wetlands	0.08

Table 6. Assigned Manning's N-Value Model Sensitivity Results Comparison

Location #	Location / Description	D/S of Dam (mi)	Base Case Depth (ft)	+10% Case Depth (ft)	-10% Case Depth (ft)
1	Huasna Road Bridge		42.72	42.43	43.02
2	Intersection Allen St & Garden St		6.68	5.9	7.43
3	Intersection Leanna Dr. & Pearl Dr.		5.16	4.52	5.73
4	Cabrillo Hwy Bridge		0.89	0.9	1.08
5	South of Oceano County Airport		1.74	1.77	1.71
6	Intersection 22 nd St & Produce Pl		0.37	0.24	0.54

Table 7. Ranges of Possible Values for Breach Characteristics (Source: *HEC-RAS Dam Break Study, August 2014*)

Dam Type	Average Breach Width (B_{ave})	Horizontal Component of Breach Side Slope (H) (H:V)	Failure Time, t_f (hours)	Agency
Earthen/Rockfill	(0.5 to 3.0) x HD	0 to 1.0	0.5 to 4.0	USACE 1980
	(1.0 to 5.0) x HD	0 to 1.0	0.1 to 1.0	FERC
	(2.0 to 5.0) x HD	0 to 1.0 (slightly larger)	0.1 to 1.0	NWS
	(0.5 to 5.0) x HD*	0 to 1.0	0.1 to 4.0*	USACE 2007
Concrete Gravity	Multiple Monoliths	Vertical	0.1 to 0.5	USACE 1980
	Usually $\leq 0.5 L$	Vertical	0.1 to 0.3	FERC
	Usually $\leq 0.5 L$	Vertical	0.1 to 0.2	NWS
	Multiple Monoliths	Vertical	0.1 to 0.5	USACE 2007
Concrete Arch	Entire Dam	Valley wall slope	≤ 0.1	USACE 1980
	Entire Dam	0 to valley walls	≤ 0.1	FERC
	(0.8 x L) to L	0 to valley walls	≤ 0.1	NWS
	(0.8 x L) to L	0 to valley walls	≤ 0.1	USACE 2007
Slag/Refuse	(0.8 x L) to L	1.0 to 2.0	0.1 to 0.3	FERC
	(0.8 x L) to L		≤ 0.1	NWS

*Note: Dams that have very large volumes of water, and have long dam crest lengths, will continue to erode for long durations (i.e., as long as a significant amount of water is flowing through the breach), and may therefore have longer breach widths and times than what is shown in Table 3. HD = height of the dam; L = length of the dam crest; FERC - Federal Energy Regulatory Commission; NWS - National Weather Service

Table 8. Sunny-Day Breach Parameters (Base Case)

Parameter	Value
Failure Scenario	Sunny Day
Failure Mode	Piping
Failure Progression	Linear
Initial Water Surface Elevation (feet)	331.8
Initial Storage (acre-feet)	844
Bottom Breach Elevation (feet)	288
Breach Height (feet)	43.8
Bottom Breach Width (feet)	100
Side Slopes ($H:1V$)	0.5
Average Breach Width (feet)	121.9'
Time to Full Formation (hours)	0.5

Table 9. Terminal Dam Breach Sensitivity Analysis Parameters

Parameters	Base Case	Case 1	Case 2	Case 3	Case 4 Froehlich (2008)	Case 5 Von Thun & Gillete	Case 6 Xu & Zhang
Dam Crest Length, feet	550	550	550	550	550	550	550
Dam Crest Elevation, feet	337.8	337.8	337.8	337.8	337.8	337.8	337.8
Min Foundation Elevation, feet	288.0	288.0	288.0	288.0	288.0	288.0	288.0
Max Height of Dam, feet	53	53	53	53	53	53	53
Dam Breach Height, feet	43.8	43.8	43.8	43.8	43.8	43.8	43.8
Side Slopes, _H:1V	0.5	1	0.2	0.6	0.7	0.5	0.76
Top Breach Width, feet	143.8	237.7	57.5	122.6	109.4	148.8	112.6
Average Breach Width, feet	121.9	193.8	48.8	96.3	78.7	126.9	79.3
Bottom Breach Width, feet	100	150	40	70	48	105	46
Bottom Breach Elevation, feet	288.0	288.0	288.0	288.0	288.0	288.0	288.0
Maximum Reservoir Elevation, feet	337.8	337.8	337.8	337.8	337.8	337.8	337.8
Reservoir Elevation at Breach Initiation, feet	331.8	331.8	331.8	331.8	331.8	331.8	331.8
Time of Failure, hours	0.5	0.2	1	0.6	0.38	0.52	0.82

Table 10. Terminal Dam Breach Sensitivity Hydrograph Comparison

Scenario #	Peak Discharge (cfs)	Time to Peak from Initial Breach (min)	Time for Reservoir to Drain (min)
Base Case	25,391	21	221
Case 1	51,125	9	161
Case 2	13,339	49	423
Case 3	21,242	29	283
Case 4	29,331	23	349
Case 5	25,061	21	217
Case 6	17,243	45	377


Table 11. Terminal Dam Inundation Cross Sectional Results

Cross Section	Distance from Dam (mi)	Station	Initial Wave Arrival Time, 1 Foot (hh:mm)	Time to Peak (hh:mm)	Deflood Time, 1 Foot (hh:mm)	Peak Inundation Depth ¹ (ft)	Peak Velocity (fps)	Peak Discharge (cfs)	Peak Water Surface Elevation (ft)	Location Description
N/A	N/A	N/A	N/A	N/A	N/A	N/A	N/A	25,391	N/A	At Terminal Dam
1	0.2	10+49	0:06	0:23	0:49	18.3	12.6	24,941	285	Downstream of Terminal Reservoir
2	1.6	83+22	0:20	0:34	1:47	15.5	8.8	23,473	228	Cecchetti Road
3	2.5	131+49	0:33	0:50	2:19	33.1	10.7	15,177	200	Upstream of Huasna Road
4	2.9	153+20	0:42	1:00	3:37	18.7	5.6	13,299	155	Downstream of Tar Spring Creek
5	3.4	179+82	0:58	1:16	6:35	23.7	11.2	10,644	139	
6	4.8	255+54	1:12	1:37	7:14	23.0	6.0	9,279	102	Traffic Way
7	6.1	320+24	1:20	1:39	9:43	19.6	4.9	9,067	96	US 101 Highway
8	6.8	359+57	1:32	1:52	12:30	20.6	6.3	8,358	80	Fair Oaks Avenue
9	7.7	406+81	1:55	2:21	13:06	11.4	4.5	7,178	53	Cabrillo Highway (Hwy 1)
10	8.7	460+77	2:20	2:57	13:30	8.0	3.5	3,219	31	Railroad Bridge downstream of 22nd Street
11	8.9	467+83	2:55	3:48	15:54	6.2	2.1	1,119	14	Outlet of Arroyo Grande Creek into Ocean

1. Peak Inundation Depth is not representative of the flooding depth along the entire cross section but the water surface elevation to the lowest ground of the cross section.

Table 12. Terminal Dam Sunny Day Failure Impact Facilities

Facility #	Facility	Name	Max. Inundation Depth (ft)
1	Healthcare	Community Health Centers, Oceano	3.3

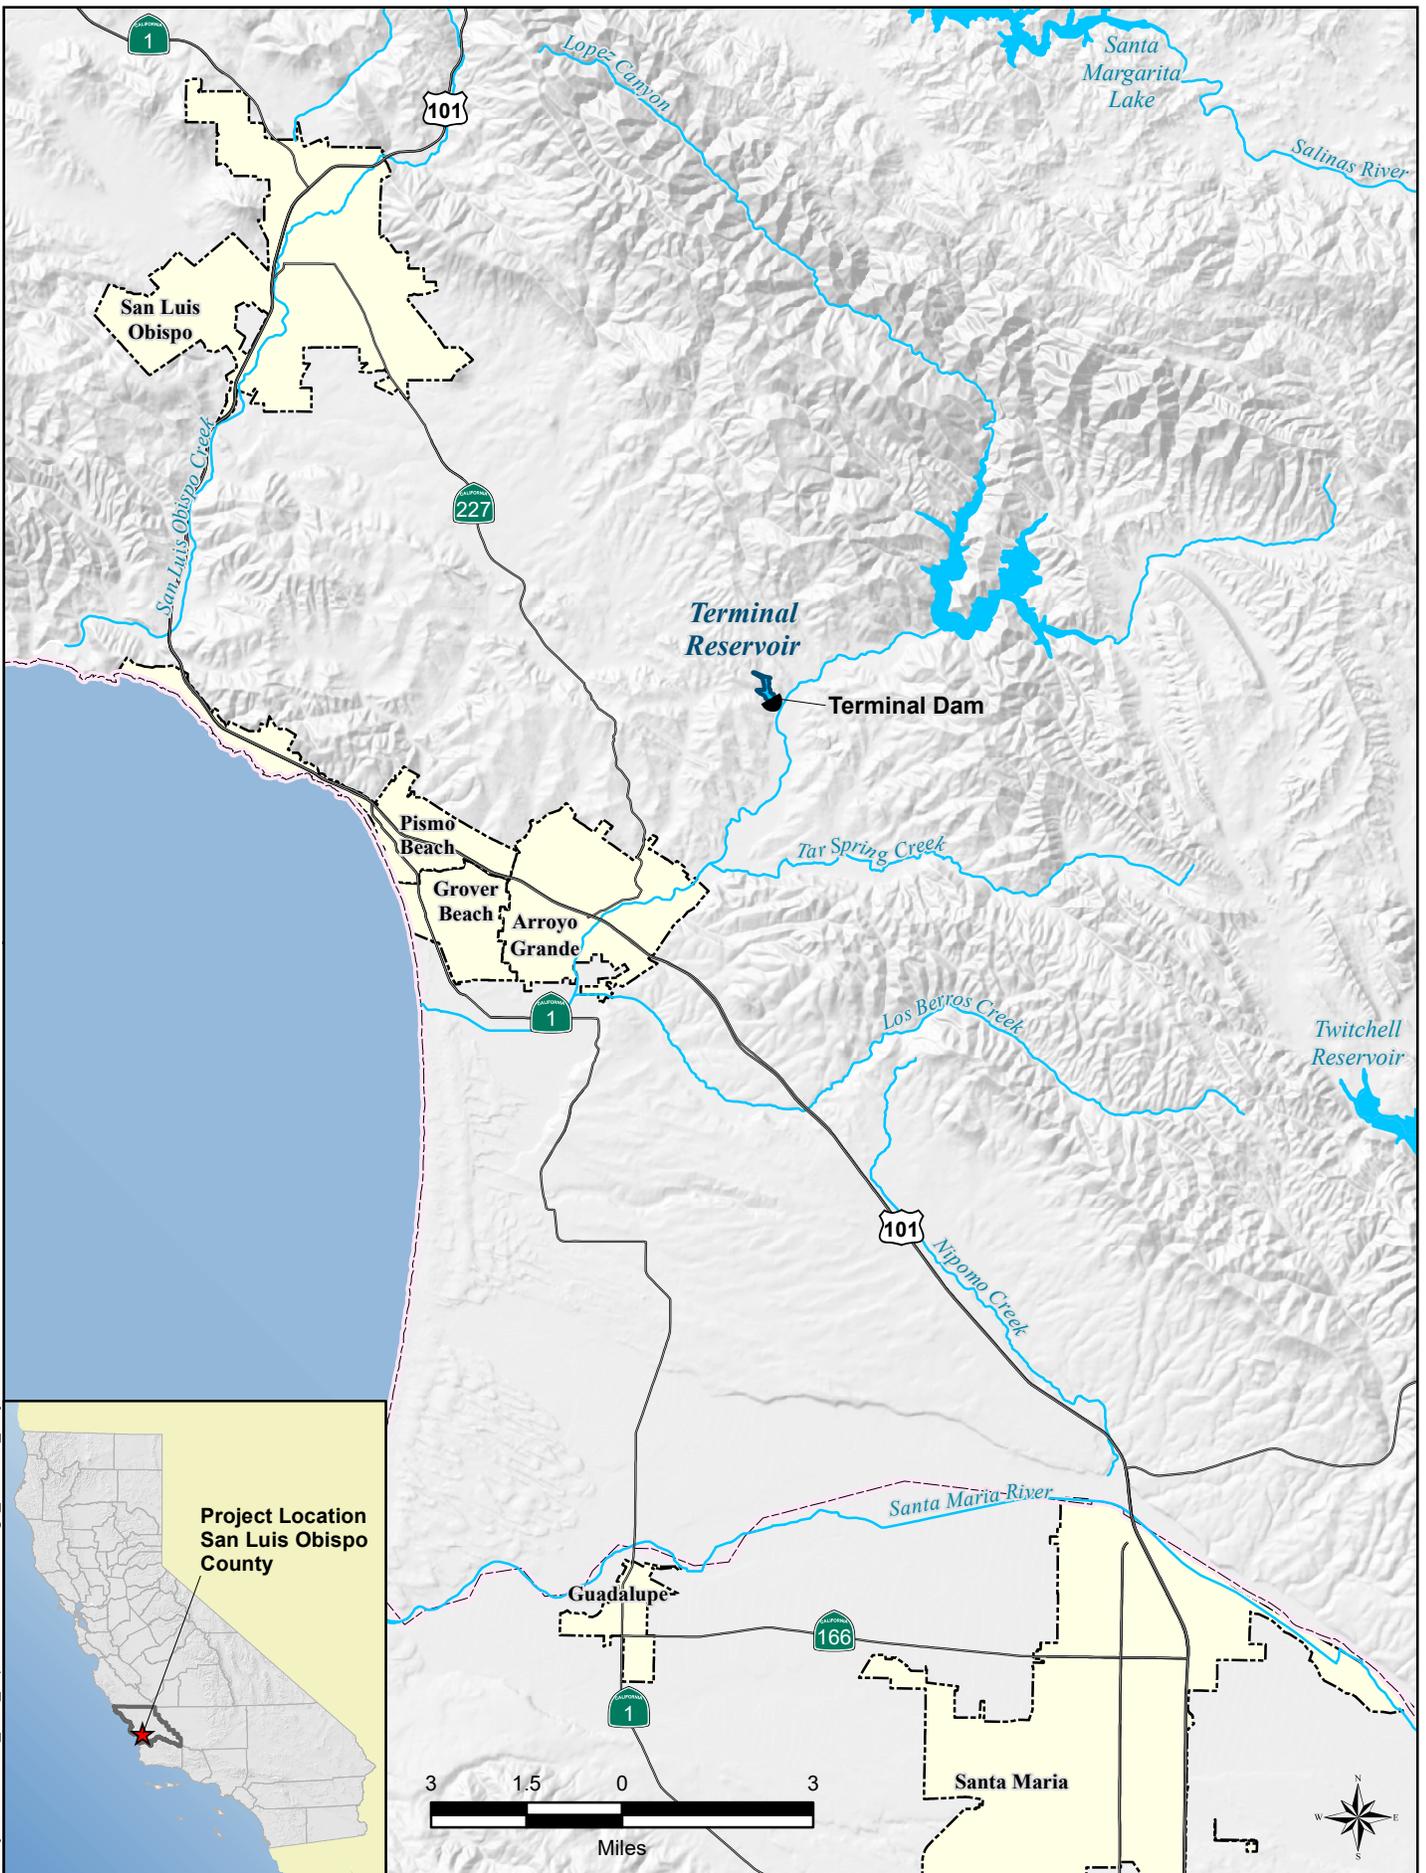

26Dec2017 Z:\Projects\1705077_SLO_Lopez\TerminalDams\Fig1_Terminal_ProjectLocation.mxd RS

Terminal Dam Inundation Technical Study
San Luis Obispo County, California

San Luis Obispo County Flood Control
and Water Conservation District



DECEMBER 2017

Project Location

FIGURE 1



26Dec2017 Z:\Projects\1705077_SLO_Lopez\TerminalDams\Fig2_Terminal_DamSpillway.mxd RS

Terminal Dam Inundation Technical Study
San Luis Obispo County, California


San Luis Obispo County Flood Control
and Water Conservation District



Terminal Dam and Spillway

DECEMBER 2017

FIGURE 2

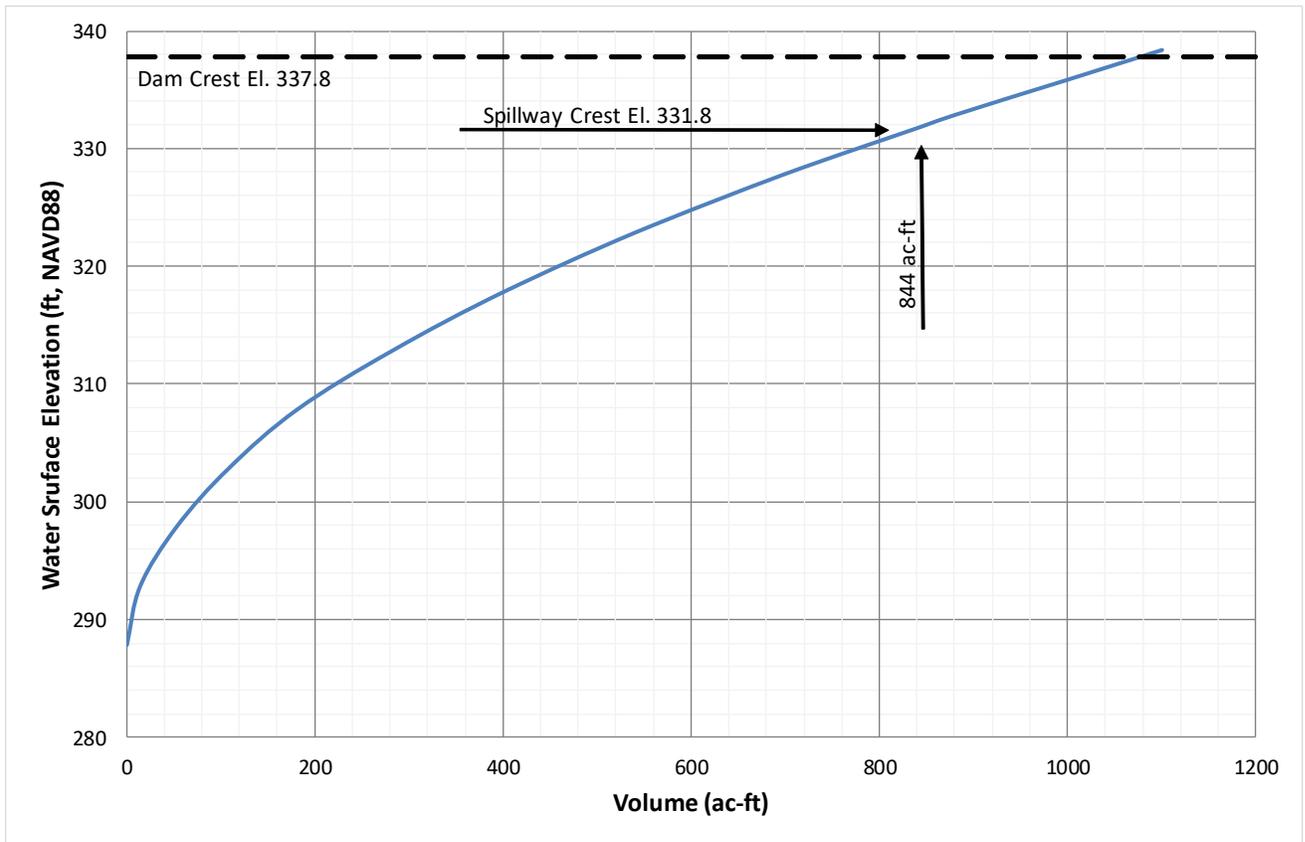


Notes:

1. Elevation-storage capacity curve reference from the as-built plans, Lopez Water Supply Project, Terminal Dam & Reservoir, Terminal Dam Topography As Constructed, Sheet 23B, October 6, 1970. (DSOD record copy 1055-2),
2. During normal operating level, Elevation 330.8, total storage is 808 ac-ft with 36.4 acres of water surface, of which 28 ac-ft and 3.3 acres are northerly of Biddle Ranch Road and 92 ac-ft and 4.4 acres are within the major finger northwesterly of the dam, resulting in an effective storage of 688 ac-ft with 28.7 acres of water surface.

<u>Elevation (ft)</u>	<u>Volume (ac-ft)</u>
287.8	0
292.8	14
297.8	52.4
302.8	108
307.8	181
312.8	282
317.8	401
322.8	540
327.8	700
331.8	844
332.8	880
335.8	1000
338.3	1100

Z:\Projects\1705077_SLO_LopezTerminalDams\TerminalReport_Figures3.mxd CV

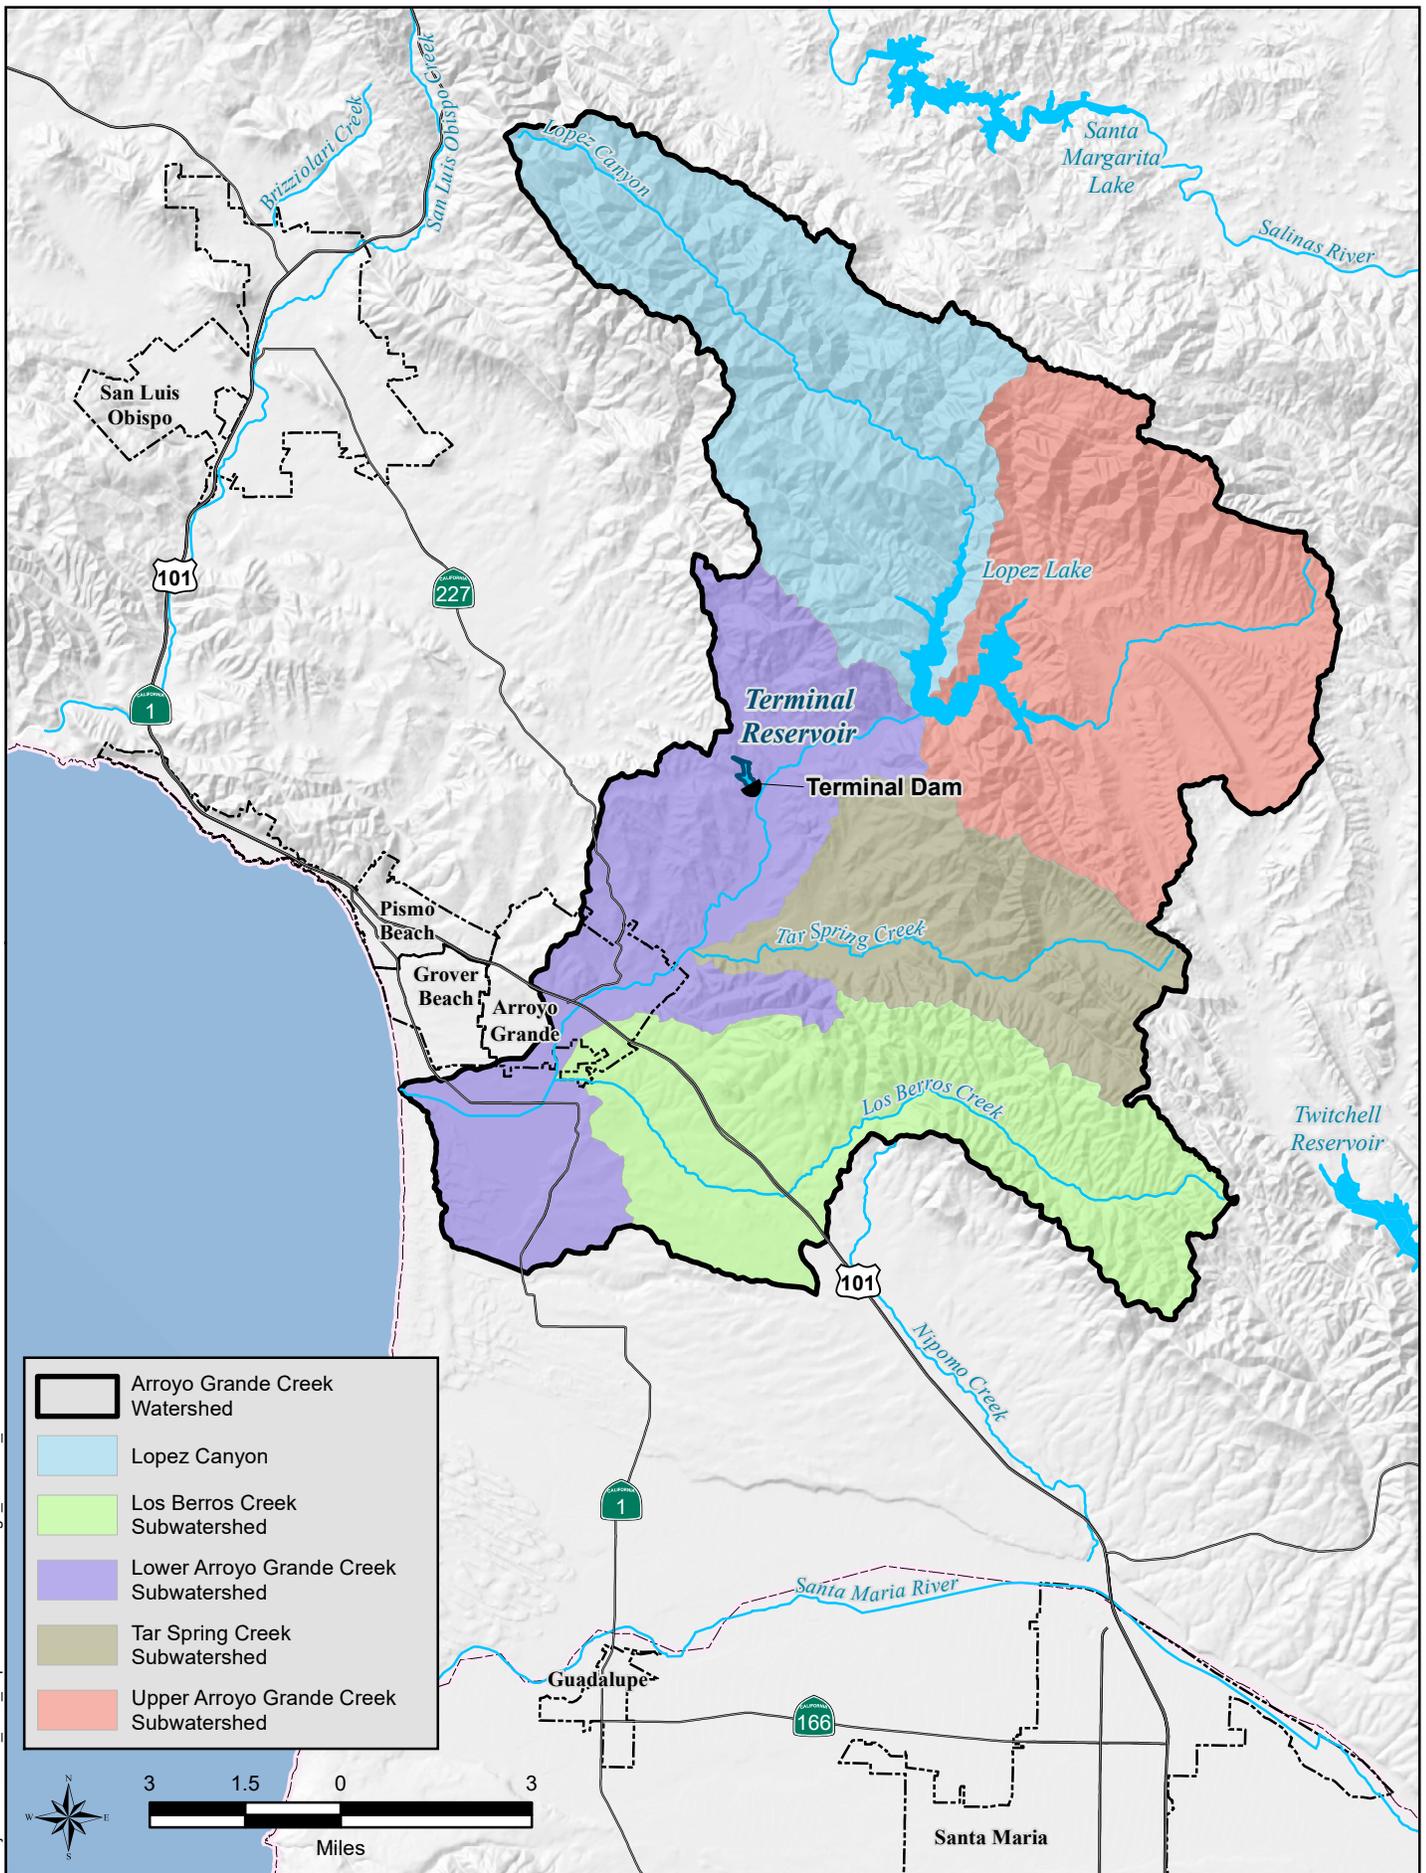

26Dec2017 Z:\Projects\1705077_SLO_LopezTerminalDams\Fig4_Terminal_Watersheds.mxd RS

Terminal Dam Inundation Technical Study
 San Luis Obispo County, California


San Luis Obispo County Flood Control
 and Water Conservation District



DECEMBER 2017

Drainage Watersheds

FIGURE 4

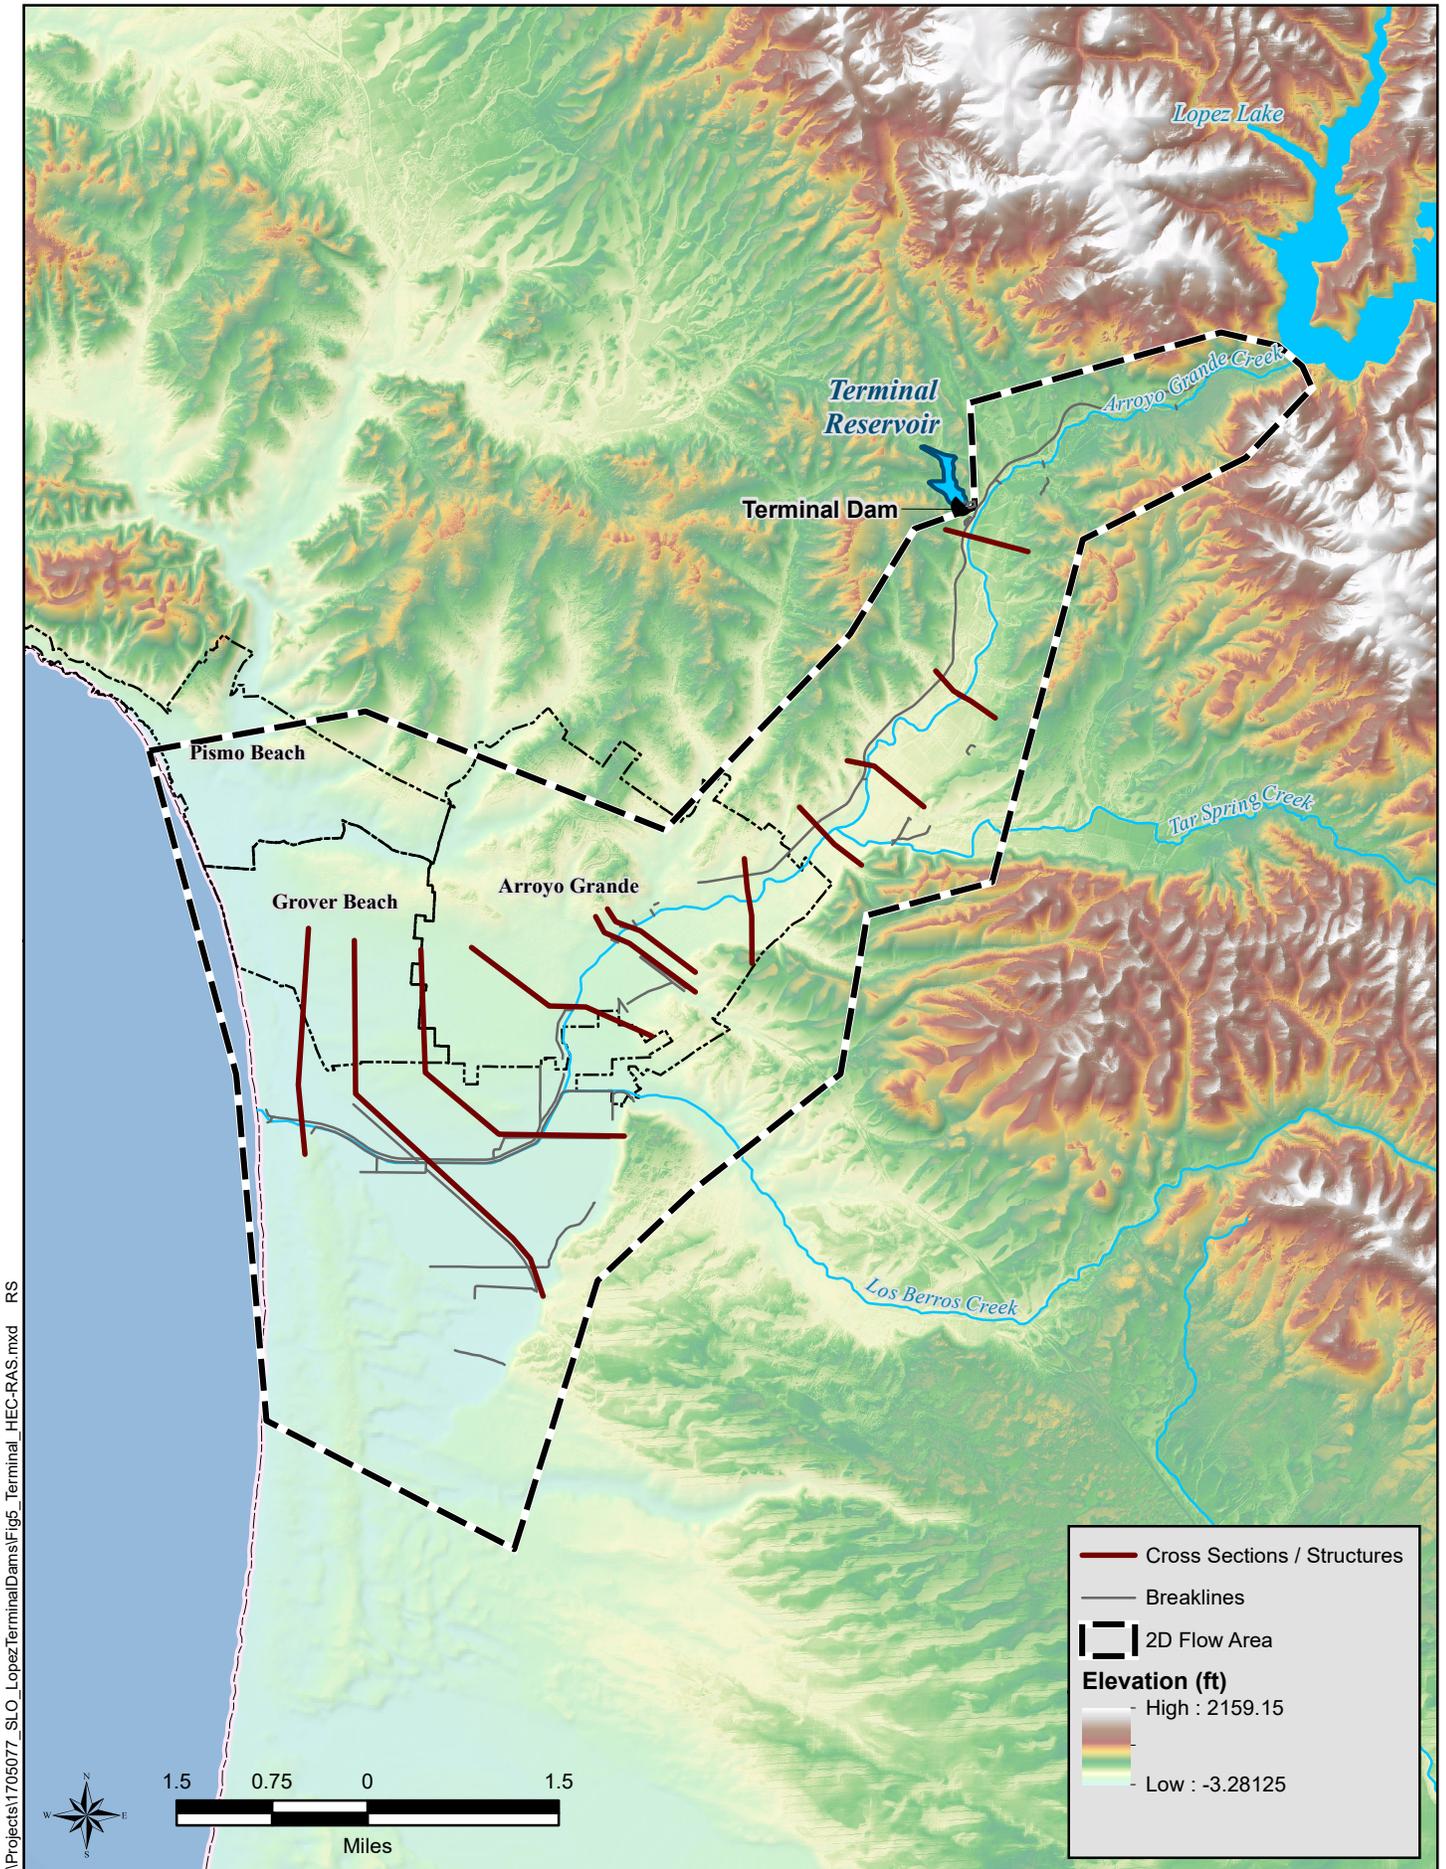

26Dec2017 Z:\Projects\1705077_SLO_Lopez\TerminalDams\Figs_Terminal_HEC-RAS.mxd RS

Terminal Dam Inundation Technical Study
San Luis Obispo County, California


San Luis Obispo County Flood Control
and Water Conservation District




HEC-RAS Model Extents
and Geometry Features

DECEMBER 2017

FIGURE 5

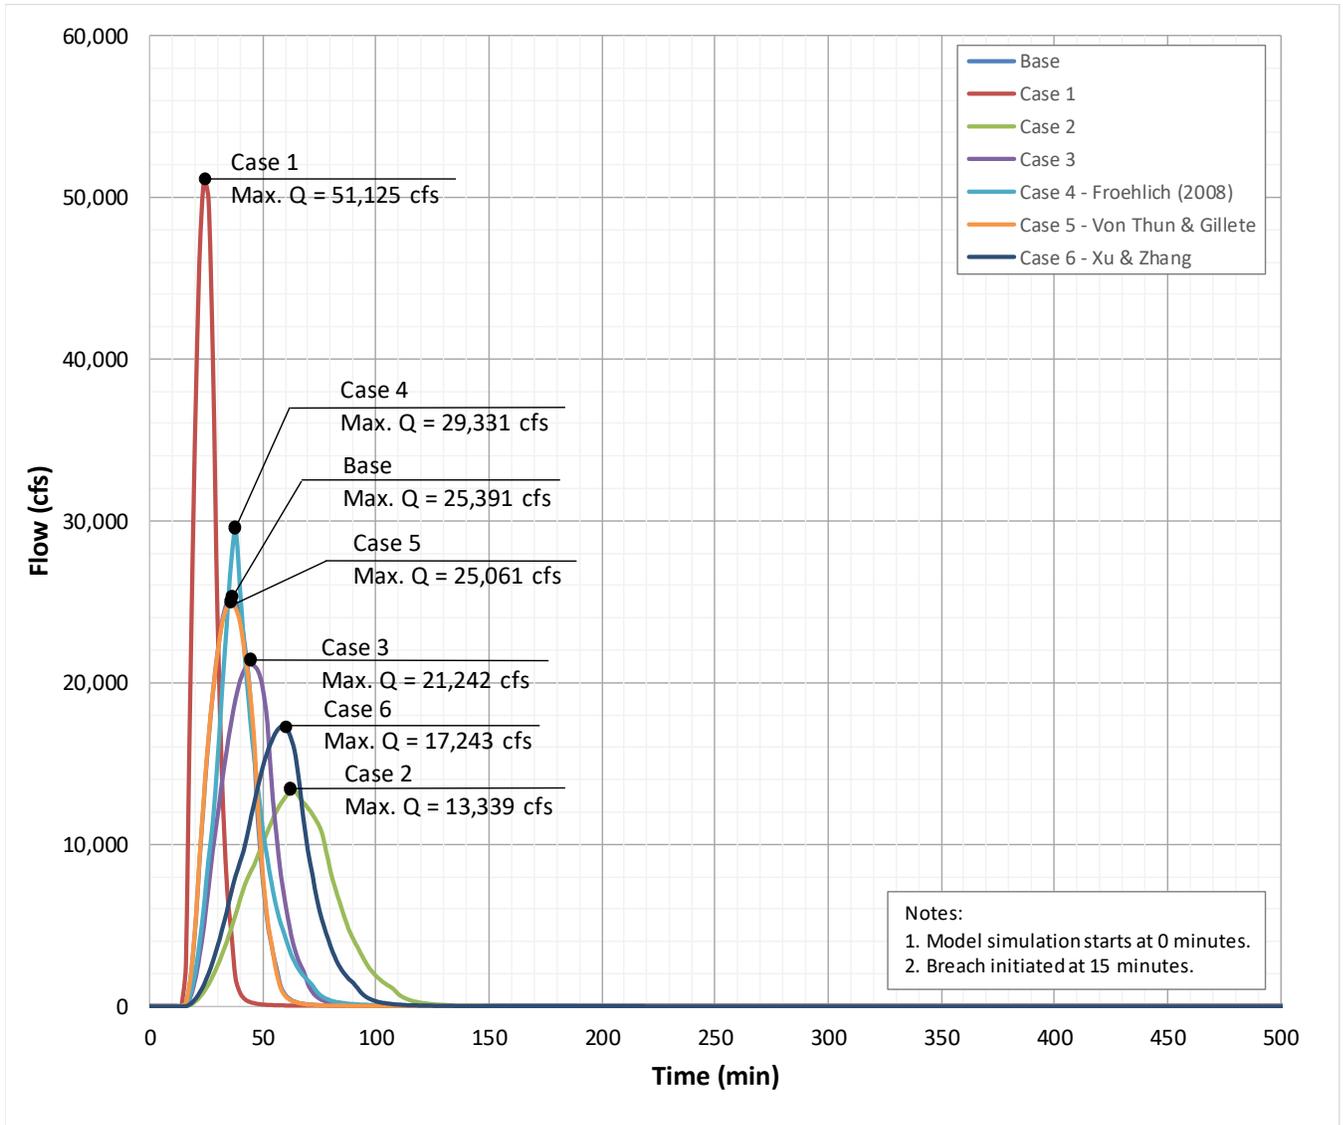

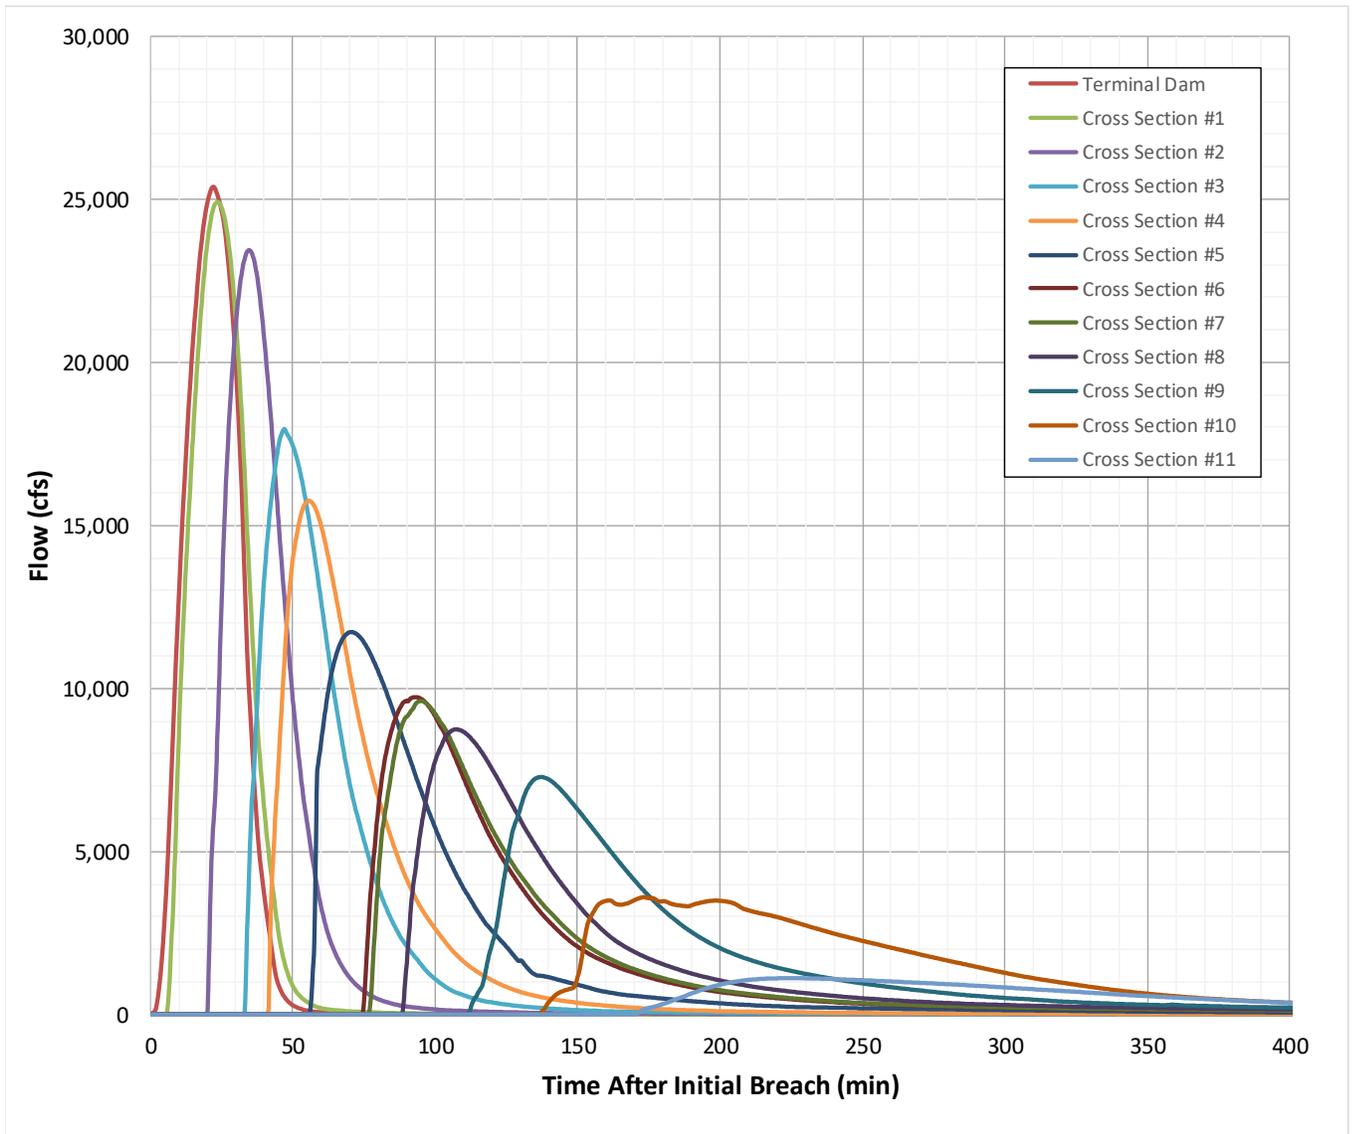

Appendix A

Terminal Dam Design/As-Built Drawings

SAN LUIS OBISPO COUNTY FLOOD CONTROL AND WATER CONSERVATION DISTRICT

LOPEZ WATER SUPPLY PROJECT

TERMINAL DAM AND RESERVOIR

VOLUME II
SPECIFICATION NO. 0803-68-3

INDEX OF DRAWINGS

SHEET NO.	TITLE
1.	TITLE SHEET, VICINITY MAP, AREA MAP AND INDEX OF DRAWINGS
2.	GENERAL LOCATION PLAN
3.	DAM EMBANKMENT PLAN AND SPILLWAY GRADING PLAN
4.	SPECIAL EXCAVATION PLAN
5.	SPILLWAY AND CHANNEL PROFILE AND DETAILS
6.	TYPICAL EMBANKMENT SECTIONS AND DETAILS
7.	SEEPAGE RELIEF WELLS AND MISCELLANEOUS DETAILS
8.	INSTRUMENTATION PLAN AND DETAILS
9.	SPILLWAY INLET STRUCTURE - PLAN AND DETAILS
10.	SPILLWAY CHUTE PLAN, PROFILE AND DETAILS
11.	CHANNEL PLAN, PROFILE AND DETAILS
12.	INTAKE STRUCTURE AND FOOTBRIDGE, PLANS, SECTIONS AND DETAILS
13.	INTAKE STRUCTURE SECTIONS AND DETAILS
14.	INTAKE STRUCTURE AND SPILLWAY MISCELLANEOUS DETAILS AND GENERAL NOTES
15.	SPILLWAY AND CHANNEL SECTIONS - PIEZOMETER BUILDING DETAILS
16.	VALVE CHAMBER PLAN AND SECTIONS - MISCELLANEOUS DETAILS
17.	BASKET SCREEN PLAN AND DETAILS - FENCE DETAILS
18.	ELECTRICAL PLAN AND DETAILS
19.	PERIMETER CHANNEL, STATION 0+25 TO 35+00
20.	PERIMETER CHANNEL, STATION 00+35 TO 88+00
21.	BIDDLE RANCH ROAD, STATION 9+00 TO 23+00
22.	BIDDLE RANCH ROAD, STATION 23+00 TO 33+00
23.	ROADWAY AND PERIMETER CHANNEL TYPICAL DETAILS
23A.	TERMINAL DAM EXCAVATION AS CONSTRUCTED
23B.	TERMINAL DAM TOPOGRAPHY AS CONSTRUCTED

DIVISION OF
SAFETY OF DAMS
DEPARTMENT OF
WATER RESOURCES
OCT 6 1970

APPROVED BY: *Hans Heilmann*
HANS HEILMANN
DATE: 5-10-68
CHAIRMAN OF THE BOARD OF SUPERVISORS OF THE
SAN LUIS OBISPO COUNTY FLOOD CONTROL AND
WATER CONSERVATION DISTRICT

SAN LUIS OBISPO COUNTY FLOOD CONTROL
AND WATER CONSERVATION DISTRICT



LOPEZ WATER SUPPLY PROJECT

TERMINAL DAM AND RESERVOIR

TITLE SHEET, VICINITY MAP, AREA MAP
AND INDEX OF DRAWINGS

PLANS PREPARED BY	REV. NO.	DATE	REVISIONS	REV.	CKD	APP.
KOEBIG & KOEBIG, INC. ENGINEERING-ARCHITECTURE PLANNING			AS CONSTRUCTED	RWS		RWS
DATE: 5-10-68						
BY: <i>B. D. Koebig</i>						
RC: 10651						

RECOMMENDED	DATE
APPROVED: <i>[Signature]</i>	
COUNTY HYDRAULIC ENGINEER	
W.C.E. NO. 2014	
DRAWN: []	
TRACED: []	
CHKD: []	
DRWG: []	
SHEET 1 of 23	


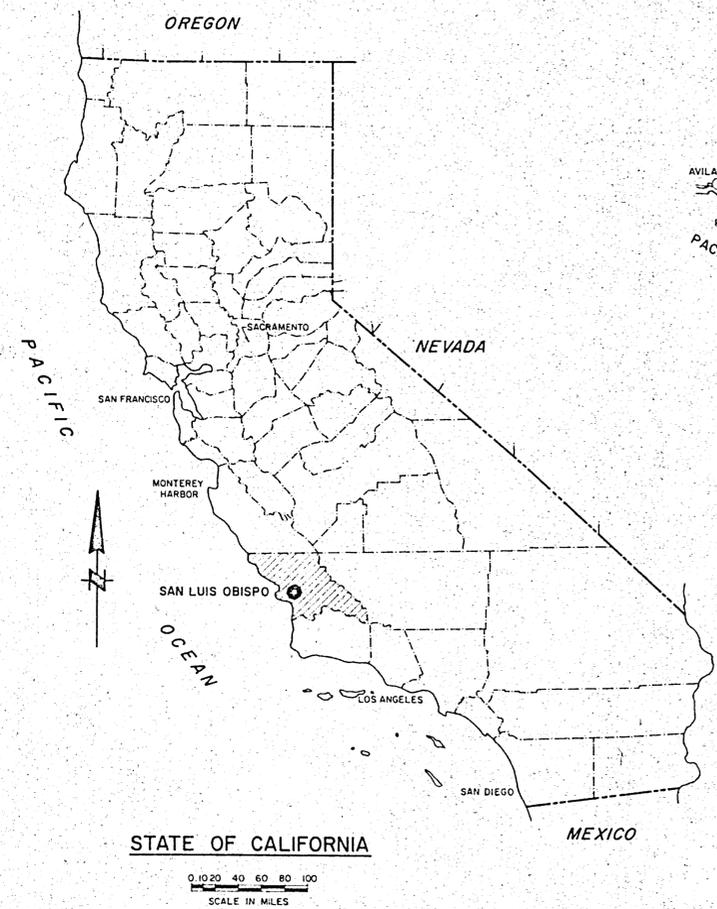
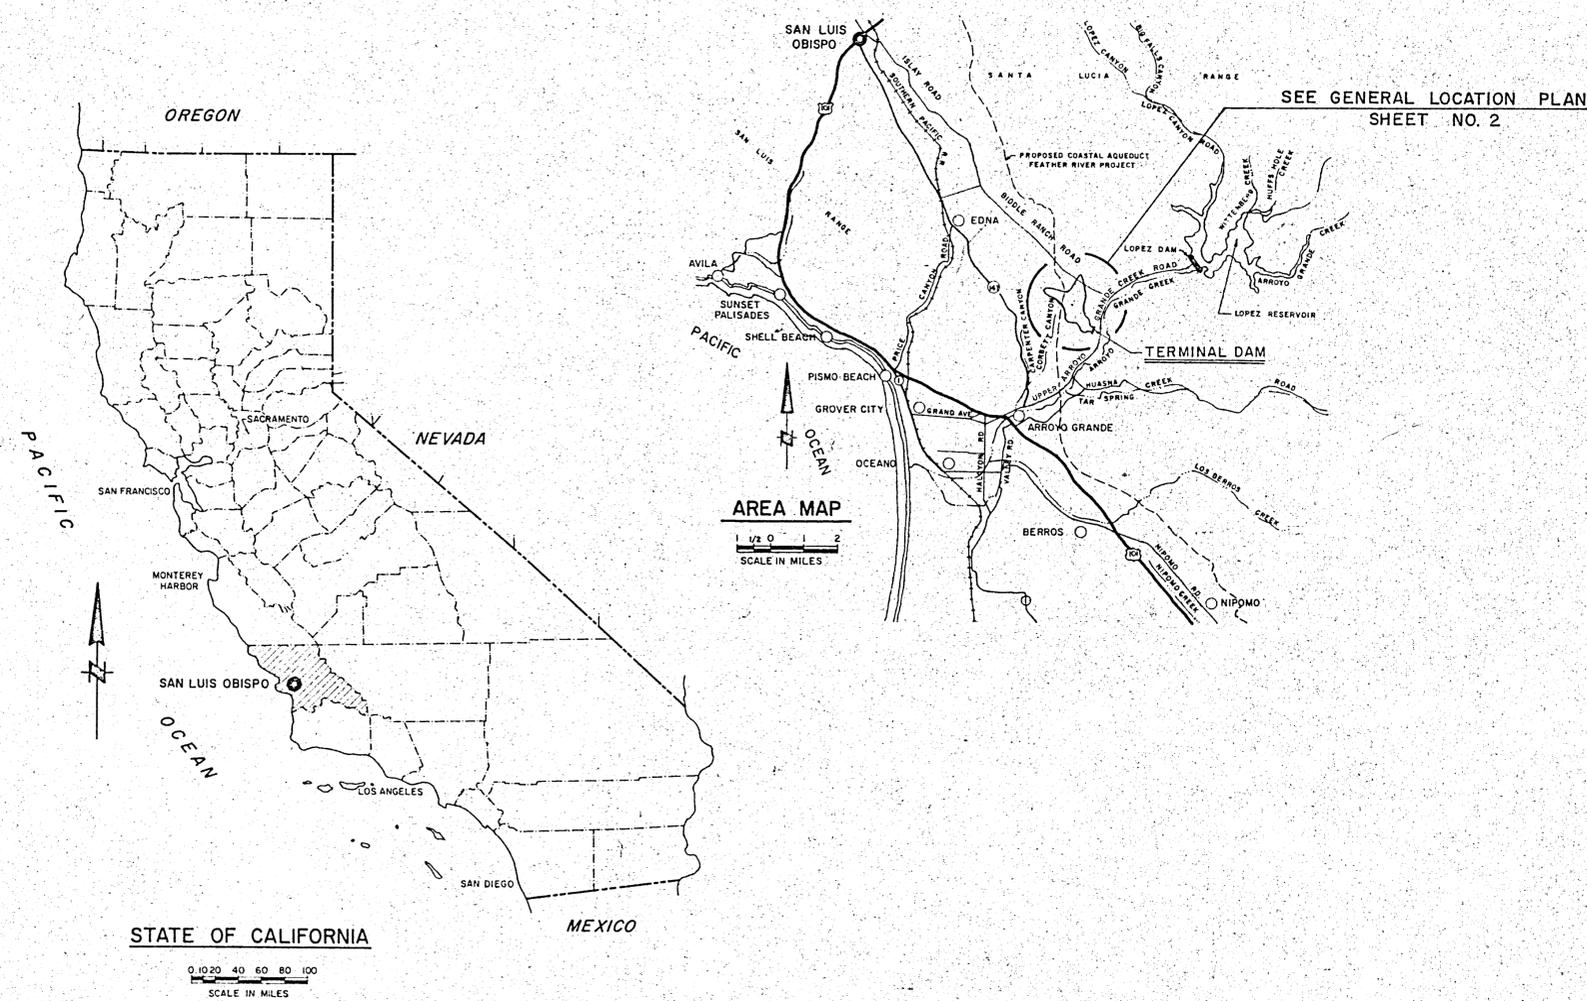


1055-2

RECORD COPY

BASIS OF BEARING
ALL BEARINGS AND DISTANCES SHOWN ON THESE DRAWINGS ARE IN CONFORMITY WITH THE "CALIFORNIA STATE COORDINATE SYSTEM, ZONE V. "BASED ON UNITED STATES GEOLOGICAL SURVEY MONUMENT "BALD MTN. 1964" AND ON UNITED STATES COAST & GEODETIC SURVEY MONUMENT "BIDDLE. 1932". THE BASIS OF BEARING FOR THESE DRAWINGS WAS CALCULATED BETWEEN THESE TWO MONUMENTS FROM THEIR RECORD COORDINATES, THE GRID BEARING BEING N 14° 49' 47" W.

BENCH MARK
BRASS DISK ESTABLISHED BY COAST & GEODETIC SURVEY AT ARROYO GRANDE, 0.6 MILE NORTHEAST ALONG ARROYO GRANDE ROAD (BRANCH STREET) FROM THE BANK OF AMERICA, AT THE "Y" JUNCTION OF AN ASPHALT ROAD LEADING SOUTH TO THE HIGH SCHOOL ATHLETICS GROUNDS, ABOUT 200 FEET SOUTH OF THE APPROXIMATE CENTER OF THE JUNCTION IN THE TOP OF THE NORTHEAST CORNER OF THE CONCRETE STONE MASONRY WALL OF THE TENNIS COURT SURROUNDED BY A FENCE, 22 1/2 FEET EAST OF THE APPROXIMATE CENTER OF THE ROAD, ABOUT 10 FEET LOWER THAN THE STREET, ABOUT 4 FEET HIGHER THAN THE ROAD, AND 0.8 FOOT NORTHEAST OF THE NORTHEAST CORNER OF THE FENCE.

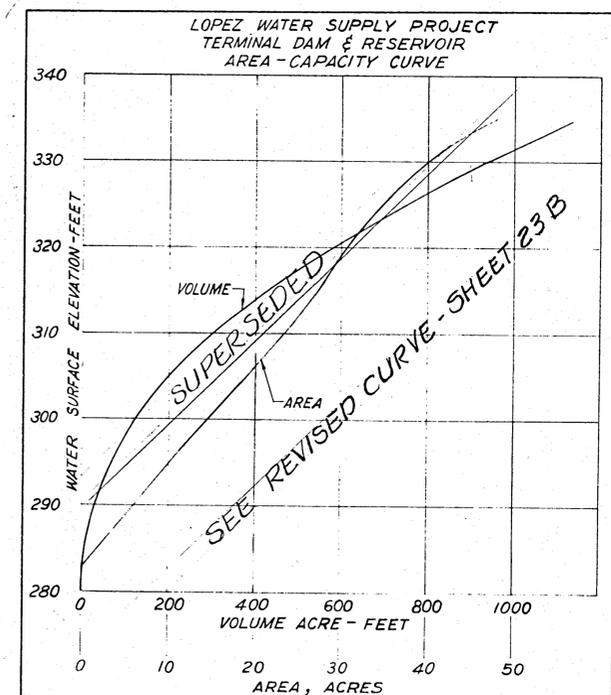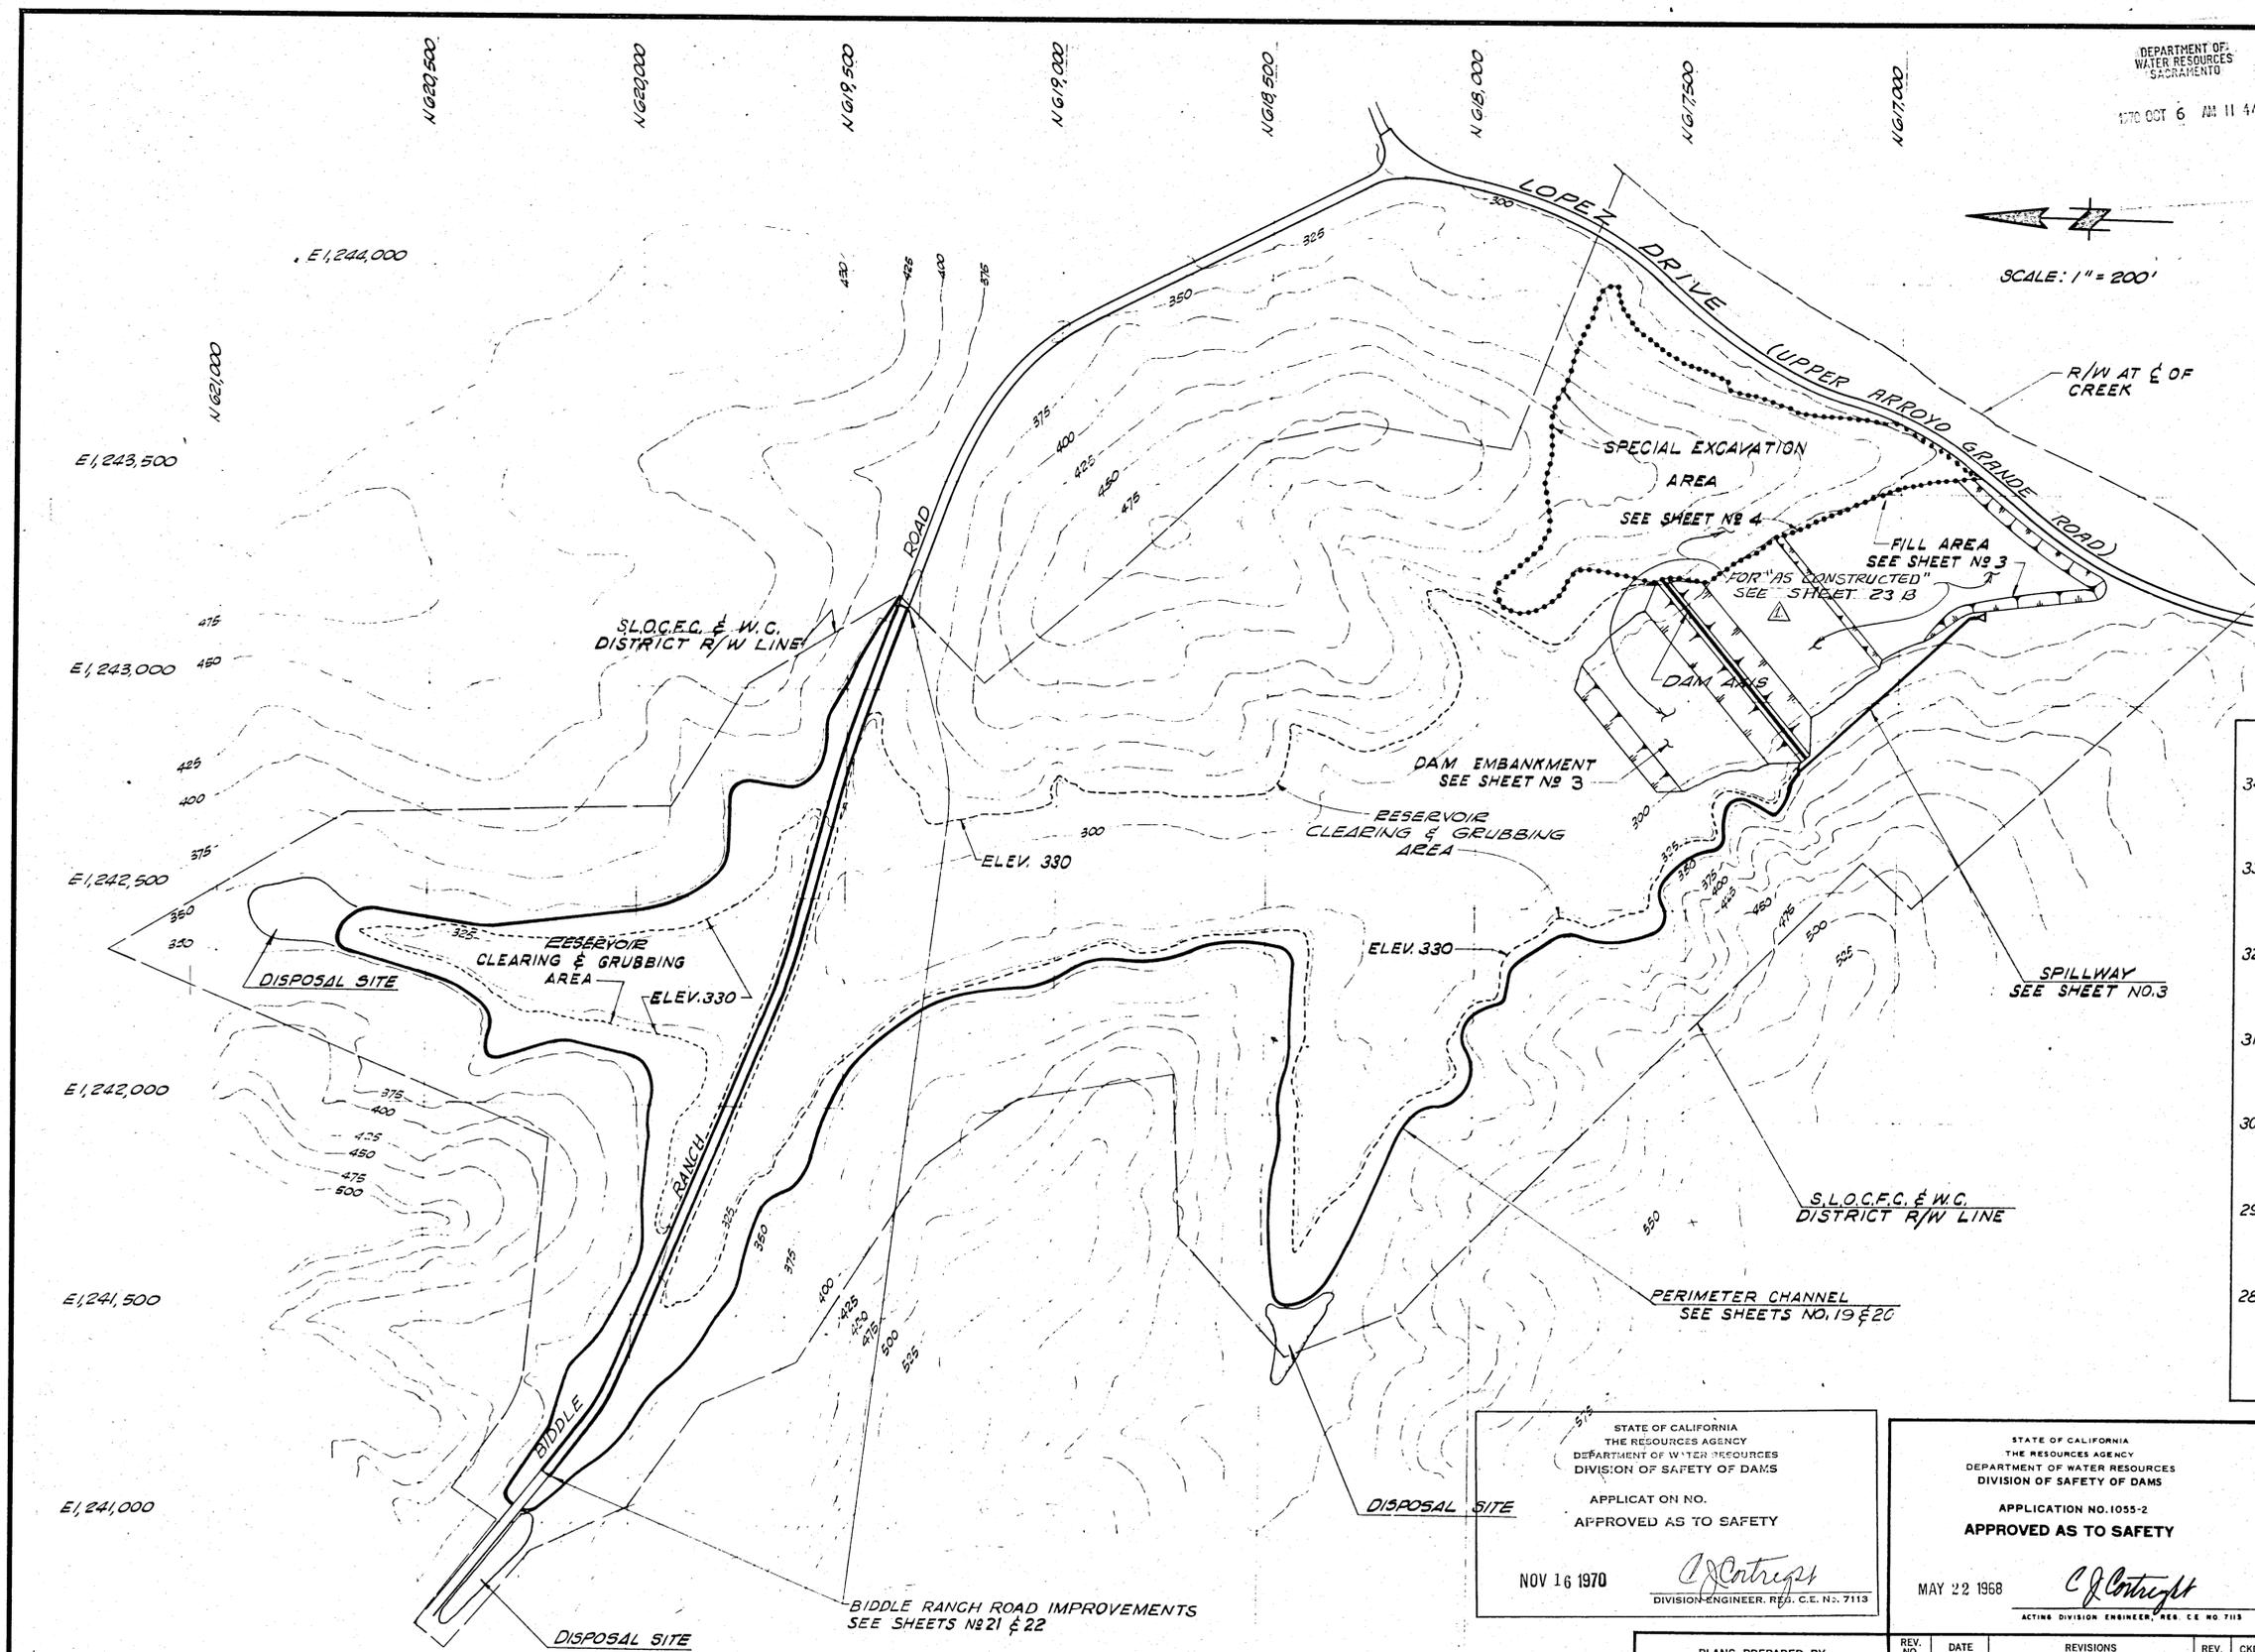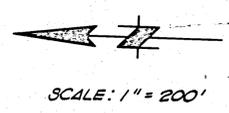

STATE OF CALIFORNIA
THE RESOURCES AGENCY
DEPARTMENT OF WATER RESOURCES
DIVISION OF SAFETY OF DAMS
APPLICATION NO. 1055-2
APPROVED AS TO SAFETY
NOV 16 1970
C. J. Contreras
DIVISION ENGINEER, REG. C.E. NO. 7113

STATE OF CALIFORNIA
THE RESOURCES AGENCY
DEPARTMENT OF WATER RESOURCES
DIVISION OF SAFETY OF DAMS
APPLICATION NO. 1055-2
APPROVED AS TO SAFETY
MAY 22 1968
C. J. Contreras
ACTING DIVISION ENGINEER, REG. C.E. NO. 7113

SAN LUIS OBISPO COUNTY FLOOD CONTROL AND WATER CONSERVATION DISTRICT

LOPEZ WATER SUPPLY PROJECT
TERMINAL DAM AND RESERVOIR

GENERAL LOCATION PLAN

PLANS PREPARED BY
KOEBIG & KOEBIG, INC.
ENGINEERING - ARCHITECTURE
PLANNING
DATE May 9 1968
BY *Martin O. Reibman*
REG. 13168





REV. NO.	DATE	REVISIONS	REV.	CKD	APP.
1		AS CONSTRUCTED			

RECOMMENDED *Richard A. Grabin* 5-11-68
APPROVED *R. A. Grabin* COUNTY HYDRAULIC ENGINEER DATE 5-11-68
DRAWN C.H. TRACED E.C. CHND C.H. DRWG SHEET 2 OF 23

COORDINATE TABLE		
POINT	NORTH	EAST
1	617,330.00	1,243,000.00
2	617,500.00	1,243,210.00
3	617,217.99	1,242,861.64
4	617,244.01	1,242,838.23
5	616,825.58	1,243,128.08
6	616,792.30	1,243,104.63
7	616,865.19	1,243,185.67
8	616,801.60	1,243,183.08
9	617,347.95	1,242,863.24
10	616,997.93	1,243,101.56
11	616,917.66	1,243,153.08
12	617,192.50	1,242,989.08
13	616,919.30	1,243,156.50
14	616,805.13	1,243,212.87

CURVE TABLE						
Nº	Δ	R	L	T	B.C.	E.C.
Δ1	35°12'33"	109.00	66.98'	34.59'	-	-
Δ2	56°50'21"	60.00	59.52'	32.47'	-	-
Δ3	35°12'33"	104.00	63.91'	33.00'	10+14.00	10+77.91

NOTE:
SEE SHEET Nº 6 FOR
TYPICAL EMBANKMENT
SECTIONS.

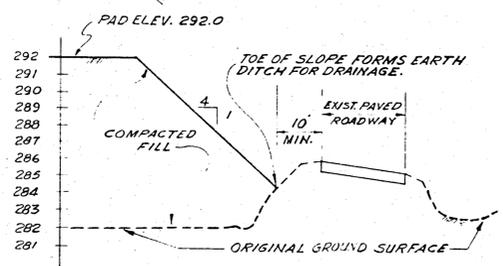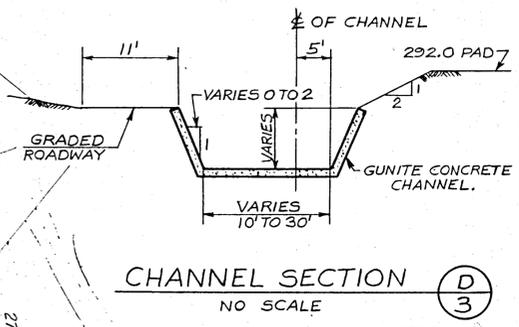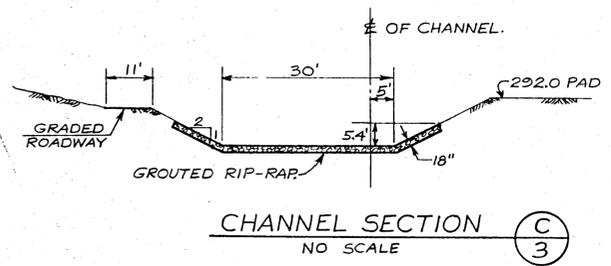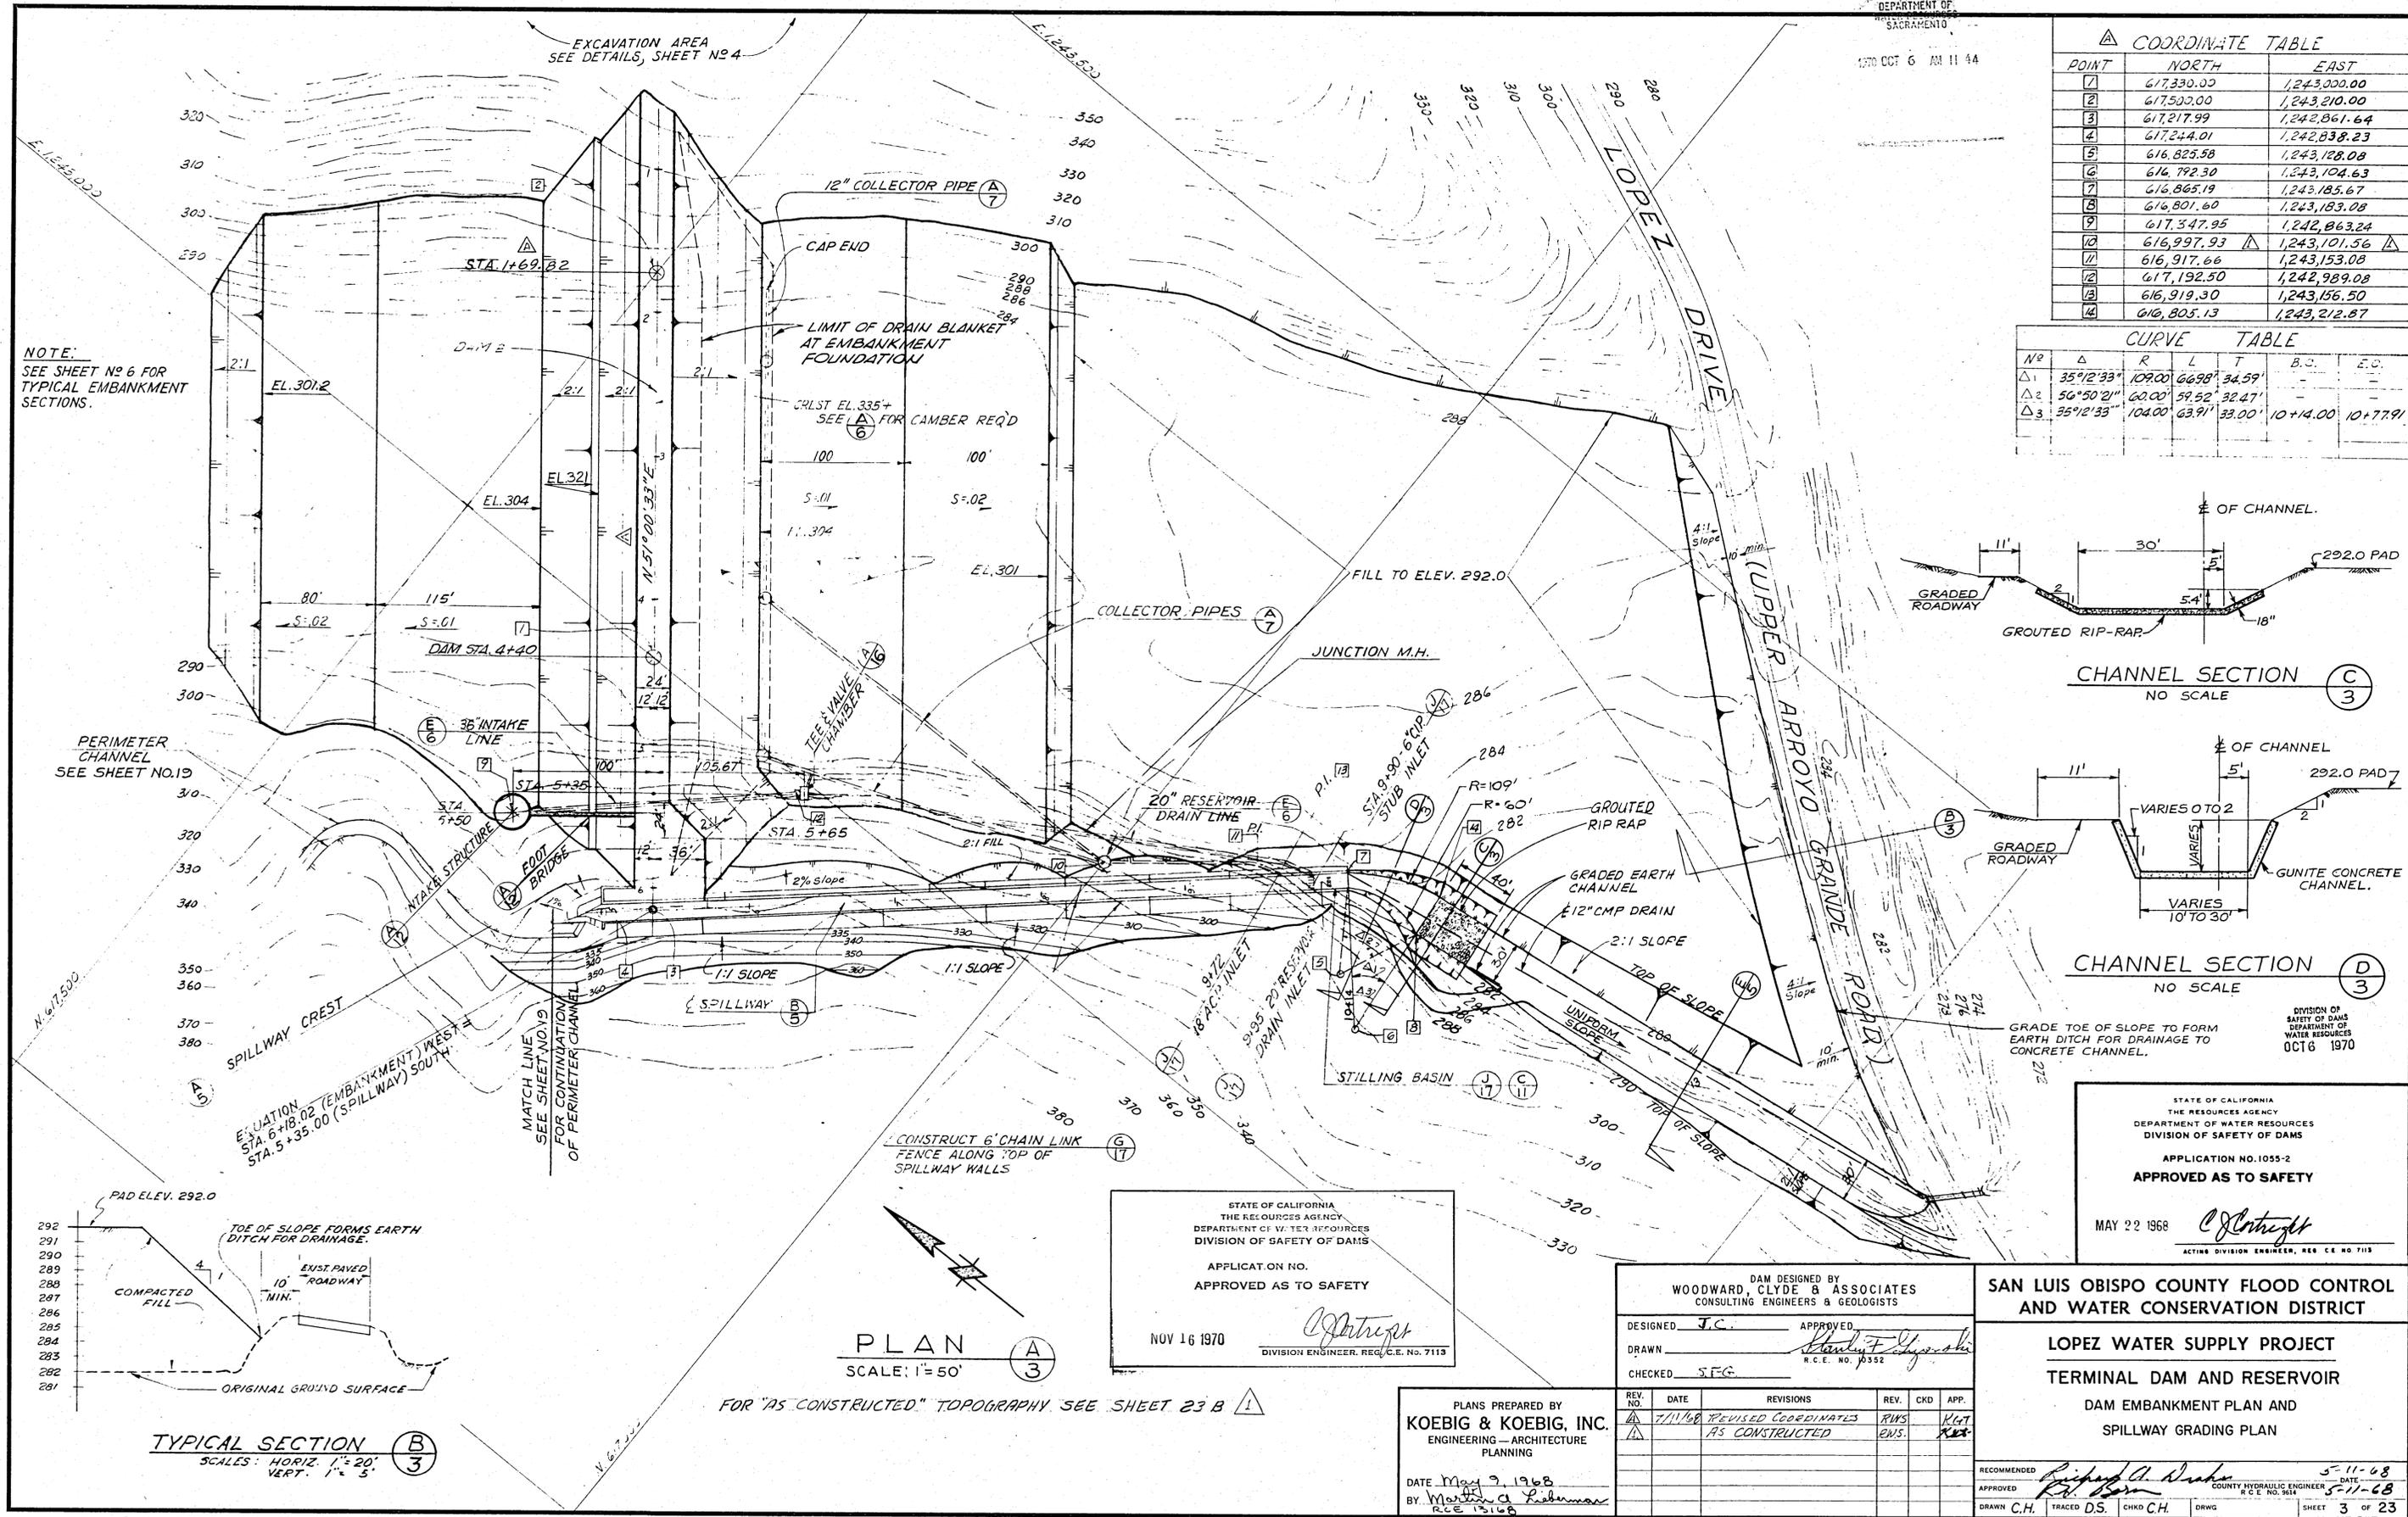

FOR "AS CONSTRUCTED" TOPOGRAPHY SEE SHEET 23 B

STATE OF CALIFORNIA
THE RESOURCES AGENCY
DEPARTMENT OF WATER RESOURCES
DIVISION OF SAFETY OF DAMS
APPLICATION NO. 1055-2
APPROVED AS TO SAFETY
NOV 16 1970
DIVISION ENGINEER, REG. C.E. NO. 7113

DAM DESIGNED BY
WOODWARD, CLYDE & ASSOCIATES
CONSULTING ENGINEERS & GEOLOGISTS
DESIGNED: J.C.
DRAWN: [Signature]
CHECKED: S.F.G.

SAN LUIS OBISPO COUNTY FLOOD CONTROL
AND WATER CONSERVATION DISTRICT

LOPEZ WATER SUPPLY PROJECT
TERMINAL DAM AND RESERVOIR


DAM EMBANKMENT PLAN AND
SPILLWAY GRADING PLAN

PLANS PREPARED BY
KOEBIG & KOEBIG, INC.
ENGINEERING - ARCHITECTURE
PLANNING
DATE: May 9, 1968
BY: [Signature]

REV. NO.	DATE	REVISIONS	REV.	CKD	APP.
1	7/11/68	REVISED COORDINATES	RWS	KGT	
2		AS CONSTRUCTED	ENS		

RECOMMENDED: [Signature] 5-11-68
APPROVED: [Signature] 5-11-68
DRAWN: C.H. TRACED: D.S. CHKD: C.H. SHEET 3 OF 23

SCALE: 1" = 50'

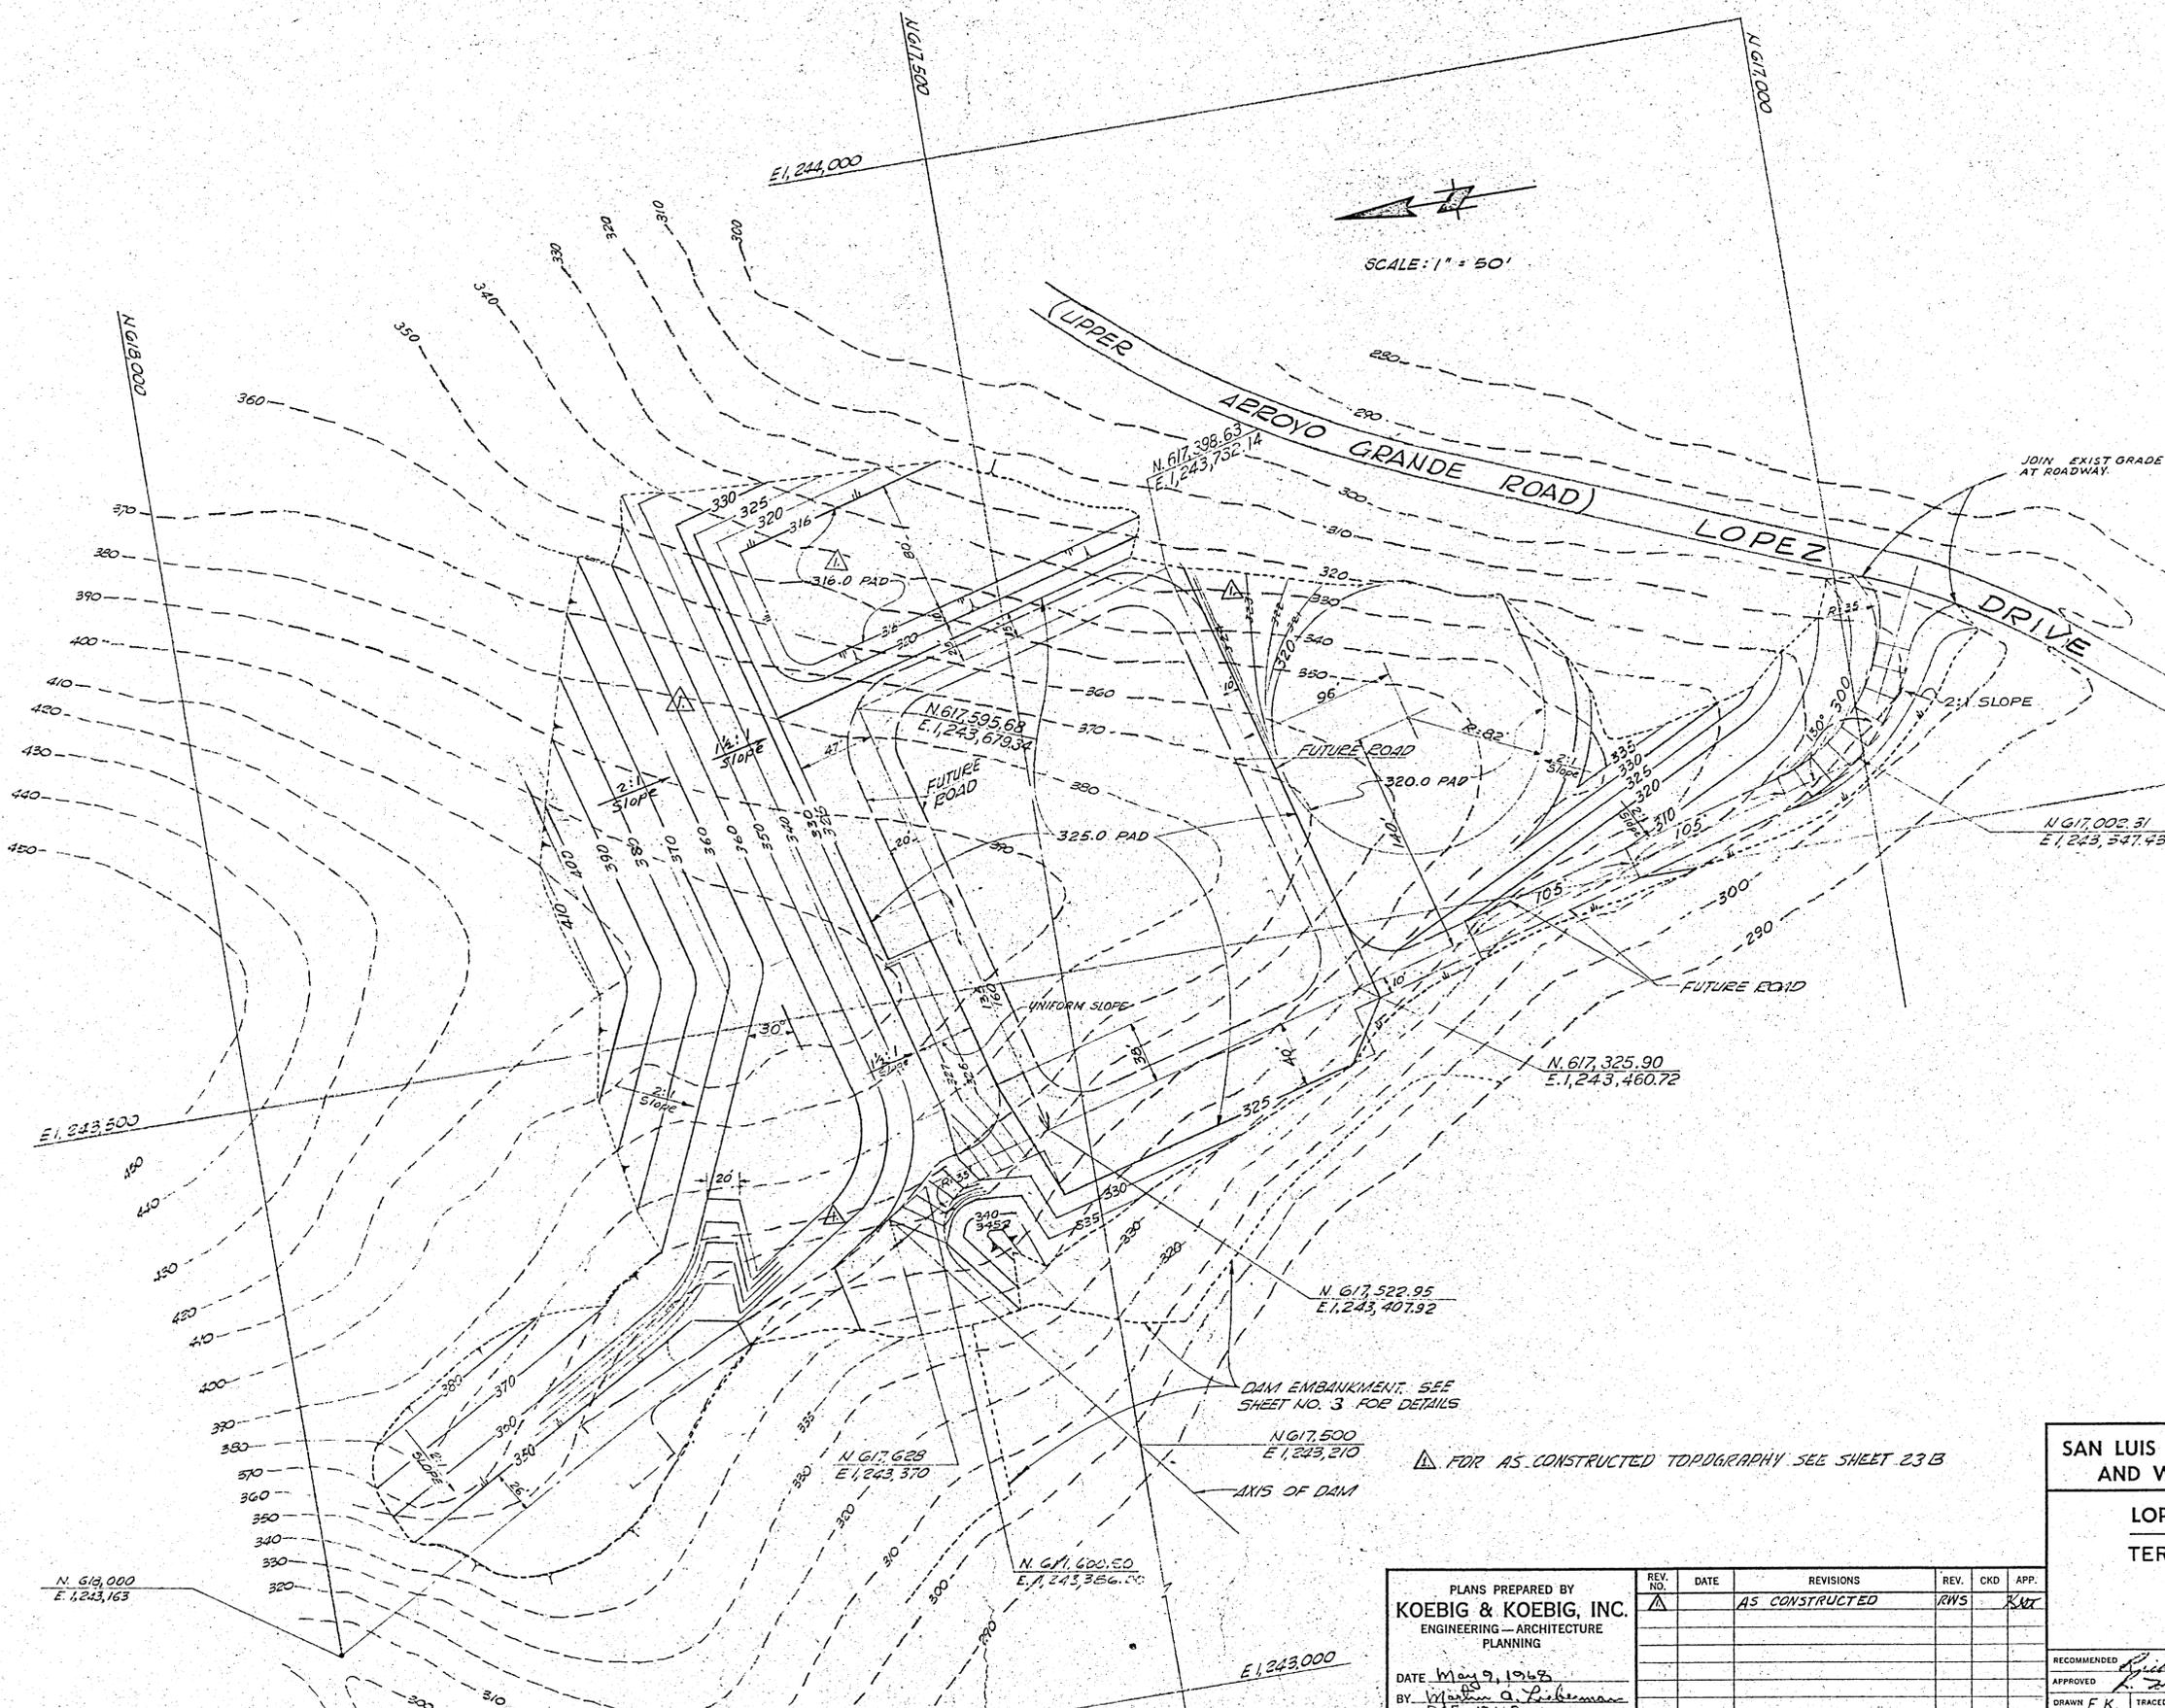

JOIN EXIST GRADE
AT ROADWAY

DAM EMBANKMENT. SEE
SHEET NO. 3 FOR DETAILS

▲ FOR AS CONSTRUCTED TOPOGRAPHY SEE SHEET 23 B

PLANS PREPARED BY
KOEBIG & KOEBIG, INC.
ENGINEERING—ARCHITECTURE
PLANNING

DATE May 9, 1968
BY William A. Liebman
RLE 13149

REV. NO.	DATE	REVISIONS	REV.	CKD	APP.
1		AS CONSTRUCTED	RWS		KAT

**SAN LUIS OBISPO COUNTY FLOOD CONTROL
AND WATER CONSERVATION DISTRICT**

**LOPEZ WATER SUPPLY PROJECT
TERMINAL DAM AND RESERVOIR**







SPECIAL EXCAVATION PLAN

RECOMMENDED Richard G. Durkin 5-11-68
APPROVED R. A. Brown COUNTY HYDRAULIC ENGINEER 5-11-68
DRAWN E.K. TRACED D.S. CHKD C.H. DRWG SHEET 4 OF 23

DIVISION OF
SAFETY OF DAMS
DEPARTMENT OF
WATER RESOURCES
OCT 6 1970

1055-2

RECORD
COPY

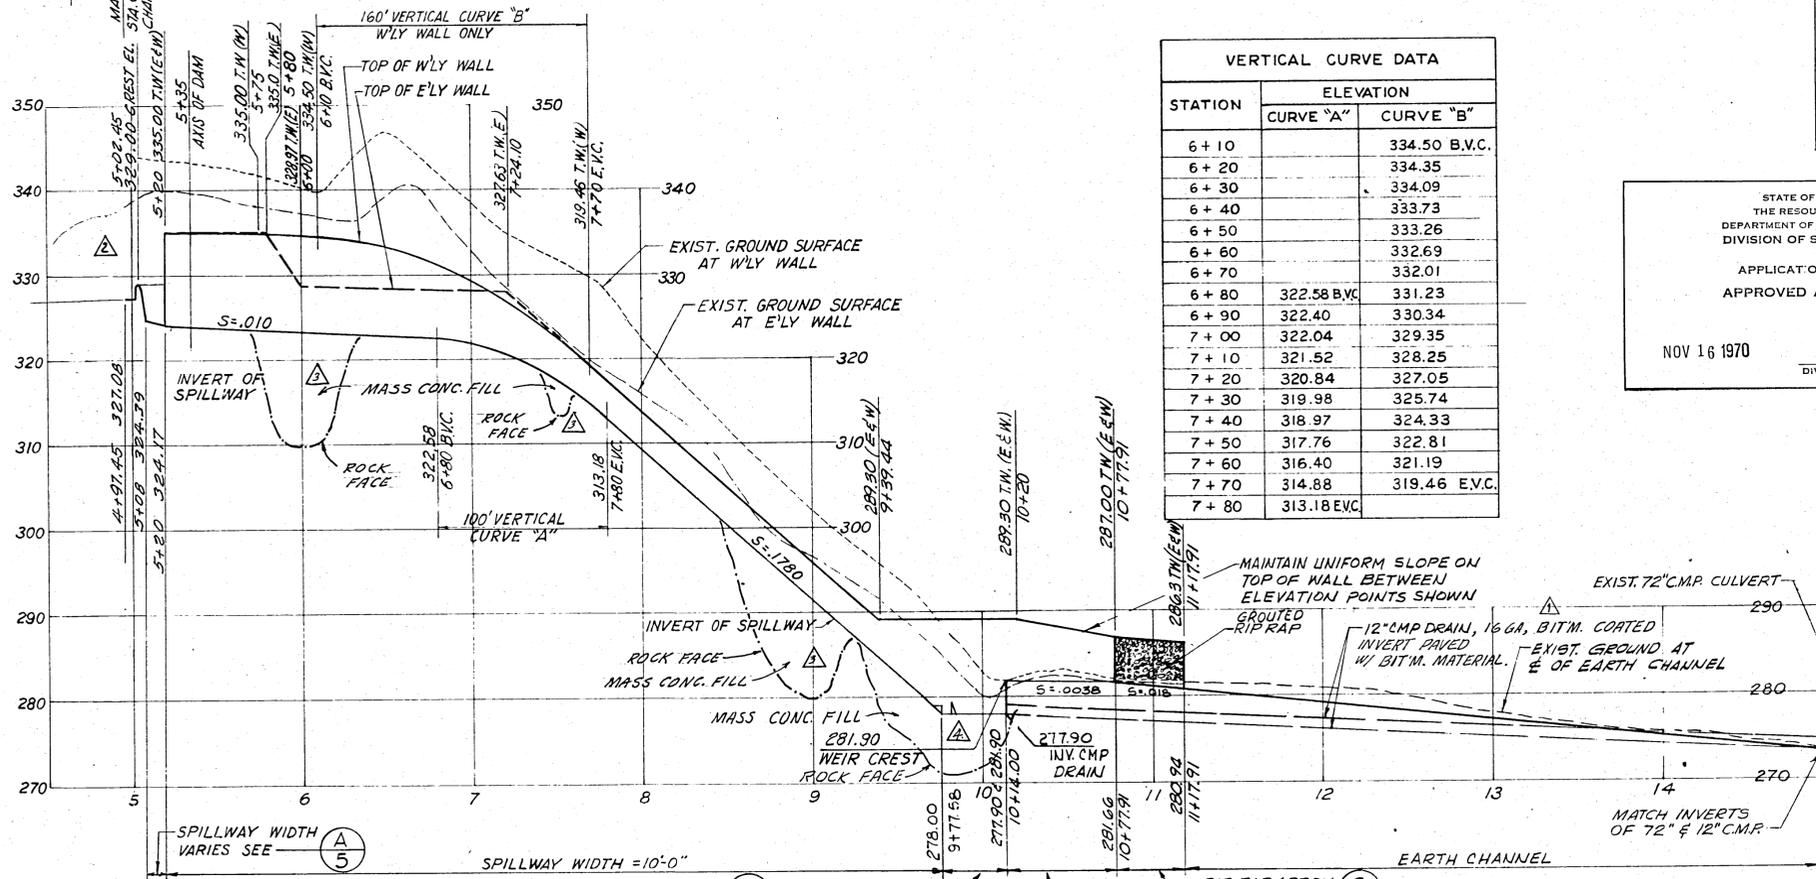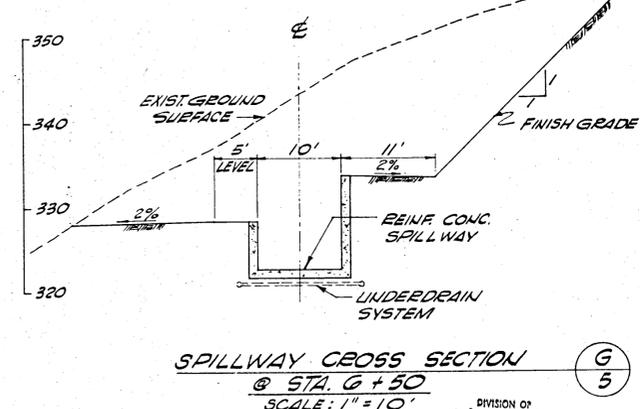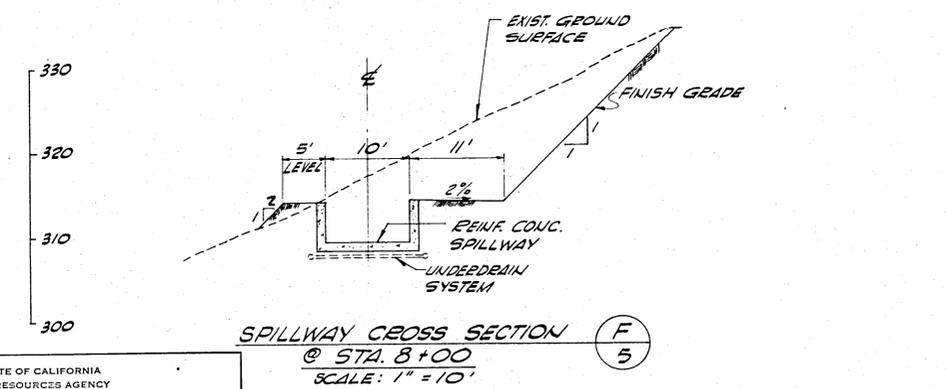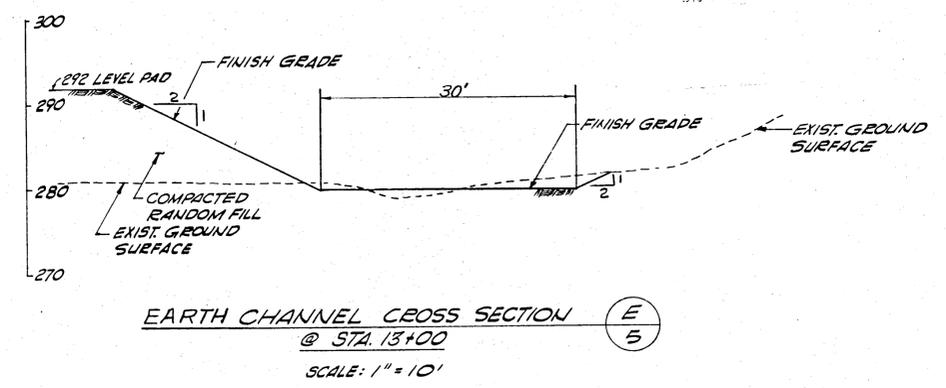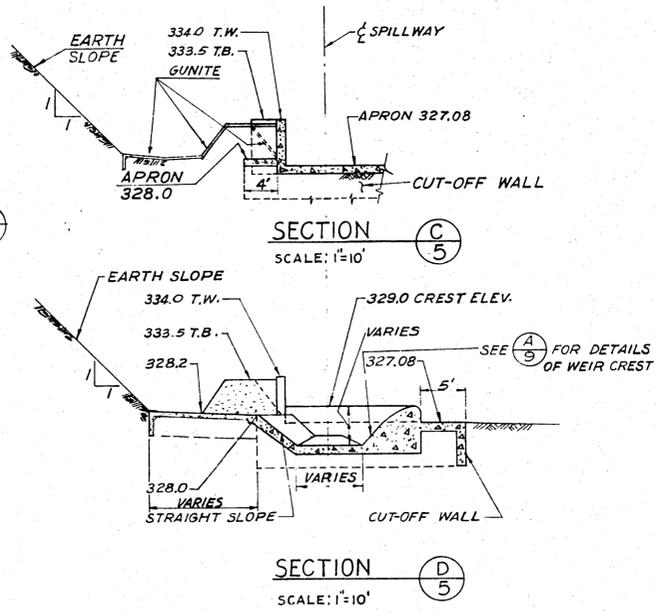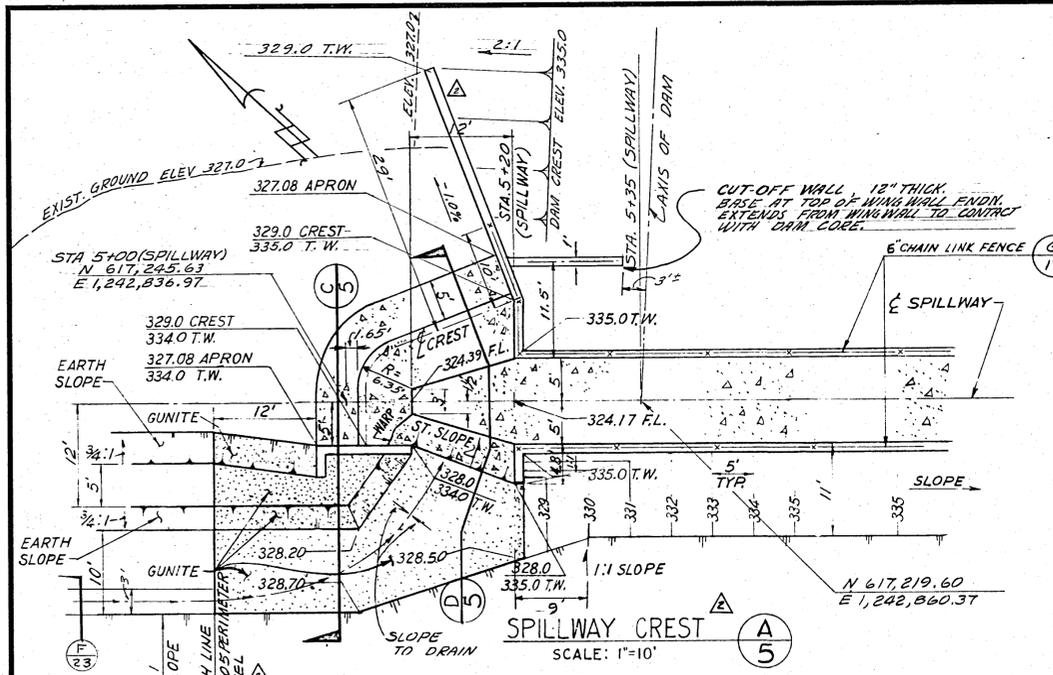

STATION	ELEVATION	
	CURVE "A"	CURVE "B"
6 + 10		334.50 B.V.C.
6 + 20		334.35
6 + 30		334.09
6 + 40		333.73
6 + 50		333.26
6 + 60		332.69
6 + 70		332.01
6 + 80	322.58 B.V.C.	331.23
6 + 90	322.40	330.34
7 + 00	322.04	329.35
7 + 10	321.52	328.25
7 + 20	320.84	327.05
7 + 30	319.98	325.74
7 + 40	318.97	324.33
7 + 50	317.76	322.81
7 + 60	316.40	321.19
7 + 70	314.88	319.46 E.V.C.
7 + 80	313.18 E.V.C.	

STATE OF CALIFORNIA
THE RESOURCES AGENCY
DEPARTMENT OF WATER RESOURCES
DIVISION OF SAFETY OF DAMS
APPLICATION NO.
APPROVED AS TO SAFETY
NOV 16 1970
DIVISION ENGINEER, REG. C.E. NO. 7113

STATE OF CALIFORNIA
THE RESOURCES AGENCY
DEPARTMENT OF WATER RESOURCES
DIVISION OF SAFETY OF DAMS
APPLICATION NO. 1055-2
APPROVED AS TO SAFETY
MAY 22 1968
ACTING DIVISION ENGINEER, REG. C.E. NO. 7113

SAN LUIS OBISPO COUNTY FLOOD CONTROL
AND WATER CONSERVATION DISTRICT

LOPEZ WATER SUPPLY PROJECT
TERMINAL DAM AND RESERVOIR
SPILLWAY AND CHANNEL
PROFILE AND DETAILS

SPILLWAY PROFILE
STILLING BASIN WIDTH = 10'-0"
RIP RAP APRON
GUNITE TRANSITION
SCALES:
HORIZ. = 1" = 50'
VERT. = 1" = 10'





PLANS PREPARED BY
KOEBIG & KOEBIG, INC.
ENGINEERING - ARCHITECTURE
PLANNING
DATE May 9, 1968
BY Martin A. Kuehner
RCE 13168

REV. NO.	DATE	REVISIONS	REV.	CKD	APP.
1	7-11-68	ADDENDUM #2	RWS	MD	RWS
2	8-21-68	REV WEIR LOC. & WINGWALL	RWS	MD	RWS
3		CHANGE ORDER #2 - 8/15/68	RWS		RWS
4		CHANGE ORDER #3	RWS		RWS
5		AS CONSTRUCTED	RWS		RWS

RECOMMENDED
APPROVED
DRAWN C.H.
TRACED D.S.
CHKD C.H.
DRWG
SHEET 5 OF 23



1055-2

RECORD COPY

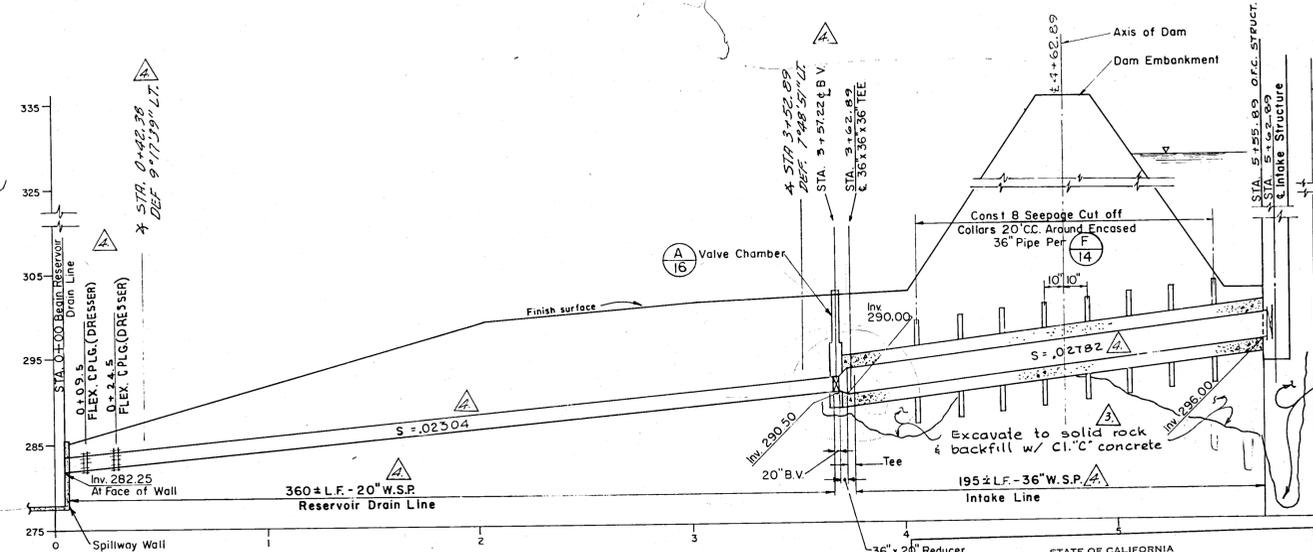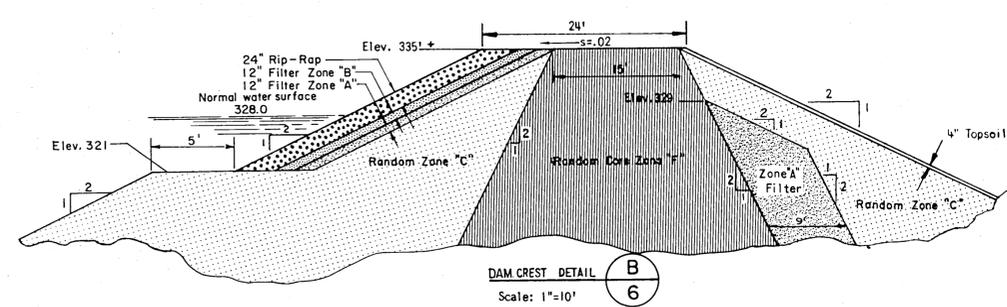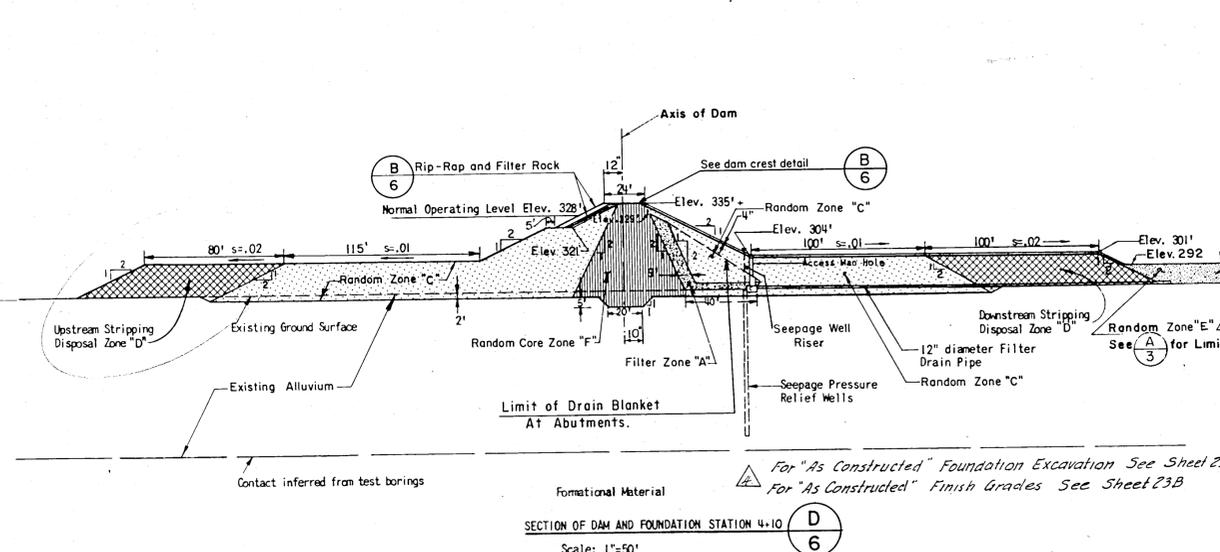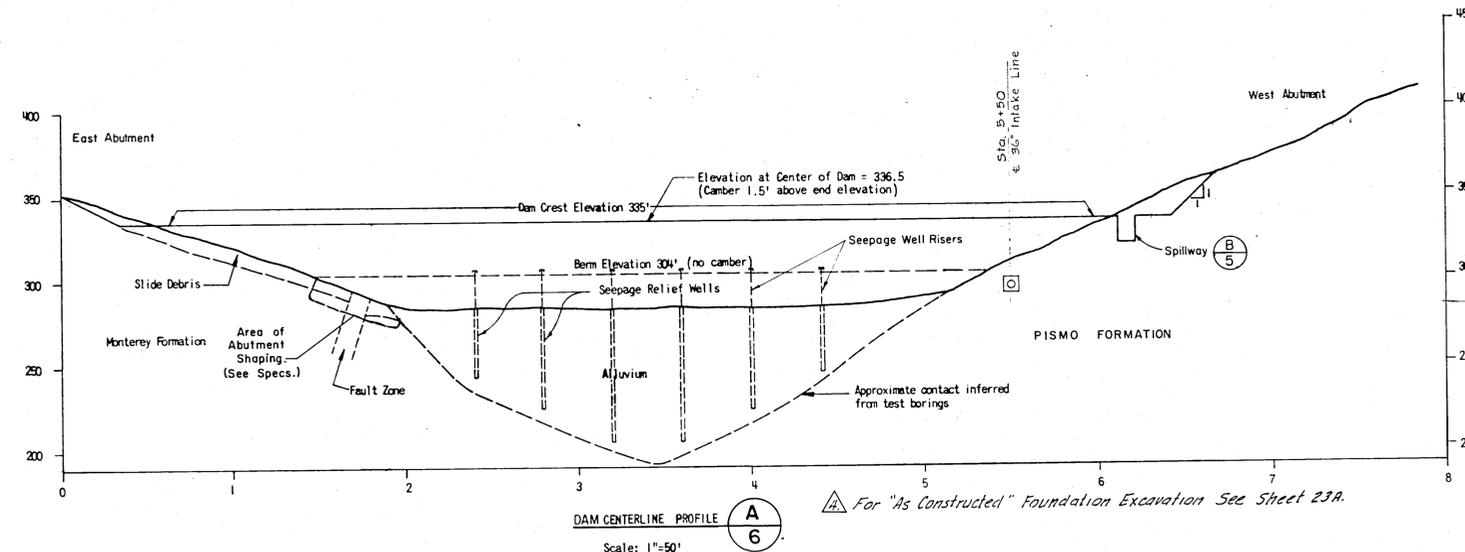

ABBREVIATIONS

- A.C.P. - ASBESTOS CEMENT PIPE
- C.C.P. - CONCRETE CYLINDER PIPE
- C.I.P. - CAST IRON PIPE
- CONC. - CONCRETE
- GALV. - GALVANIZED
- G.S.P. - GALVANIZED STEEL PIPE
- INV. - INVERT
- M.H. - MANHOLE
- M.I. - MALLEABLE IRON
- P.V.C. - POLYVINYL CHLORIDE
- REINF. - REINFORCED
- SS - STAINLESS STEEL, TYPE 316
- T.B. - TOP OF BERM
- T.W. - TOP OF WALL
- W.S.P. - WELDED STEEL PIPE, CEMENT MORTAR LINED AND COATED

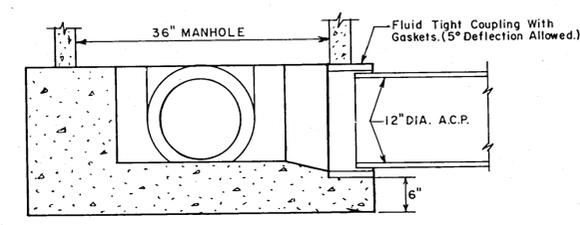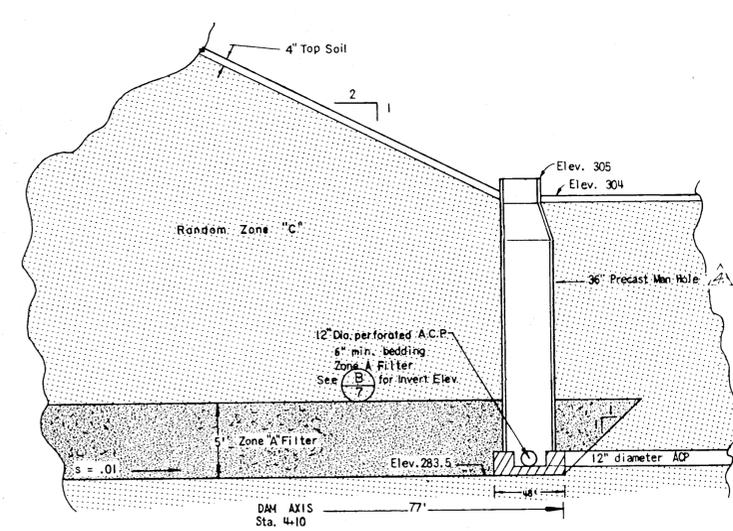

STATE OF CALIFORNIA
THE RESOURCES AGENCY
DEPARTMENT OF WATER RESOURCES
DIVISION OF SAFETY OF DAMS

APPLICATION NO. 1055-2
APPROVED AS TO SAFETY

NOV 16 1970

C. J. Ontiveros
DIVISION ENGINEER, REG. C.E. NO. 7113

STATE OF CALIFORNIA
THE RESOURCES AGENCY
DEPARTMENT OF WATER RESOURCES
DIVISION OF SAFETY OF DAMS

APPLICATION NO. 1055-2
APPROVED AS TO SAFETY

MAY 22 1968

C. J. Ontiveros
ACTING DIVISION ENGINEER, REG. C.E. NO. 7113

DAM DESIGNED BY
WOODWARD, CLYDE & ASSOCIATES
CONSULTING ENGINEERS & GEOLOGISTS

DESIGNED *J.C.* APPROVED
DRAWN *Richard J. Gjonaj*
CHECKED *SEG*

SAN LUIS OBISPO COUNTY FLOOD CONTROL AND WATER CONSERVATION DISTRICT

LOPEZ WATER SUPPLY PROJECT

TERMINAL DAM AND RESERVOIR




TYPICAL EMBANKMENT SECTIONS AND DETAILS

RECOMMENDED *R. J. Gjonaj* DATE 5-11-68
APPROVED *R. J. Gjonaj* COUNTY HYDRAULIC ENGINEER R.C.E. NO. 214 DATE 5-11-68
DRAWN C.H. TRACED E.C. CHKD C.H. DRWG SHEET 6 OF 23


PLANS PREPARED BY
KOEBIG & KOEBIG, INC.
ENGINEERING - ARCHITECTURE
PLANNING

DATE *May 9, 1968*
BY *Martin A. Lieberman*

REV. NO.	DATE	REVISIONS	REV.	CHKD.	APP.
1	7-11-68	ADDENDUM NO 2 - 6/11/68	RWS		KLT
2		CHANGE ORDER NO 1 - 8/8/68	RWS		WJ
3		CHANGE ORDER NO 3 - 9/6/68	RWS		WJ
4		AS CONSTRUCTED	RWS		WJ

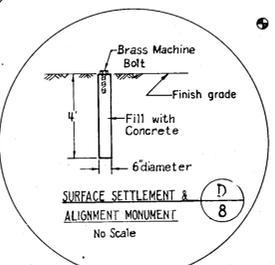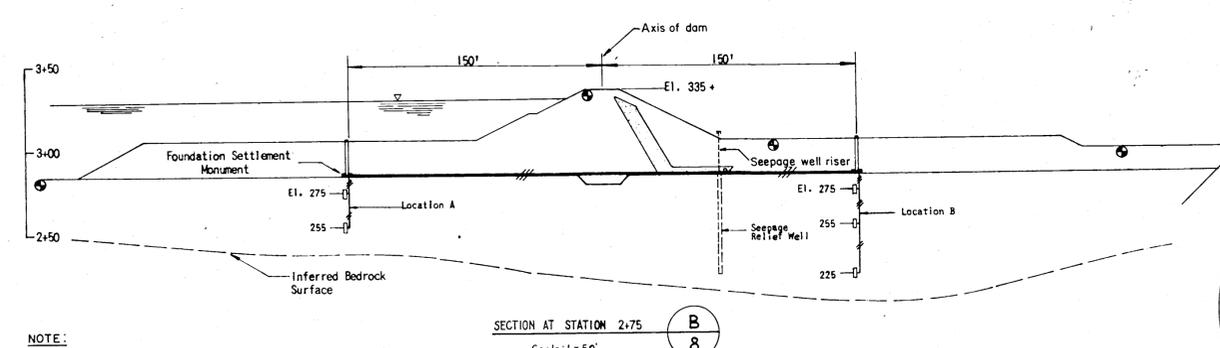
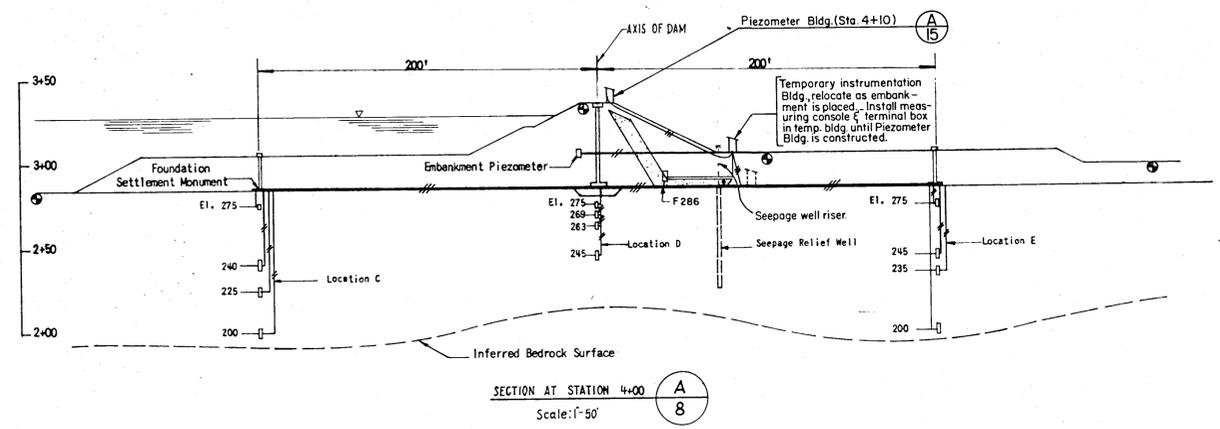


NOTE:
Piezometer B-225, C-200 & D-245 shall be monitored through piezometer annunciator panel.



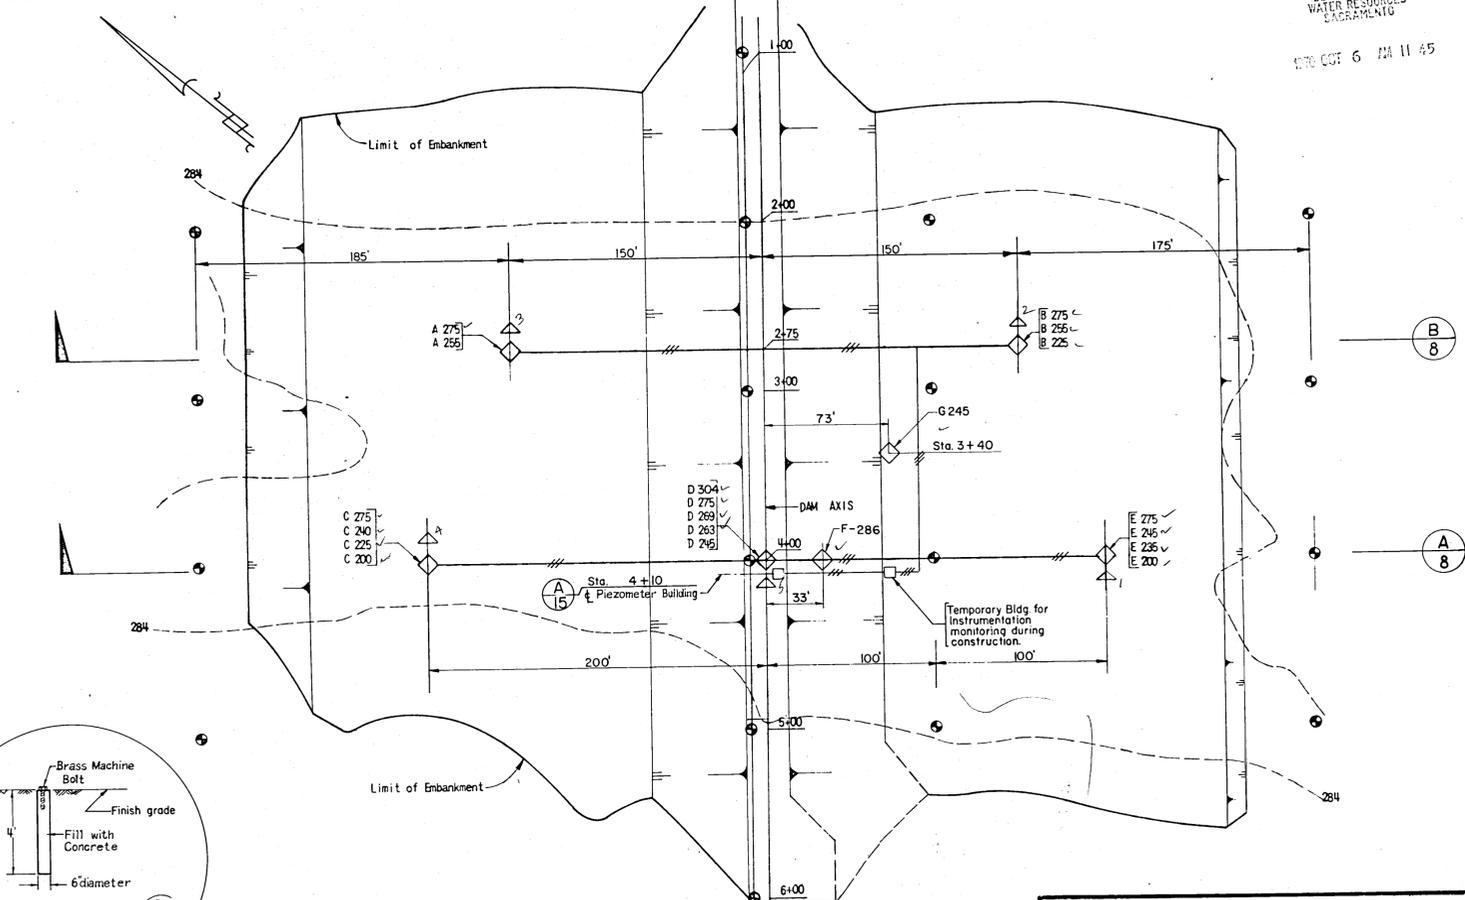


- LEGEND
- Surface Settlement and Alignment Monuments.
 - ◇ Piezometer (plan).
 - △ Foundation Settlement Gage.
 - Piezometer (section)
 - Single Unit Line
 - Multiple Unit Line
 - Elevation Designation
 - Location


- NOTES
1. Provide continuous protection, location and identification of entire instrumentation system throughout construction.
 2. Piping and protective coating shall be as specified.
 3. Local soil materials may be used for construction purposes subject to the approval by the Engineer.
 4. Construction scheduling shall be subject to approval by the Engineer.
 5. Provide adequate number of junction boxes to accommodate all piezometers shown plus not less than 50% additional leadout lines for future spares.
 6. Contractor's operations involving installation of embankment instrumentation shall be conducted only during the presence of the manufacturer's representative unless otherwise authorized by the Engineer.

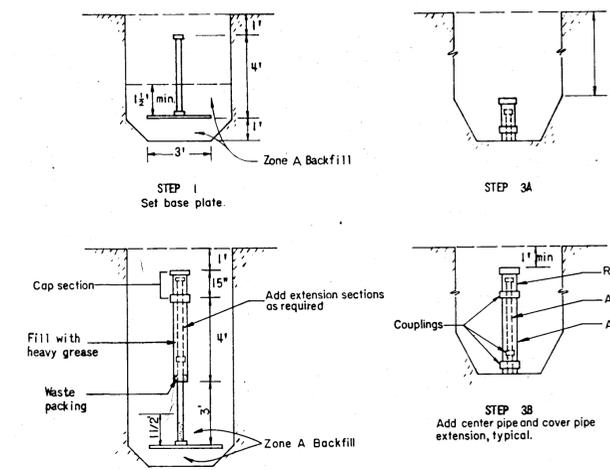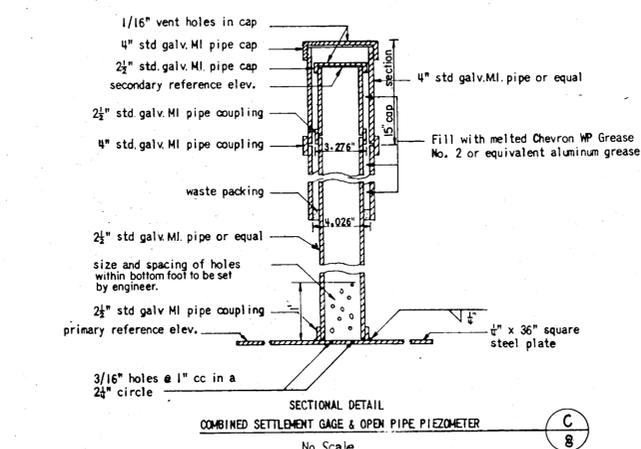

NOTE:
Upon completion of the embankment, the settlement gage shall be extended to 6" above the finish grade, except for settlement gage located within the crest of the dam which shall be flush with the finish grade.

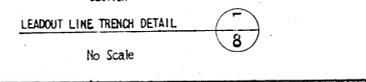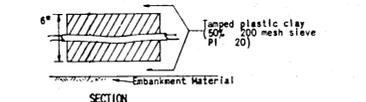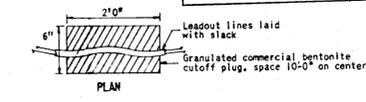

STATE OF CALIFORNIA
THE RESOURCES AGENCY
DEPARTMENT OF WATER RESOURCES
DIVISION OF SAFETY OF DAMS
APPLICATION NO.
APPROVED AS TO SAFETY
NOV 16 1970
DIVISION ENGINEER, REG. C.E. NO. 7113

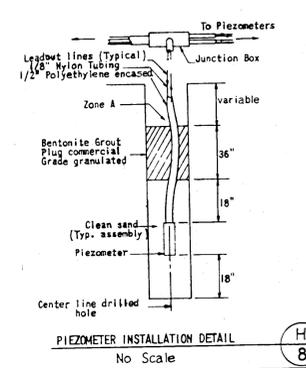

DAM DESIGNED BY
WOODWARD, CLYDE & ASSOCIATES
CONSULTING ENGINEERS & GEOLOGISTS
DESIGNED: [Signature]
DRAWN: [Signature]
CHECKED: S.F.C.


REV. NO.	DATE	REVISIONS	REV.	CHKD.	APP.
1	AS CONSTRUCTED				

PLANS PREPARED BY
KOEBIG & KOEBIG, INC.
ENGINEERING - ARCHITECTURE
PLANNING
DATE 5/9/68
BY Charles R. Lawrence
R.C.E. 9037








STATE OF CALIFORNIA
THE RESOURCES AGENCY
DEPARTMENT OF WATER RESOURCES
DIVISION OF SAFETY OF DAMS
APPLICATION NO. 1055-2
APPROVED AS TO SAFETY
MAY 22 1968
[Signature]
ACTIVE DIVISION ENGINEER, REG. C.E. NO. 7113

SAN LUIS OBISPO COUNTY FLOOD CONTROL
AND WATER CONSERVATION DISTRICT
LOPEZ WATER SUPPLY PROJECT
TERMINAL DAM AND RESERVOIR

INSTRUMENTATION PLAN
AND DETAILS
DIVISION OF SAFETY OF DAMS
DEPARTMENT OF WATER RESOURCES
OCT 6 1970
RECOMMENDED [Signature] DATE 5-11-68
APPROVED [Signature] COUNTY HYDRAULIC ENGINEER R.C.E. NO. 9412 DATE 5-11-68
DRAWN C.H. TRACED D.S. CHKD C.H.L. DRWG SHEET 8 OF 23

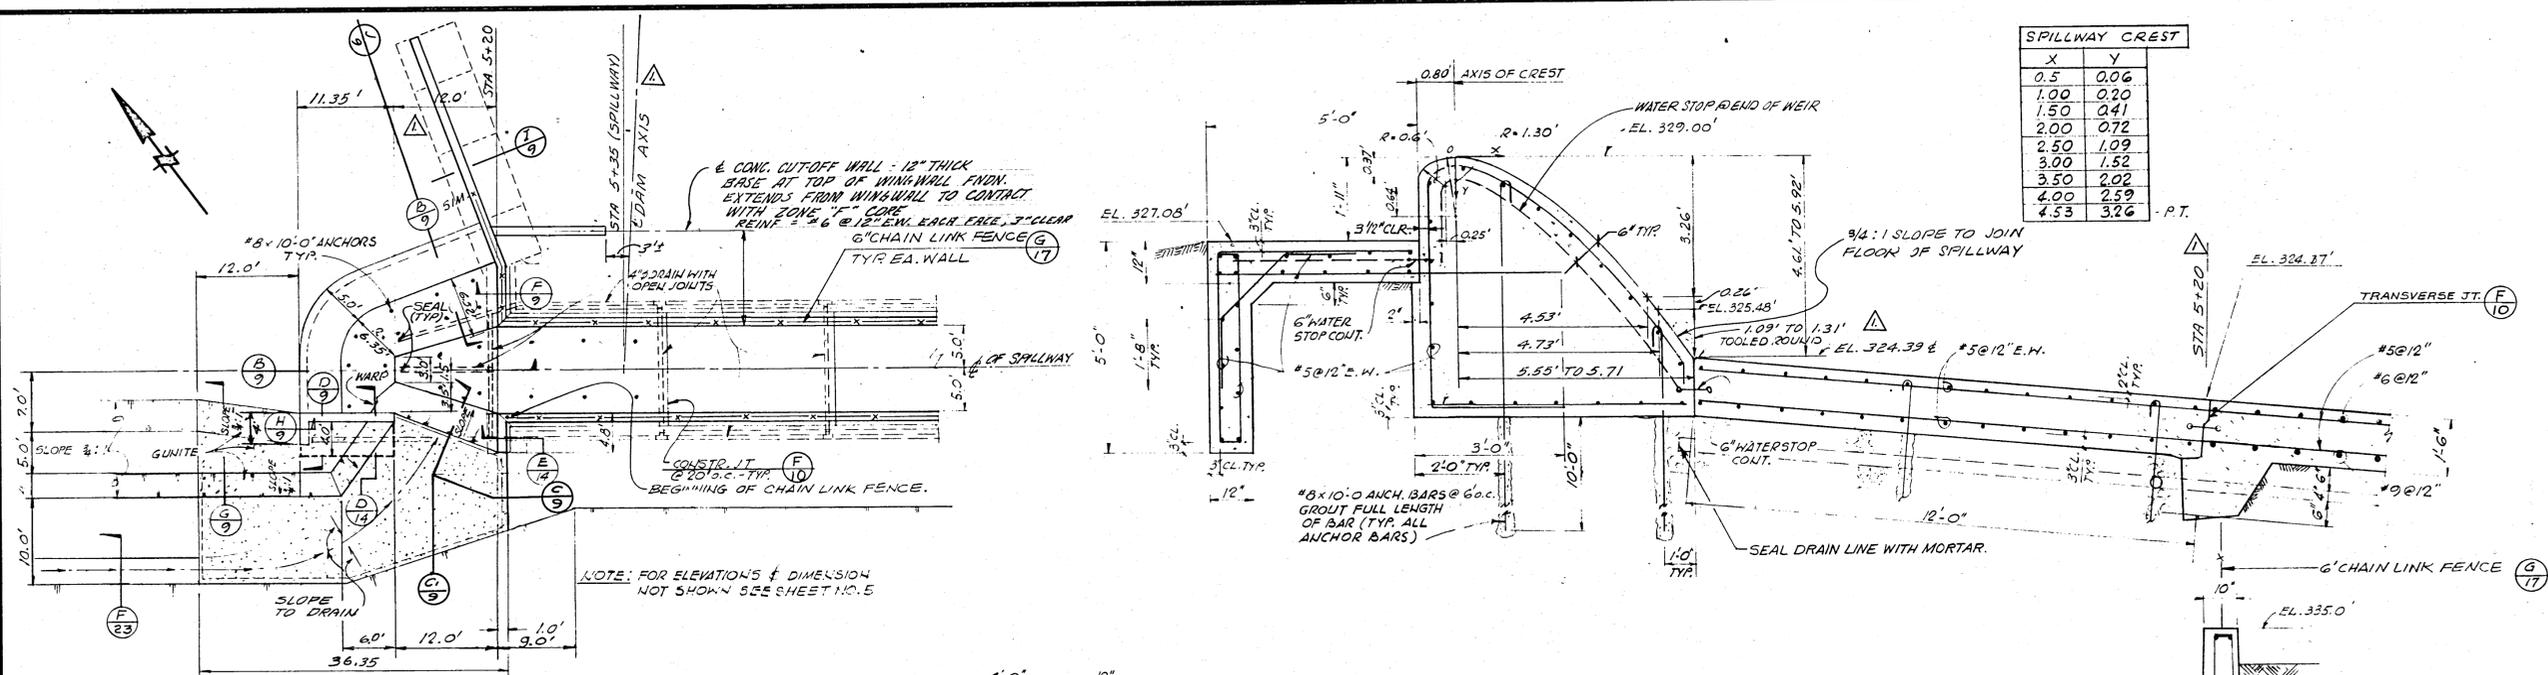

SPILLWAY CREST	
X	Y
0.5	0.06
1.00	0.20
1.50	0.41
2.00	0.72
2.50	1.09
3.00	1.52
3.50	2.02
4.00	2.59
4.53	3.26

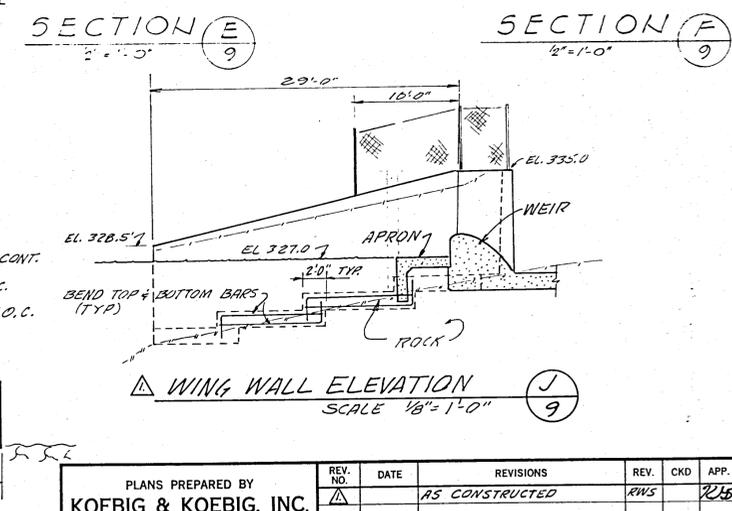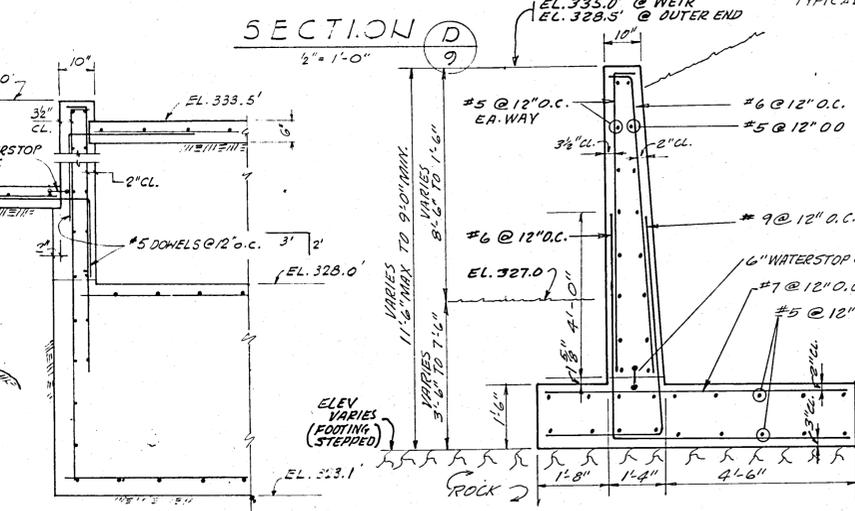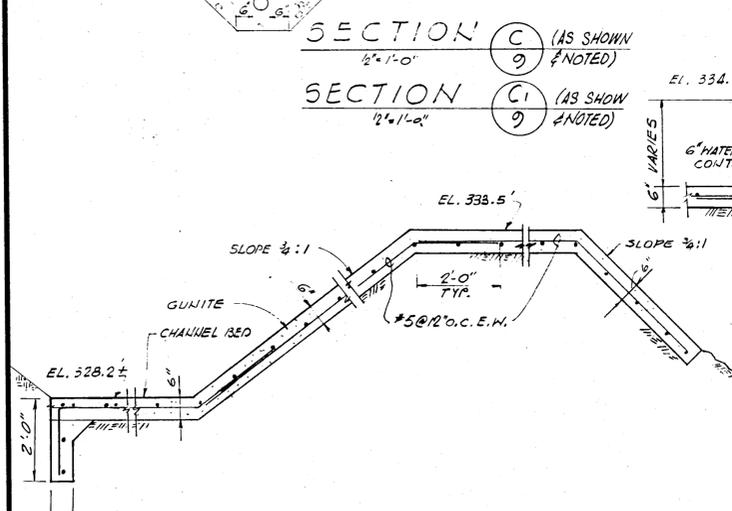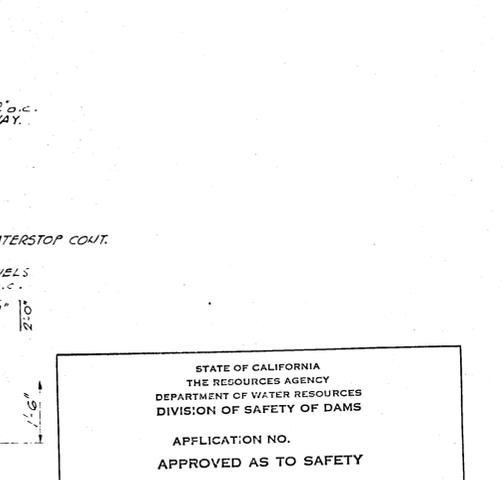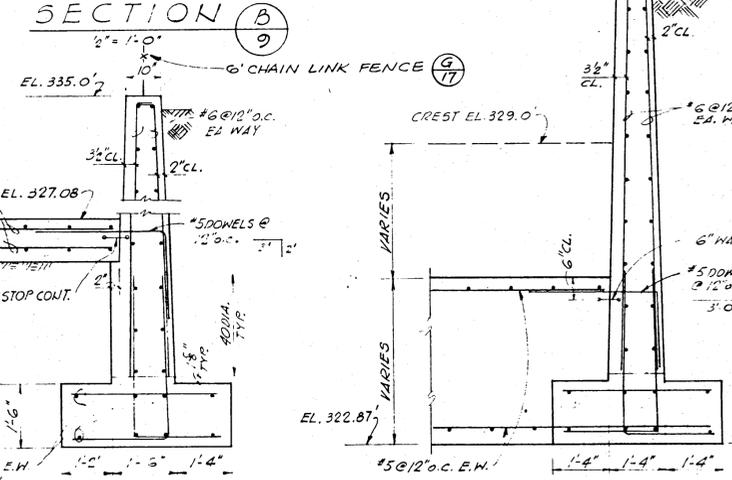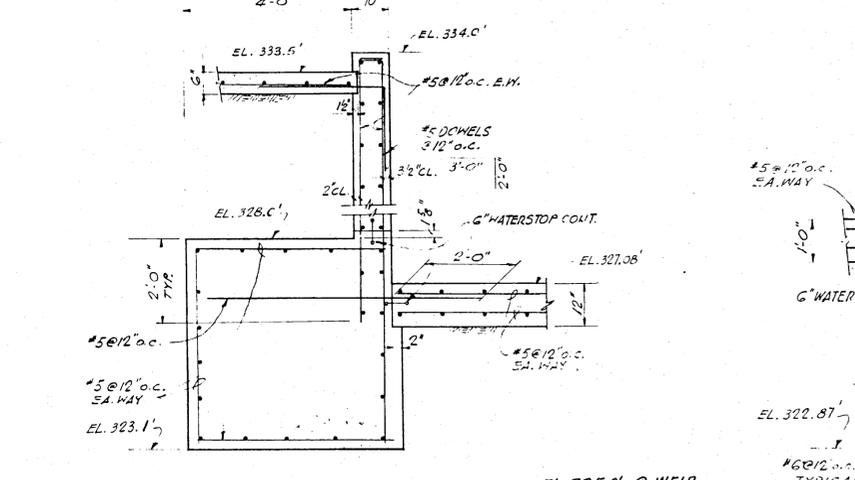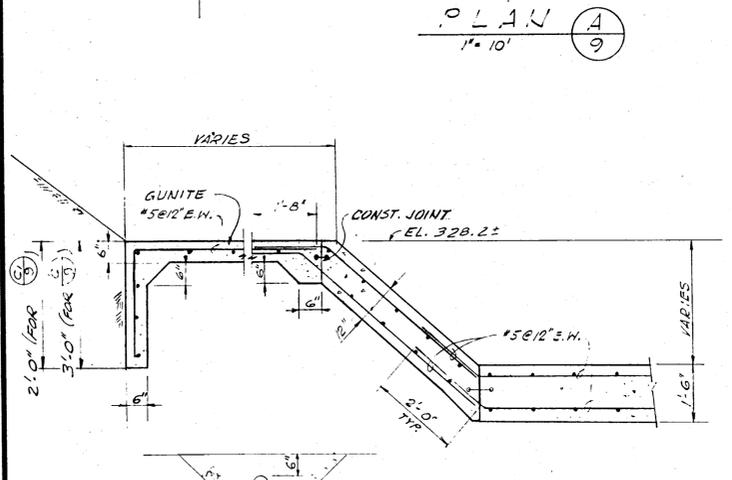

STATE OF CALIFORNIA
THE RESOURCES AGENCY
DEPARTMENT OF WATER RESOURCES
DIVISION OF SAFETY OF DAMS

APPLICATION NO. 1055-2
APPROVED AS TO SAFETY

NOV 16 1970

C. J. Coetzee
DIVISION ENGINEER, REG. C.E. NO. 7113

STATE OF CALIFORNIA
THE RESOURCES AGENCY
DEPARTMENT OF WATER RESOURCES
DIVISION OF SAFETY OF DAMS

APPLICATION NO. 1055-2
APPROVED AS TO SAFETY

MAY 22 1968

C. J. Coetzee
ACTIVE DIVISION ENGINEER, REG. C.E. NO. 7113

SAN LUIS OBISPO COUNTY FLOOD CONTROL AND WATER CONSERVATION DISTRICT

LOPEZ WATER SUPPLY PROJECT
TERMINAL DAM AND RESERVOIR


SPILLWAY INLET STRUCTURE
PLAN AND SECTIONS

DIVISION OF SAFETY OF DAMS
DEPARTMENT OF WATER RESOURCES
OCT 8 1970

REV. NO.	DATE	REVISIONS	REV.	CKD	APP.
1		AS CONSTRUCTED	RWS		RWS

PLANS PREPARED BY
KOEBIG & KOEBIG, INC.
ENGINEERING - ARCHITECTURE
PLANNING

DATE: May 9, 1968
BY: *L. L. ...*

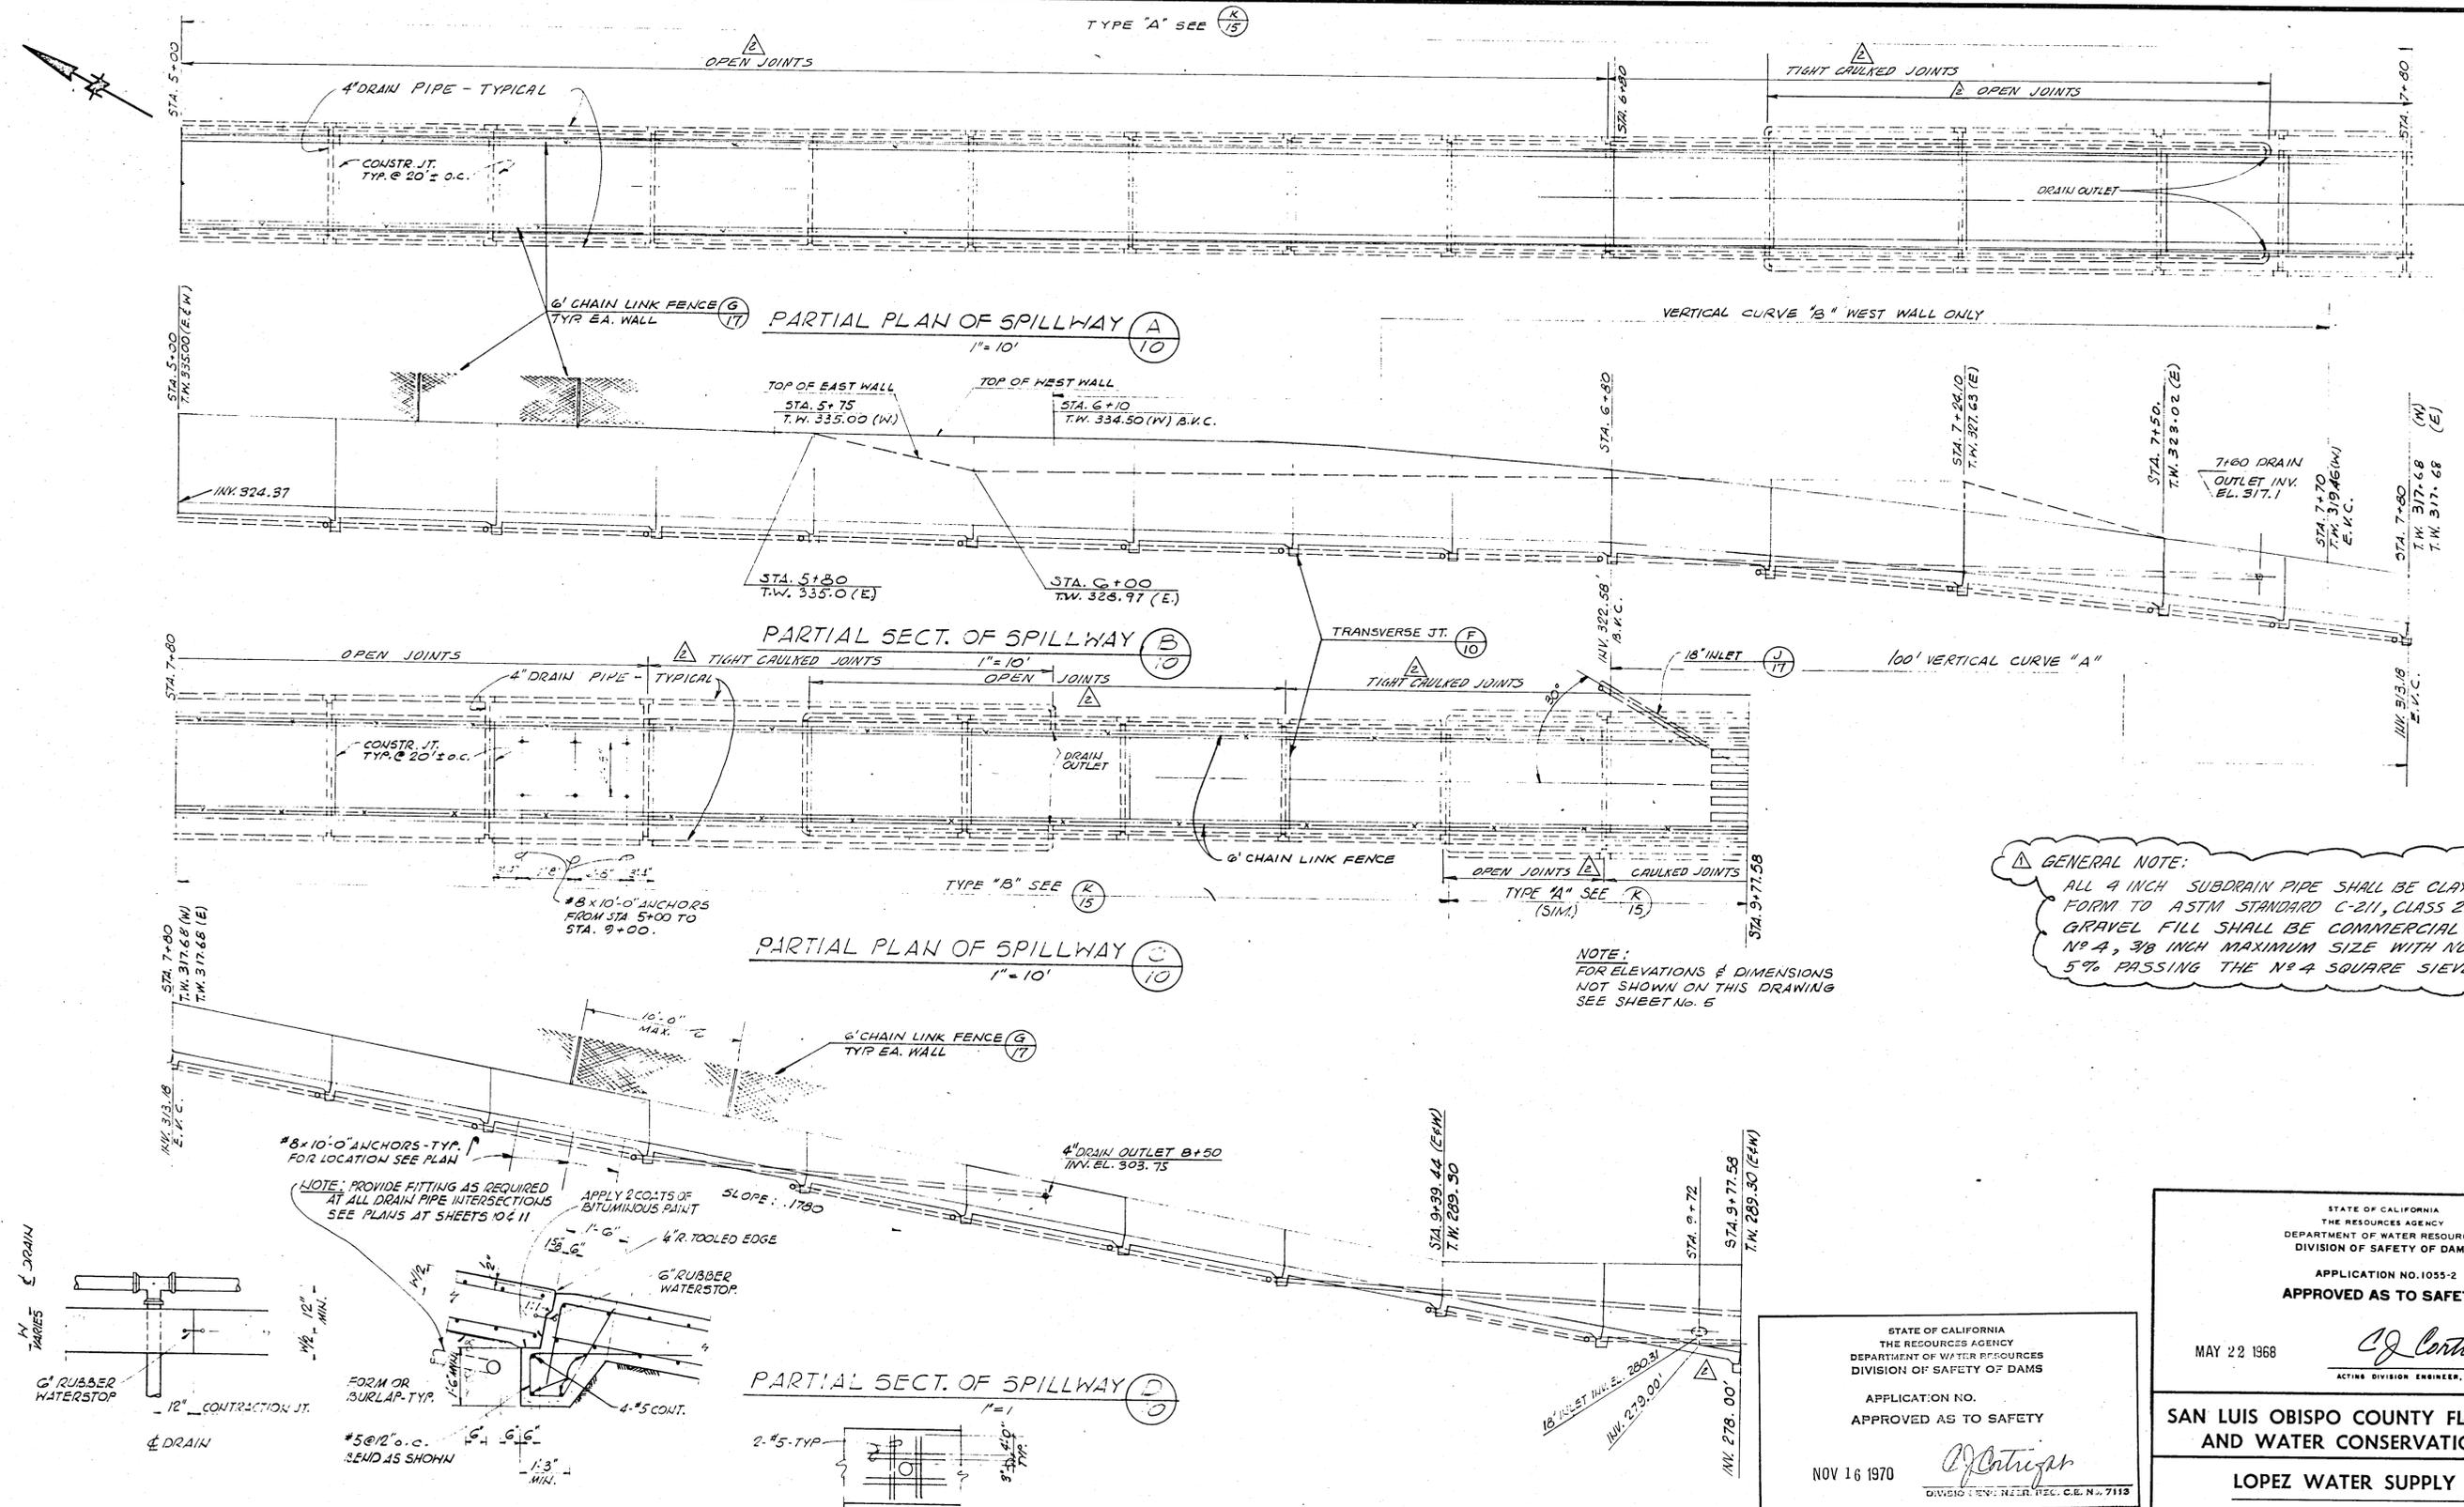

GENERAL NOTE:
ALL 4 INCH SUBDRAIN PIPE SHALL BE CLAY PIPE AND CONFORM TO ASTM STANDARD C-211, CLASS 2, UNGLAZED. GRAVEL FILL SHALL BE COMMERCIAL PEA GRAVEL NO. 4, 3/8 INCH MAXIMUM SIZE WITH NOT MORE THAN 5% PASSING THE NO. 4 SQUARE SIEVE.

TYP. WALL JOINT (E) 10

TYP. TRANSVERSE JT. (F) 10

TYP. ADD'L REINF. COPING (G) 10
N.T.S.

STATE OF CALIFORNIA
THE RESOURCES AGENCY
DEPARTMENT OF WATER RESOURCES
DIVISION OF SAFETY OF DAMS

APPLICATION NO. 1055-2
APPROVED AS TO SAFETY

NOV 16 1970

[Signature]
DIVISION ENGINEER REG. C.E. NO. 7119

STATE OF CALIFORNIA
THE RESOURCES AGENCY
DEPARTMENT OF WATER RESOURCES
DIVISION OF SAFETY OF DAMS

APPLICATION NO. 1055-2
APPROVED AS TO SAFETY

MAY 22 1968

[Signature]
ACTING DIVISION ENGINEER, REG. C.E. NO. 7119

SAN LUIS OBISPO COUNTY FLOOD CONTROL AND WATER CONSERVATION DISTRICT

LOPEZ WATER SUPPLY PROJECT

TERMINAL DAM AND RESERVOIR

SPILLWAY CHUTE PLAN
PROFILE AND DETAILS

DIVISION OF SAFETY OF DAMS
DEPARTMENT OF WATER RESOURCES
OCT 6 1970










RECOMMENDED *[Signature]* DATE 5-11-68
APPROVED *[Signature]* COUNTY HYDRAULIC ENGINEER DATE 5-11-68
DRAWN *[Signature]* TRACED *[Signature]* CHKD *[Signature]* DRWG SHEET 10 OF 23

PLANS PREPARED BY
KOEBIG & KOEBIG, INC.
ENGINEERING - ARCHITECTURE
PLANNING

DATE May 9, 1968
BY *[Signature]*

REV. NO.	DATE	REVISIONS	REV.	CKD	APP.
1	7-11-68	ADDENDUM NO. 2	RWS		KAT
2		AS CONSTRUCTED	RWS		KLS

STATE OF CALIFORNIA
THE RESOURCES AGENCY
DEPARTMENT OF WATER RESOURCES
DIVISION OF SAFETY OF DAMS
APPLICATION NO. 1055-2
APPROVED AS TO SAFETY
C. J. Contreras
DIVISION ENGINEER, REG. C.E. NO. 7113

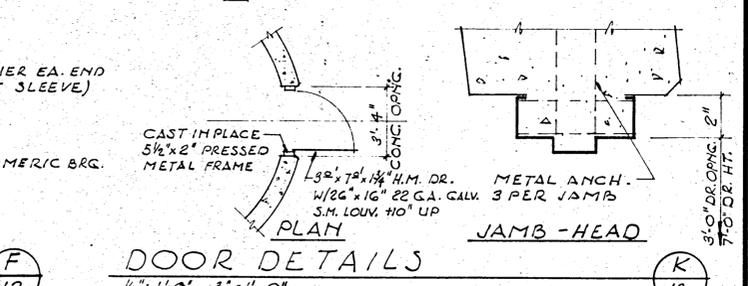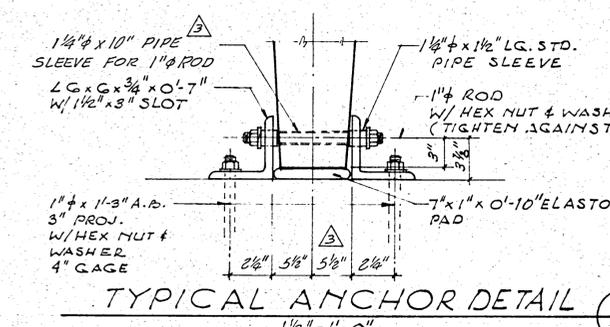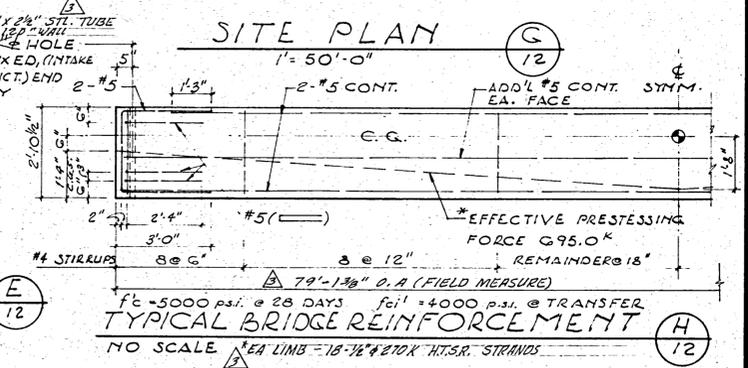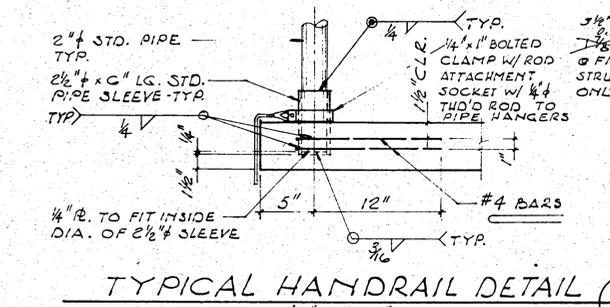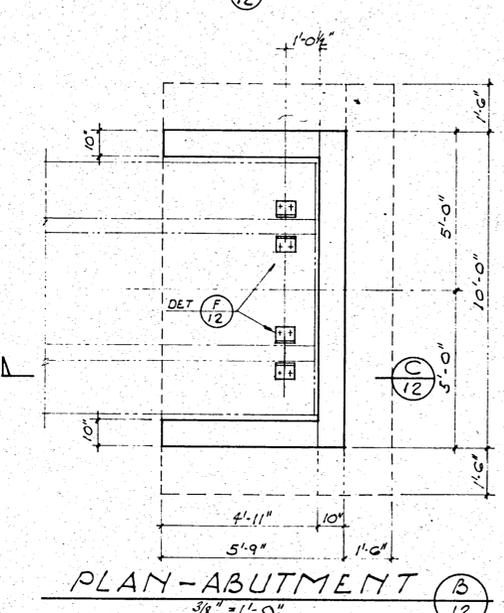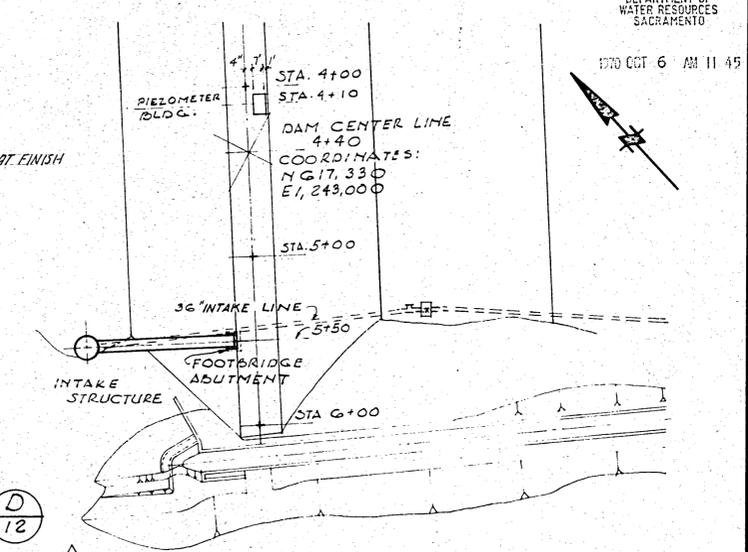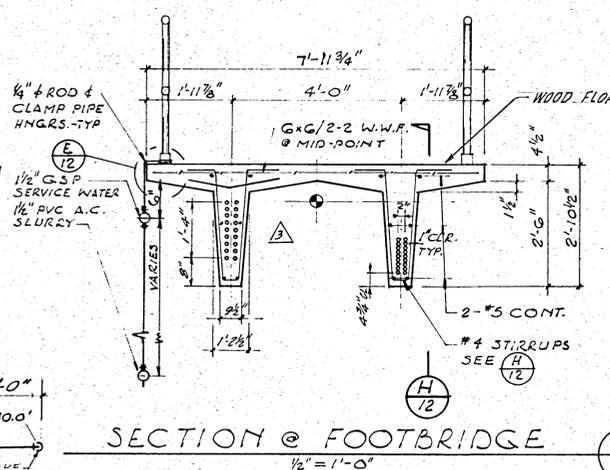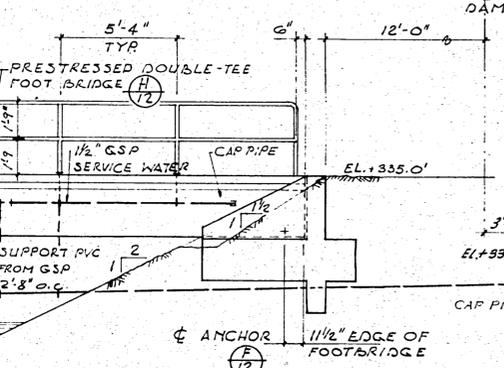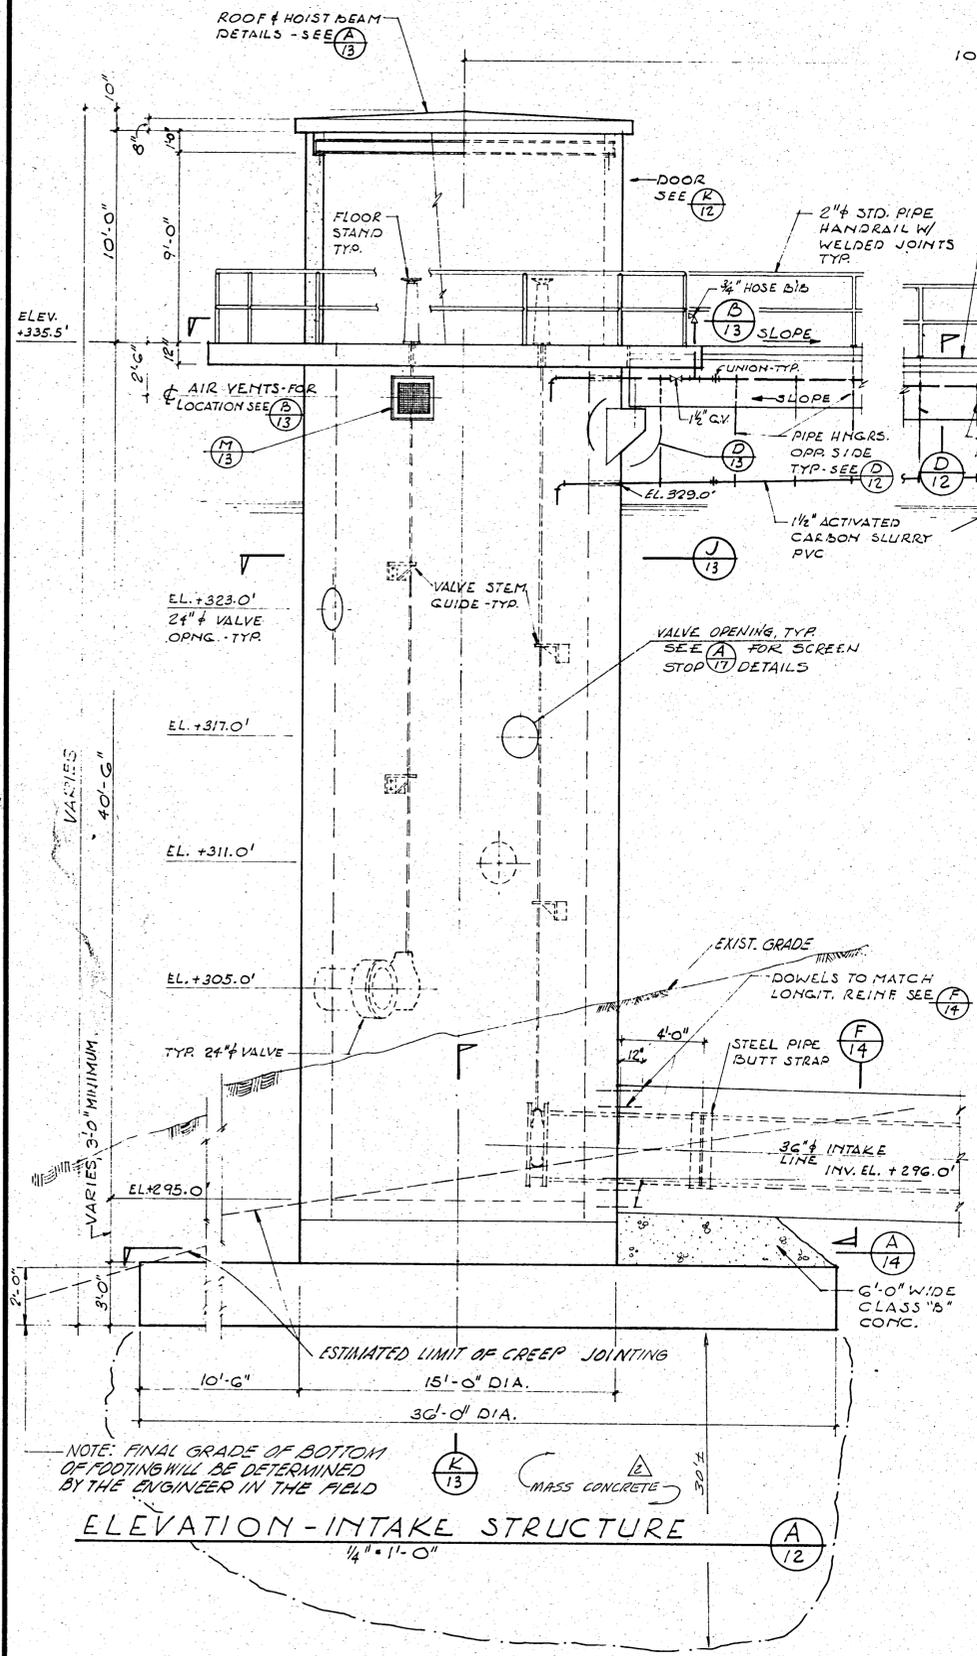

- EQUIPMENT NOTES:
1. VERIFY ALL RELATED STRUCTURAL, PIPING, ARCHITECTURAL AND ELECTRICAL WORKS AGAINST APPROVED MANUFACTURER'S EQUIPMENT DRAWINGS BEFORE PROCEEDING WITH EQUIPMENT AND PIPING WORK.
 2. ALL EQUIPMENT SHALL BE INSTALLED IN ACCORDANCE WITH THE MANUFACTURERS PRINTED RECOMMENDATIONS.
 3. OIL LINE CONNECTIONS TO BUTTERFLY VALVE GEAR REDUCER BOXES AND APPURTENANT SLEEVES, MOUNTINGS, AND RESERVOIRS ARE NOT SHOWN. SEE SPECIFICATIONS.

PLANS PREPARED BY
KOEBIG & KOEBIG, INC.
ENGINEERING - ARCHITECTURE
PLANNING
DATE May 9, 1968
BY *J. J. Taylor*


REV. NO.	DATE	REVISIONS	REV.	CKD	APP.
1	7-11-68	ADDENDUM NO 2	RWS		RWS
2		CHANGE ORDER NO 1 - 8/18/68	RWS		RWS
3		AS CONSTRUCTED	RWS		RWS

STATE OF CALIFORNIA
THE RESOURCES AGENCY
DEPARTMENT OF WATER RESOURCES
DIVISION OF SAFETY OF DAMS
APPLICATION NO. 1055-2
APPROVED AS TO SAFETY
MAY 22 1968
C. J. Contreras
ACTING DIVISION ENGINEER, REG. C.E. NO. 7113


SAN LUIS OBISPO COUNTY FLOOD CONTROL AND WATER CONSERVATION DISTRICT
LOPEZ WATER SUPPLY PROJECT
TERMINAL DAM AND RESERVOIR
INTAKE TOWER AND FOOTBRIDGE
PLANS, SECTIONS AND DETAILS

RECOMMENDED *Richard A. Pugh* 5-11-68
APPROVED *R. J. Bon* COUNTY HYDRAULIC ENGINEER 5-11-68
DRAWN BY *RWS* TRACED *RWS* CHKD *RWS* DRWG *RWS* SHEET 12 OF 23


1055-2
RECORD COPY

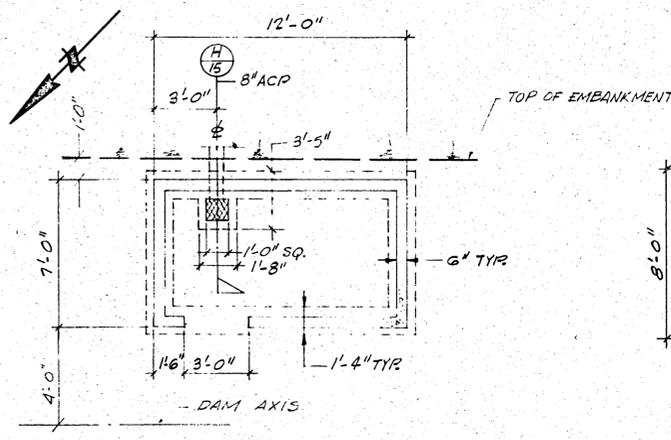


FOUNDATION & FLR. PLAN (A)
1/4" = 1'-0"

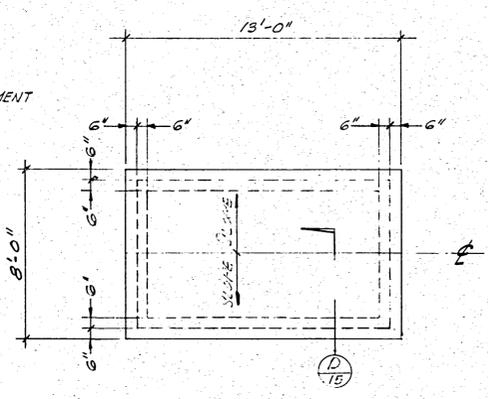


ROOF PLAN (B)
1/4" = 1'-0"

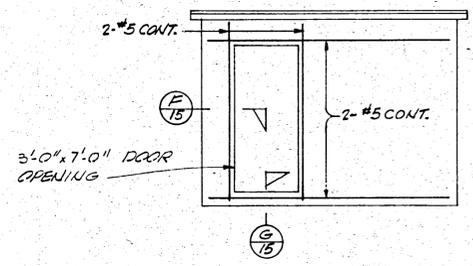


NORTH ELEVATION (C)
1/2" = 1'-0"

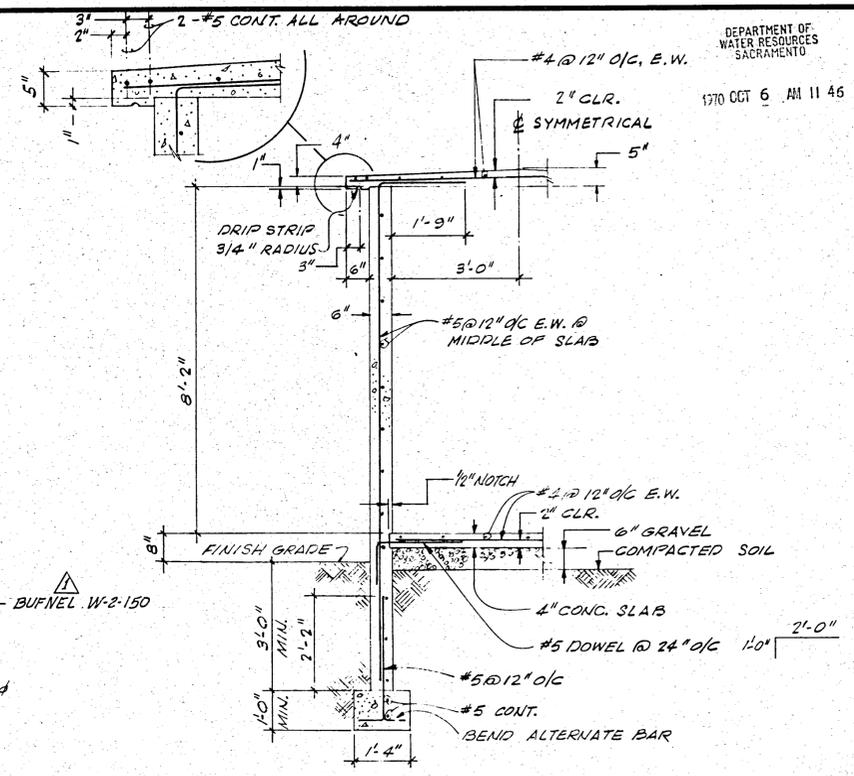


SECTION (D)
1/2" = 1'-0"

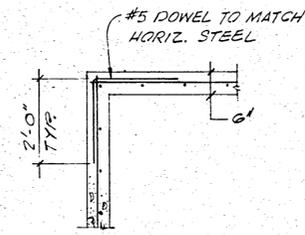


TYR CORNER DETAIL (E)
1/2" = 1'-0"

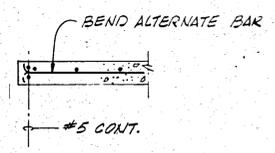


SECTION (F)
1/2" = 1'-0"

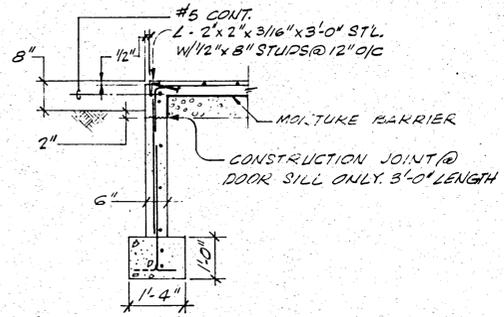


SECTION (G)
1/2" = 1'-0"

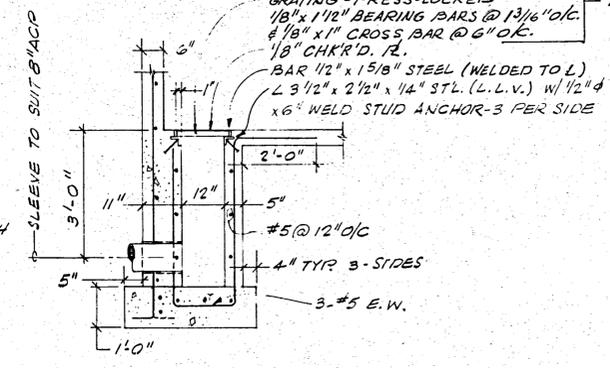


SECTION (H)
1/2" = 1'-0"

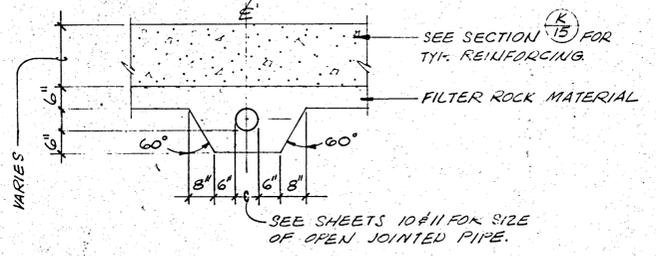

SECTION (J)
1/2" = 1'-0"

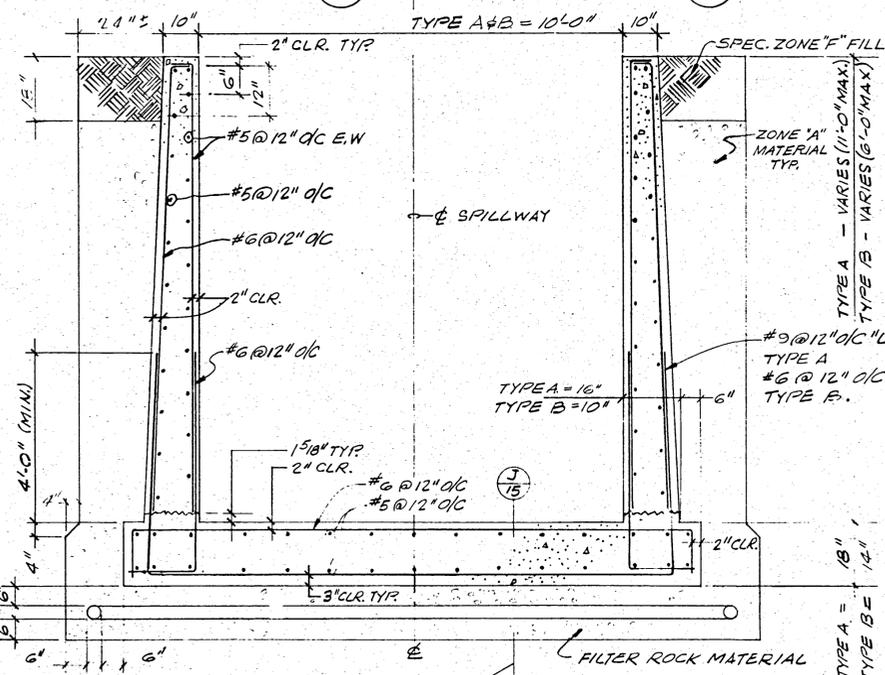

TYPE A & B - SECTION (K)
1/2" = 1'-0"

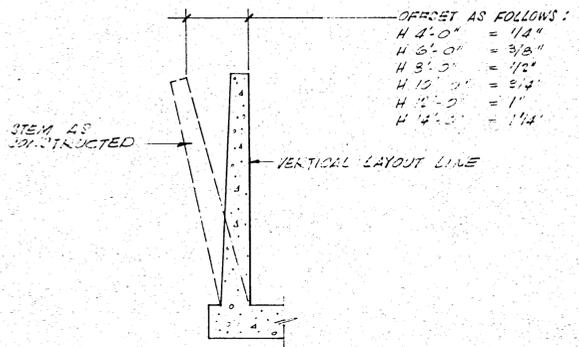

WALL OFFSET (L)
1/4" = 1'-0"

STATE OF CALIFORNIA
THE RESOURCES AGENCY
DEPARTMENT OF WATER RESOURCES
DIVISION OF SAFETY OF DAMS
APPLICATION NO. 1055-2
APPROVED AS TO SAFETY
NOV 16 1970
DIVISION ENGINEER, REG. C.E. NO. 7119





STATE OF CALIFORNIA
THE RESOURCES AGENCY
DEPARTMENT OF WATER RESOURCES
DIVISION OF SAFETY OF DAMS
APPLICATION NO. 1055-2
APPROVED AS TO SAFETY
MAY 22 1968
ACTIVE DIVISION ENGINEER, REG. C.E. NO. 7119

SAN LUIS OBISPO COUNTY FLOOD CONTROL AND WATER CONSERVATION DISTRICT
LOPEZ WATER SUPPLY PROJECT
TERMINAL DAM AND RESERVOIR
SPILLWAY AND CHANNEL SECTIONS
PIEZOMETER BUILDING DETAILS

PLANS PREPARED BY
KOEBIG & KOEBIG, INC.
ENGINEERING - ARCHITECTURE
PLANNING
DATE: May 9, 1965
BY: [Signature]

REV. NO.	DATE	REVISIONS	REV.	CKD	APP.
1		AS CONSTRUCTED	RWS		

RECOMMENDED: [Signature]
APPROVED: [Signature]
DRAWN: M.L. TRACED: [Signature] CHKD: [Signature] DRWG: [Signature] SHEET 15 OF 23

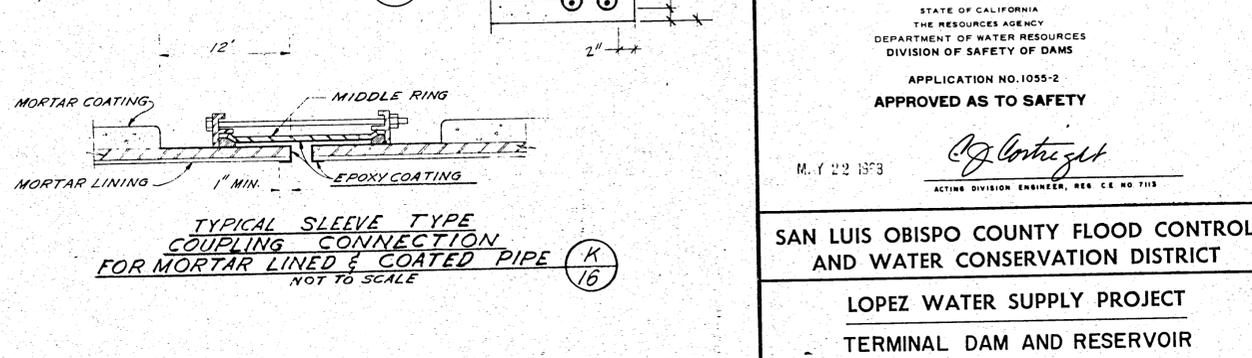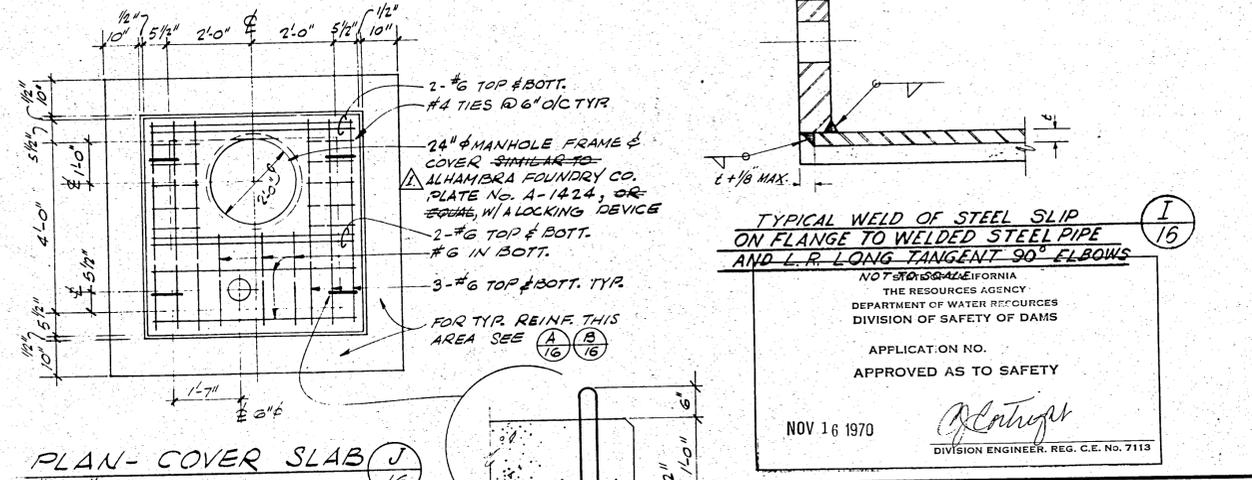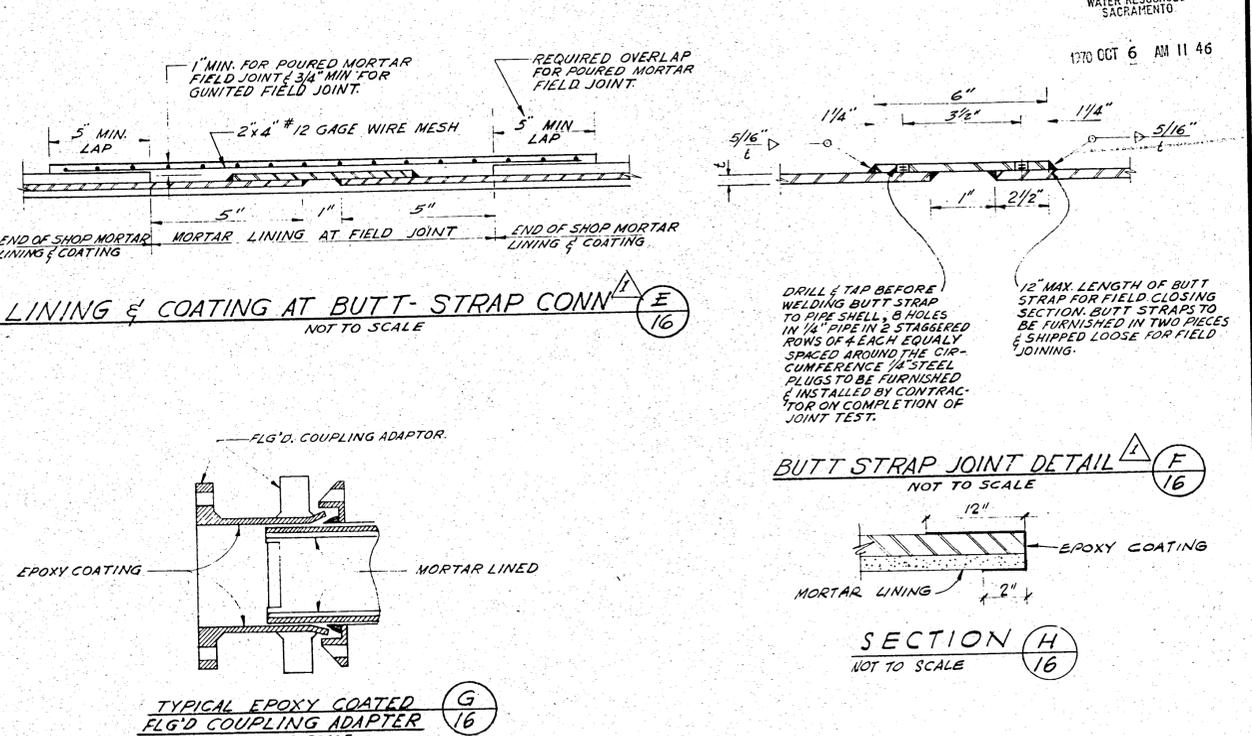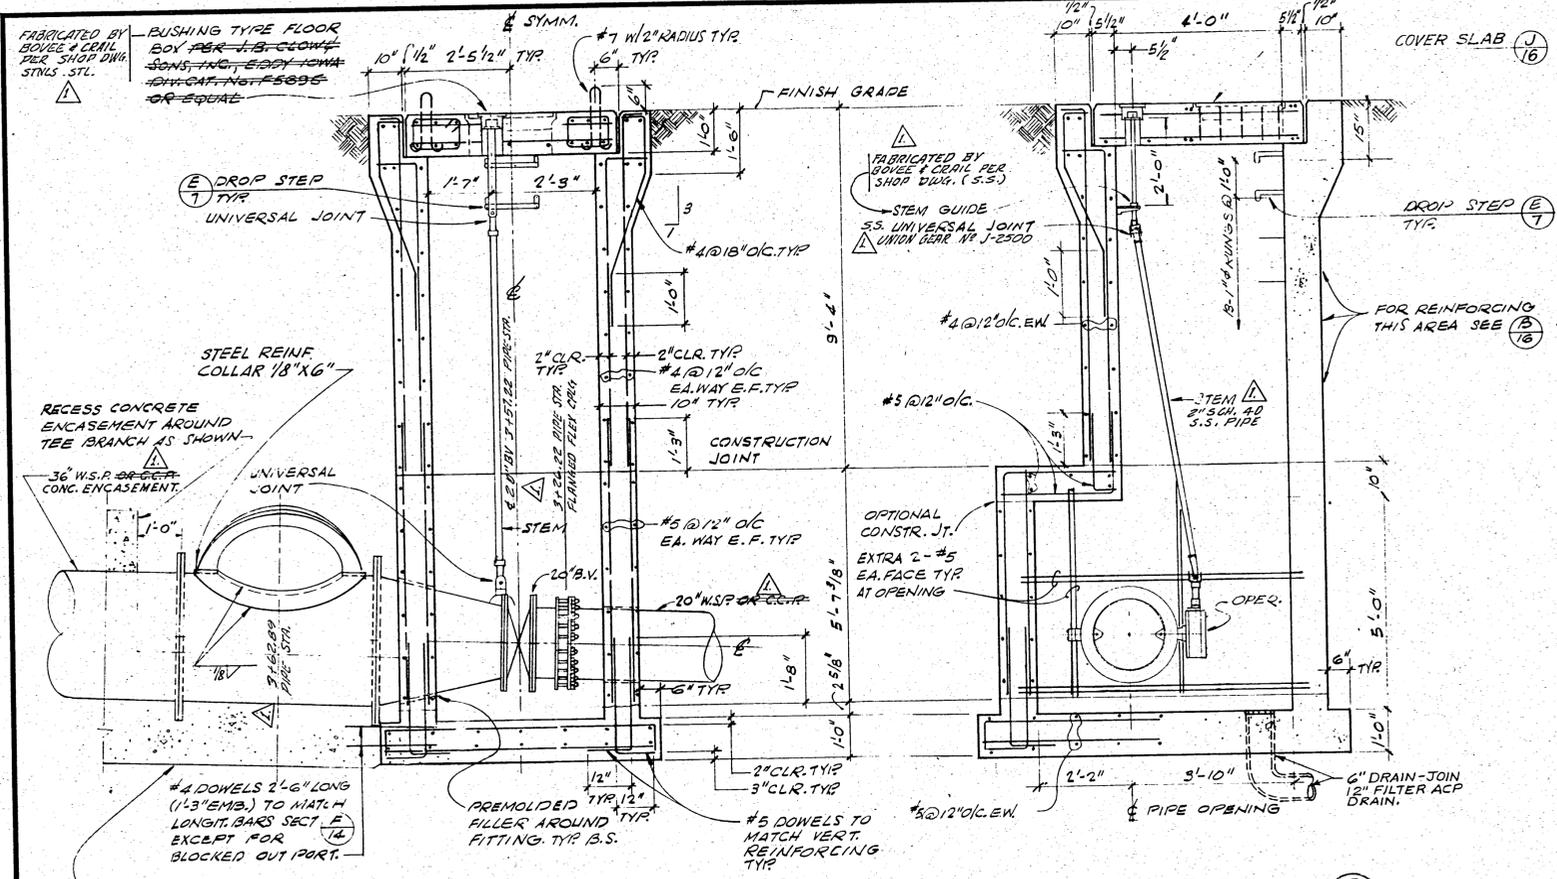

REV. NO.	DATE	REVISIONS	REV.	CHKD.	APP.
1	AS CONSTRUCTED		RWS	RWS	

PLANS PREPARED BY
KOEBIG & KOEBIG, INC.
ENGINEERING - ARCHITECTURE
PLANNING

DATE 5/9/68
BY Charles H. Lawrence
R.C.E. 9037

RECOMMENDED *Richard J. Decker* 5-11-68
APPROVED *R. J. Decker* COUNTY HYDRAULIC ENGINEER 5-11-68
DRAWN A.H.E. TRACED S.K. CHKD C.H.L. DRWG SHEET 16 OF 23

NOT FOR CALIFORNIA
THE RESOURCES AGENCY
DEPARTMENT OF WATER RESOURCES
DIVISION OF SAFETY OF DAMS

APPLICAT. NO. 1055-2
APPROVED AS TO SAFETY

NOV 16 1970

R. J. Decker
DIVISION ENGINEER, REG. C.E. NO. 7113

STATE OF CALIFORNIA
THE RESOURCES AGENCY
DEPARTMENT OF WATER RESOURCES
DIVISION OF SAFETY OF DAMS


APPLICAT. NO. 1055-2
APPROVED AS TO SAFETY

M. J. 22 1973


R. J. Decker
ACTING DIVISION ENGINEER, REG. C.E. NO. 7113

SAN LUIS OBISPO COUNTY FLOOD CONTROL AND WATER CONSERVATION DISTRICT


LOPEZ WATER SUPPLY PROJECT
TERMINAL DAM AND RESERVOIR
VALVE CHAMBER PLAN AND SECTION
MISCELLANEOUS DETAILS.

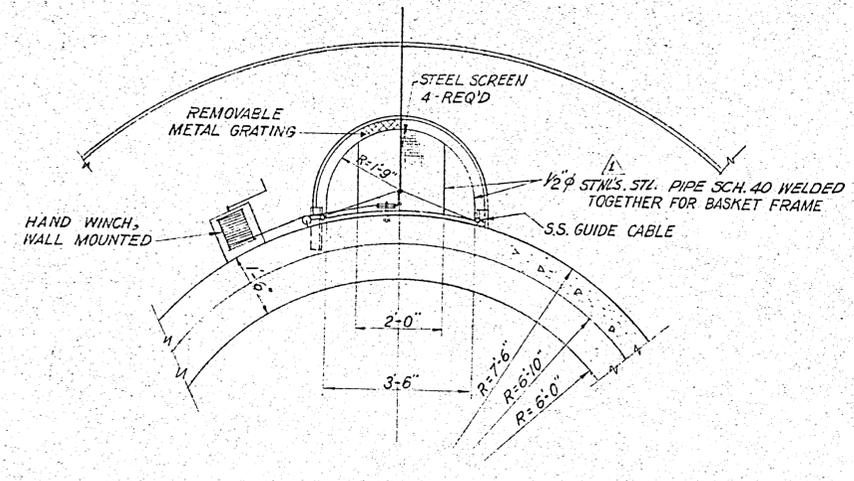

TYPICAL BASKET SCREEN PLAN (A) SCALE: 1/2" = 1'-0"

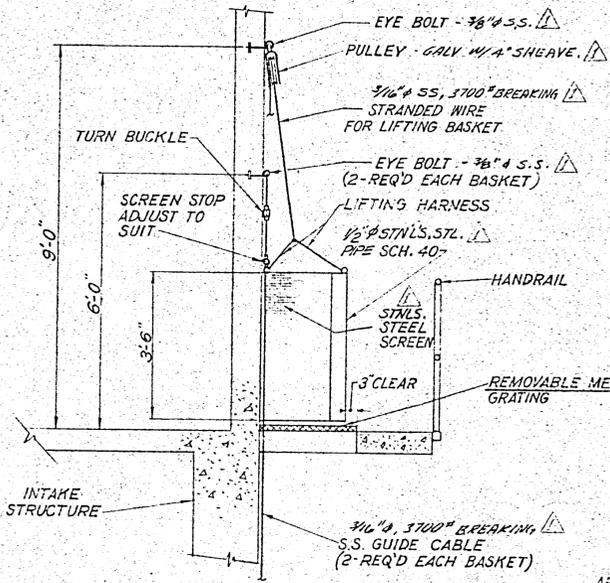


BASKET SCREEN SECTION (E) SCALE: 1/2" = 1'-0"

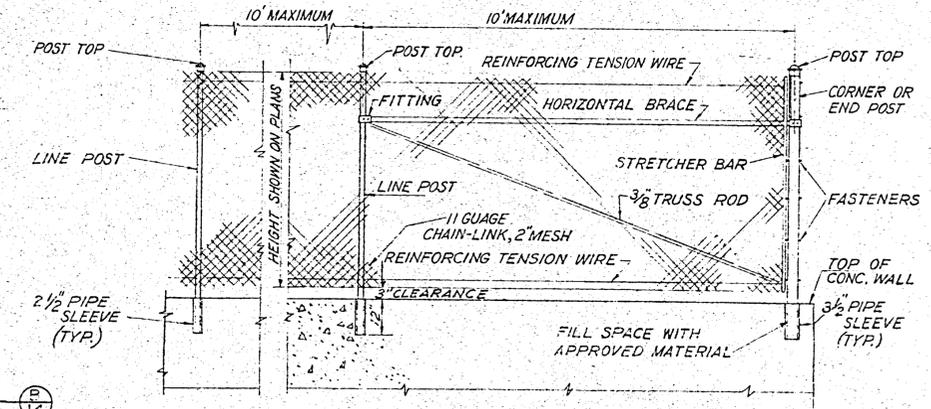


CHAIN LINK FENCE (G) SCALE: 1/2" = 1'-0"


NOTE: WHERE INDICATED ON THE PLANS INSTALL BARB WIRE ON FENCE PER (H)

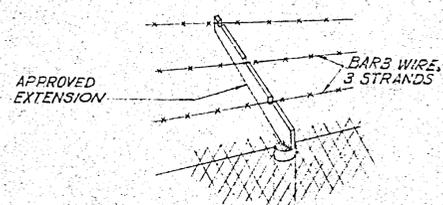

BARB WIRE DETAIL (H) NO SCALE

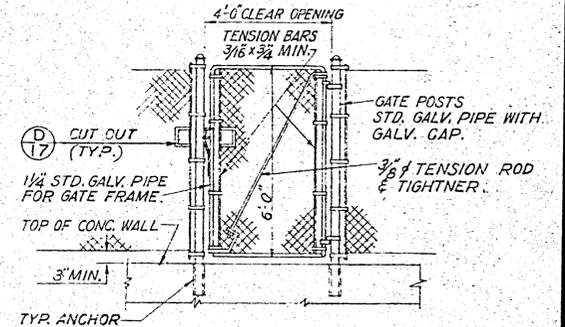


GATE DETAIL (I) SCALE: 3/8" = 1'-0"

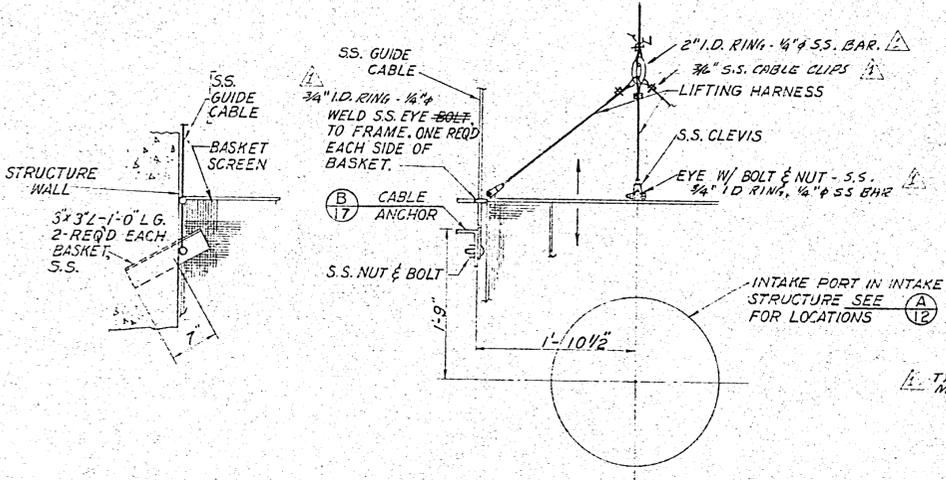


GUIDE CABLE ANCHOR DETAIL (B) NO SCALE

BASKET SCREEN DETAIL (C) SCALE: 1" = 1'-0"

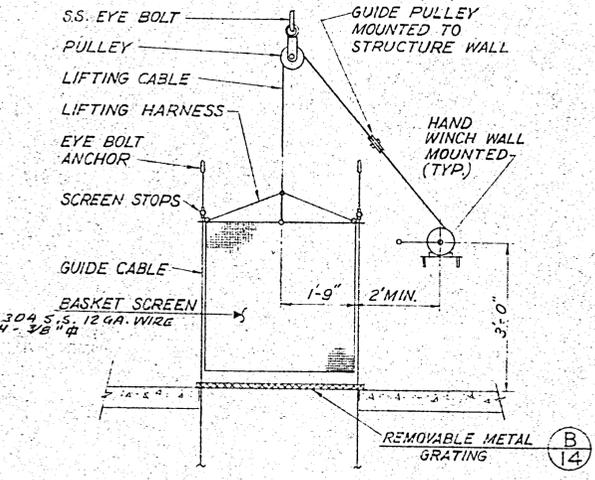


BASKET SCREEN ELEVATION (F) SCALE: 1/2" = 1'-0"

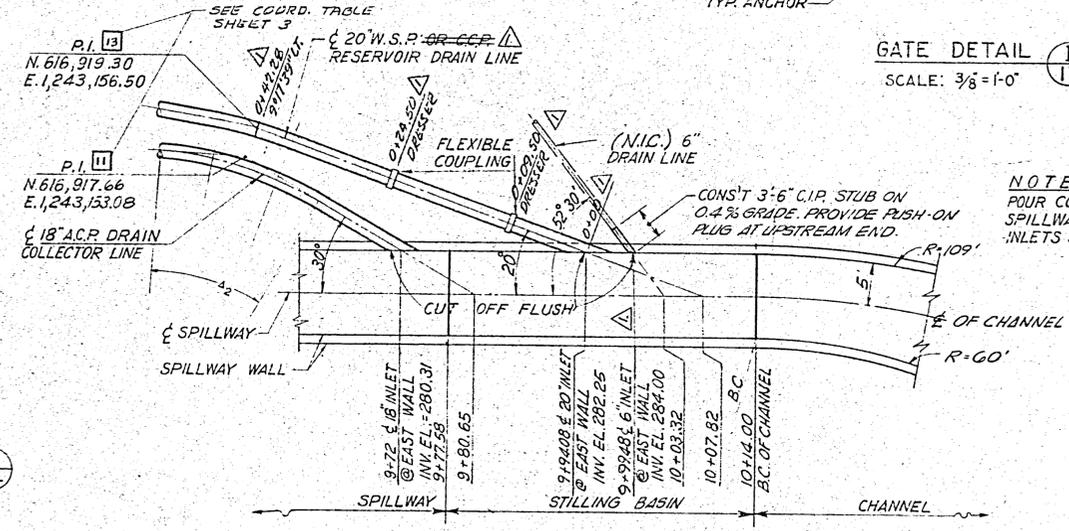

SPILLWAY INLETS DETAIL (J) SCALE: 1" = 10'

NOTE: FOUR CONC. WALLS OF SPILLWAY AROUND PIPE INLETS SHOWN IN THIS DETAIL.

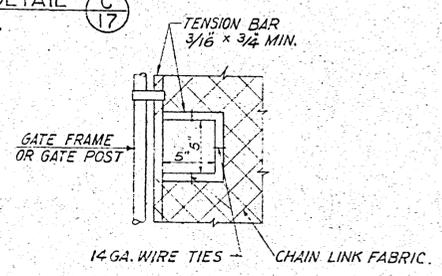

FENCE CUT OUT DETAIL (D) NO SCALE

REV. NO.	DATE	REVISIONS	REV.	CKD	APP.
1		AS CONSTRUCTED	RMS		XDR

PLANS PREPARED BY
KOEBIG & KOEBIG, INC.
ENGINEERING - ARCHITECTURE
PLANNING

DATE 5/9/68
BY *Charles H. Lawrence*
R.C.E. 9037


SAN LUIS OBISPO COUNTY FLOOD CONTROL AND WATER CONSERVATION DISTRICT

LOPEZ WATER SUPPLY PROJECT


TERMINAL DAM AND RESERVOIR

BASKET SCREEN PLAN AND DETAILS.
FENCE DETAILS.

RECOMMENDED *Richard A. Lawrence* DATE 5-11-68
APPROVED *Ed. Barr* COUNTY HYDRAULIC ENGINEER DATE 5-11-68
DRAWN *A.H.E.* TRACED *S.K.* CHKD *C.H.L.* DRWG SHEET 17 OF 23

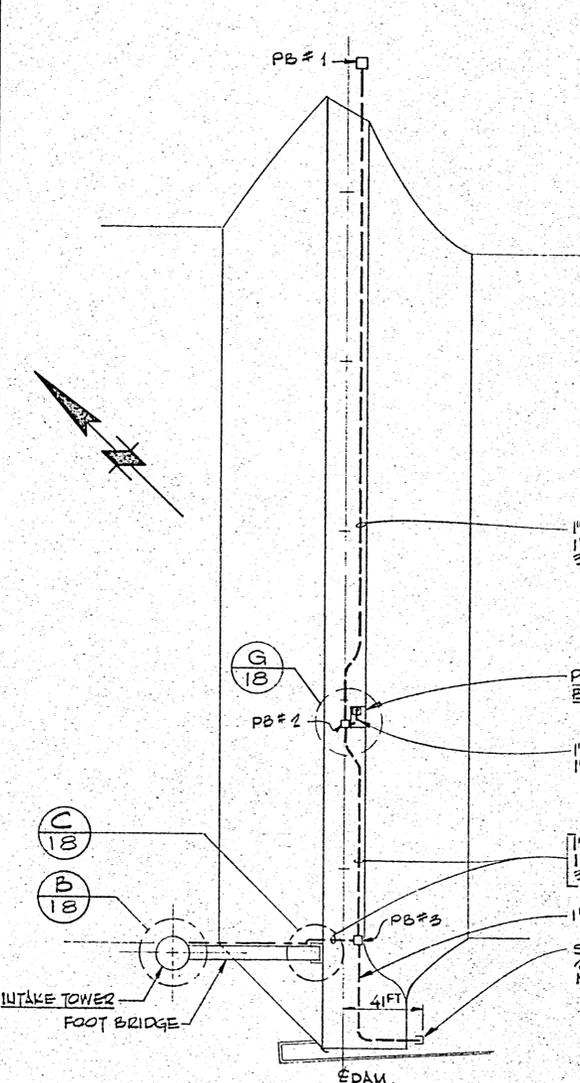


PLOT PLAN
1" = 50'
A 18

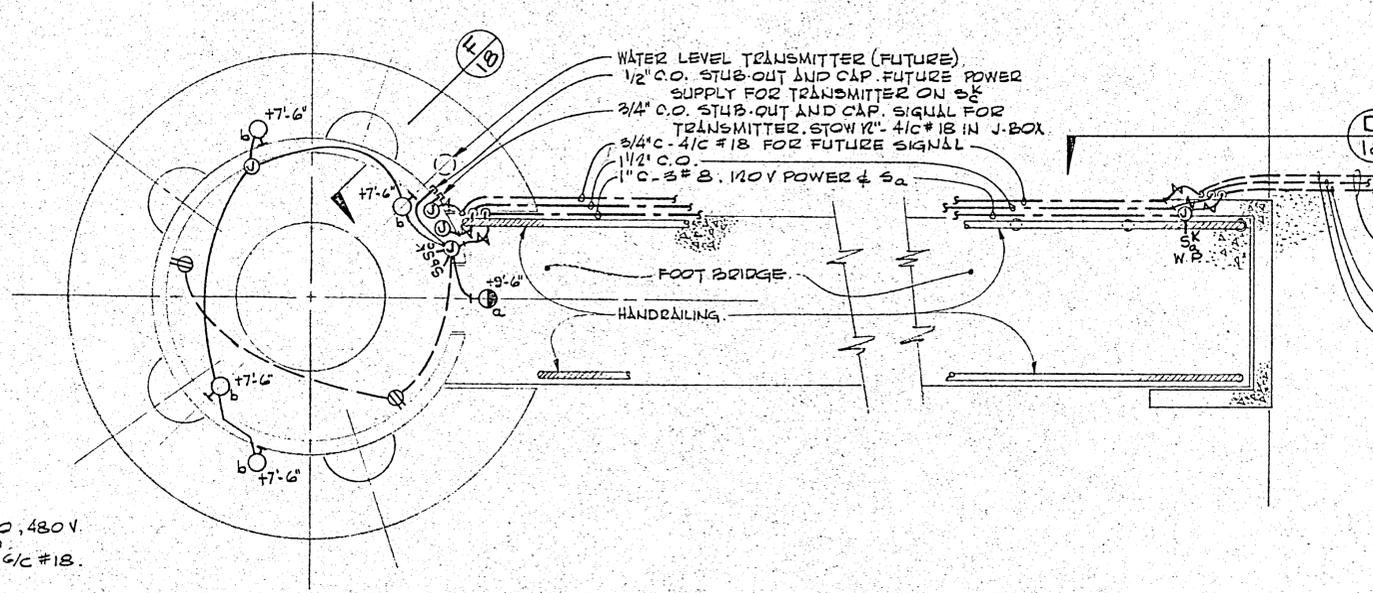

LIGHTING & POWER PLAN
INTAKE TOWER
SCALE: 1/4" = 1'-0"
B 18


PARTIAL PLAN
1/4" = 1'-0"
C 18

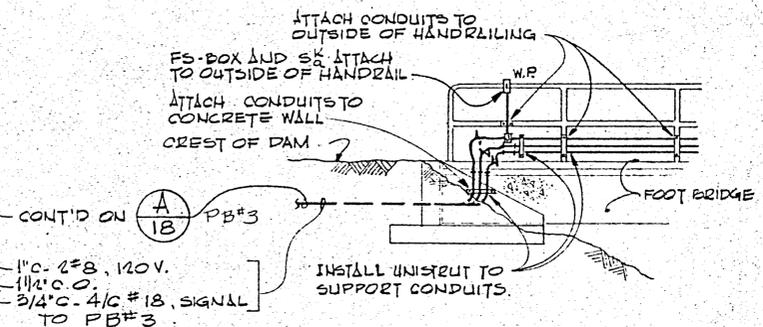


ELEVATION
1/4" = 1'-0"
D 18

LEGEND


SYMBOL	DESCRIPTION
---	CONDUIT RUN ABOVE GRADE, CONCEAL WHERE POSSIBLE SIZE AND NUMBER OF WIRES IS NOTED
---	CONDUIT RUN BELOW GRADE OR IN FLOOR SIZE AND NUMBER OF WIRES IS NOTED
---	CONDUIT RUN EXPOSED. SIZE AND NUMBER OF WIRES IS NOTED
○	INCANDESCENT, WALL MOUNTED FIXTURE W/150 WATT LAMP, INSIDE FROSTED A. MARCO CAT # B-201 VTG B. MC. PHILBEN CAT # 43-34 VT. C. MOLDCAST CAT # 2050
⊙	MERCURY VAPOR, WALL MOUNTED FIXTURE W/100 WATT COLOR IMPROVED MERCURY LAMP A. HOLOPHANE CAT # 410-120 CG. B. MC. PHILBEN CAT # 7-15 C. MARCO CAT # B-306
↗	FLEXIBLE CONDUIT, WEATHER PROOF.
SK	SINGLE POLE TOGGLE SWITCH + 4'-6"
⊕	INDICATES SWITCH DESIGNATION. K INDICATES KEY OPERATED
⊙	JUNCTION BOX
⊞	TRANSFORMER
⊕	15 AMP, 3-WIRE, GROUNDING TYPE, CONVENIENCE OUTLET + 12"
□	PULL BOX, PRECAST CONCRETE WITH BARRIER (2'x3'x3')
C.O.	CONDUIT ONLY
W.P.	WEATHER PROOF

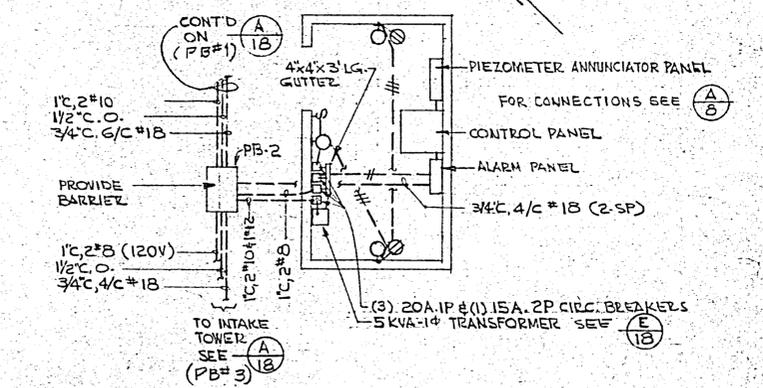

PIEZOMETER BLDG. DETAIL
1/4" = 1'-0"
G 18

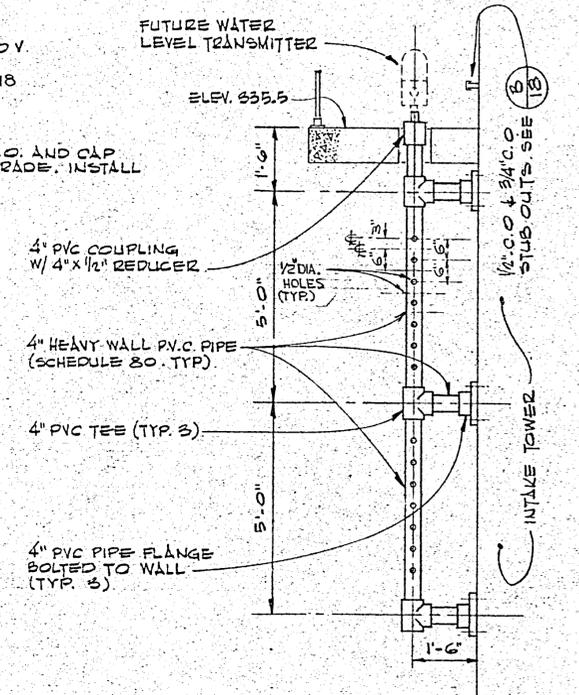

ELEVATION
1/4" = 1'-0"
F 18

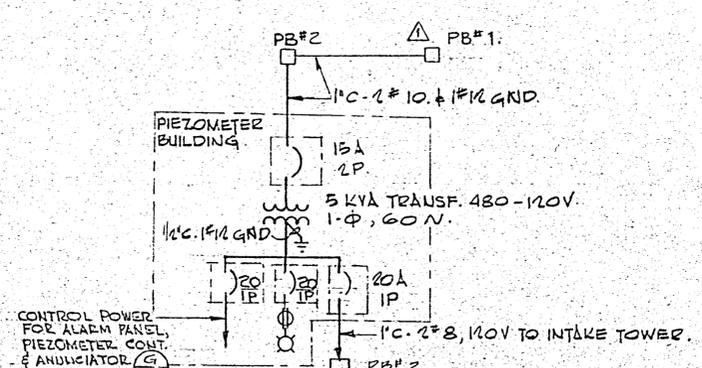

SINGLE LINE DIAGRAM
NO SCALE
E 18



PLANS PREPARED BY
KOEBIG & KOEBIG, INC.
ENGINEERING - ARCHITECTURE
PLANNING
DATE: *May 9, 1968*
BY: *John P. Koebig*

REV. NO.	DATE	REVISIONS	REV.	CKD	APP.
		AS CONSTRUCTED	EWS		<i>RBK</i>

SAN LUIS OBISPO COUNTY FLOOD CONTROL AND WATER CONSERVATION DISTRICT

LOPEZ WATER SUPPLY PROJECT

TERMINAL DAM AND RESERVOIR

ELECTRICAL PLAN AND DETAILS

RECOMMENDED BY: *Richard A. Blalock* COUNTY HYDRAULIC ENGINEER
APPROVED BY: *John P. Koebig* ENGINEER
DRAWN: H.J.T. TRACED: H.J.T. CHKD: W.A. DRWG: SHEET 18 OF 23

DIVISION OF
SAFETY OF DAMS
DEPARTMENT OF
WATER RESOURCES
OCT 6 - 1970

GEOLOGICAL NOTES:

- Qpr = PASO ROBLES FORMATION
 - Tmmch = MONTEREY FORMATION
(cherty shales)
 - Tppm₂ = PISMO FORMATION
(Miguelito member)
- = contact between rock units



DIVISION OF
SAFETY OF DAMS
DEPARTMENT OF
WATER RESOURCES
OCT 6 1970

**SAN LUIS OBISPO COUNTY FLOOD CONTROL
AND WATER CONSERVATION DISTRICT**

LOPEZ WATER SUPPLY PROJECT

TERMINAL DAM AND RESERVOIR

PERIMETER CHANNEL

STA. 0+25 TO STA. 35+00

PLANS PREPARED BY
KOEBIG & KOEBIG, INC.
ENGINEERING - ARCHITECTURE
PLANNING

DATE 5-10-68
BY R. B. Thompson
R. E. (1965)





REV. NO.	DATE	REVISIONS	REV.	CKD	APP.
1		AS CONSTRUCTED	EWS		W.R.

RECOMMENDED Richard A. Strahan COUNTY HYDRAULIC ENGINEER DATE 5-11-68
APPROVED R. E. (1965) R. C. E. NO. 9414 DATE 5-11-68

DRAWN ST TRACED A.R. CHKD ORWG SHEET 19 OF 23

1055-2

RECORD
COPY

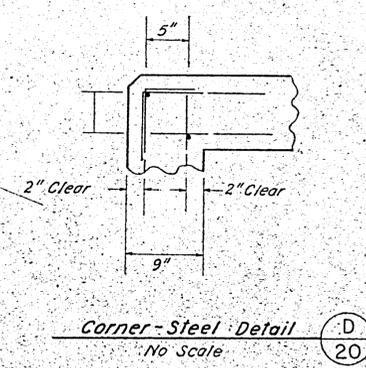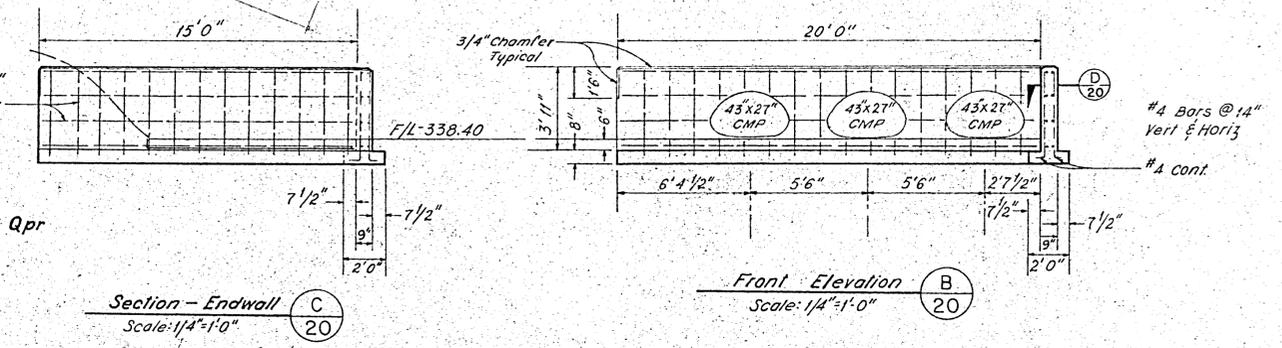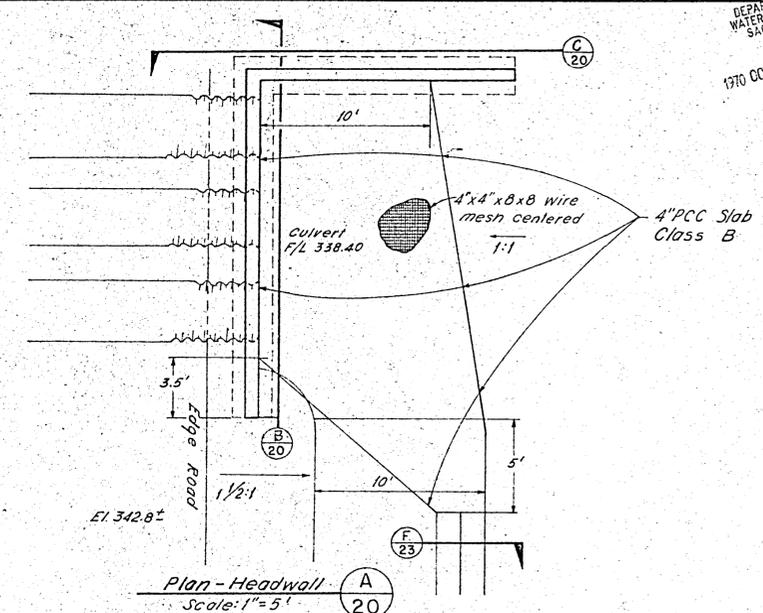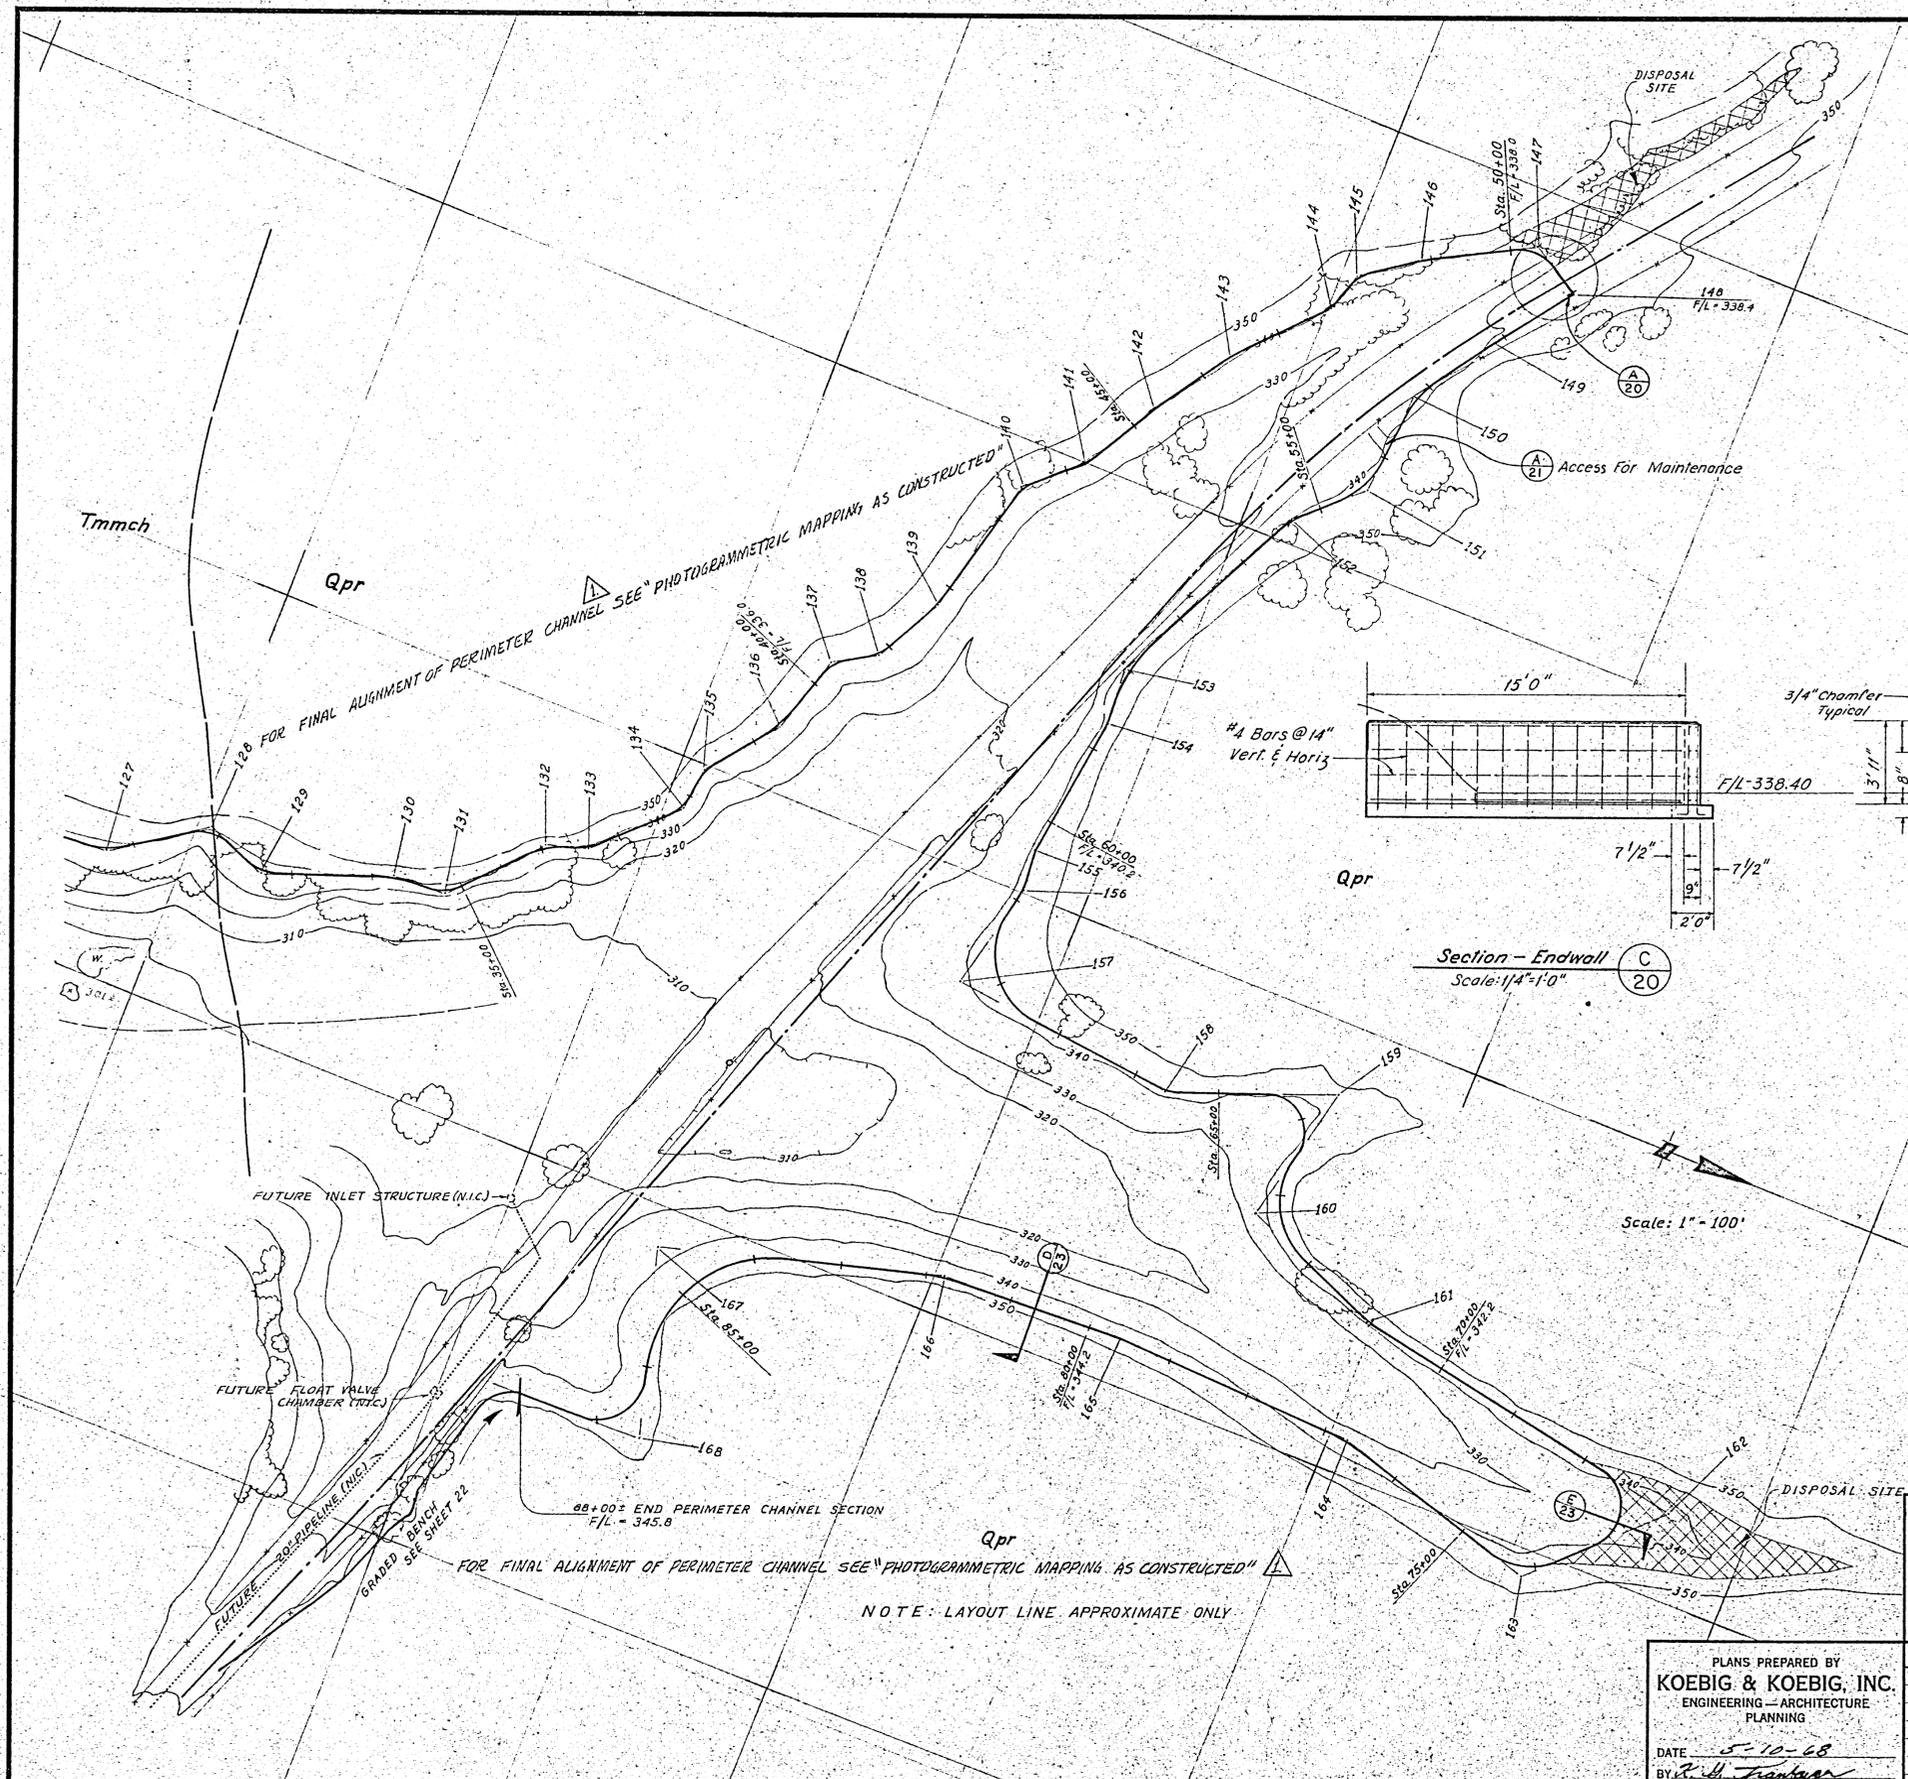


APPROVAL - RECOMMENDED
BY: *R. H. Frank*
ASSISTANT ROAD COMMISSIONER
APPROVED: *Gene C. Peterson*
COUNTY ROAD COMMISSIONER AND SURVEYOR

SAN LUIS OBISPO COUNTY FLOOD CONTROL AND WATER CONSERVATION DISTRICT
LOPEZ WATER SUPPLY PROJECT
TERMINAL DAM AND RESERVOIR
PERIMETER CHANNEL
STA. 35+00 TO STA. 88+00


PLANS PREPARED BY
KOEBIG & KOEBIG, INC.
ENGINEERING - ARCHITECTURE
PLANNING
DATE: 5-10-68
BY: *R. H. Frank*

REV. NO.	DATE	REVISIONS	REV.	CKD	APP.
1		AS CONSTRUCTED			

RECOMMENDED: *Richard A. ...*
APPROVED: *...*
DRAWN: ST TRACED: AR CHKD: DRWG: SHEET 20 OF 23

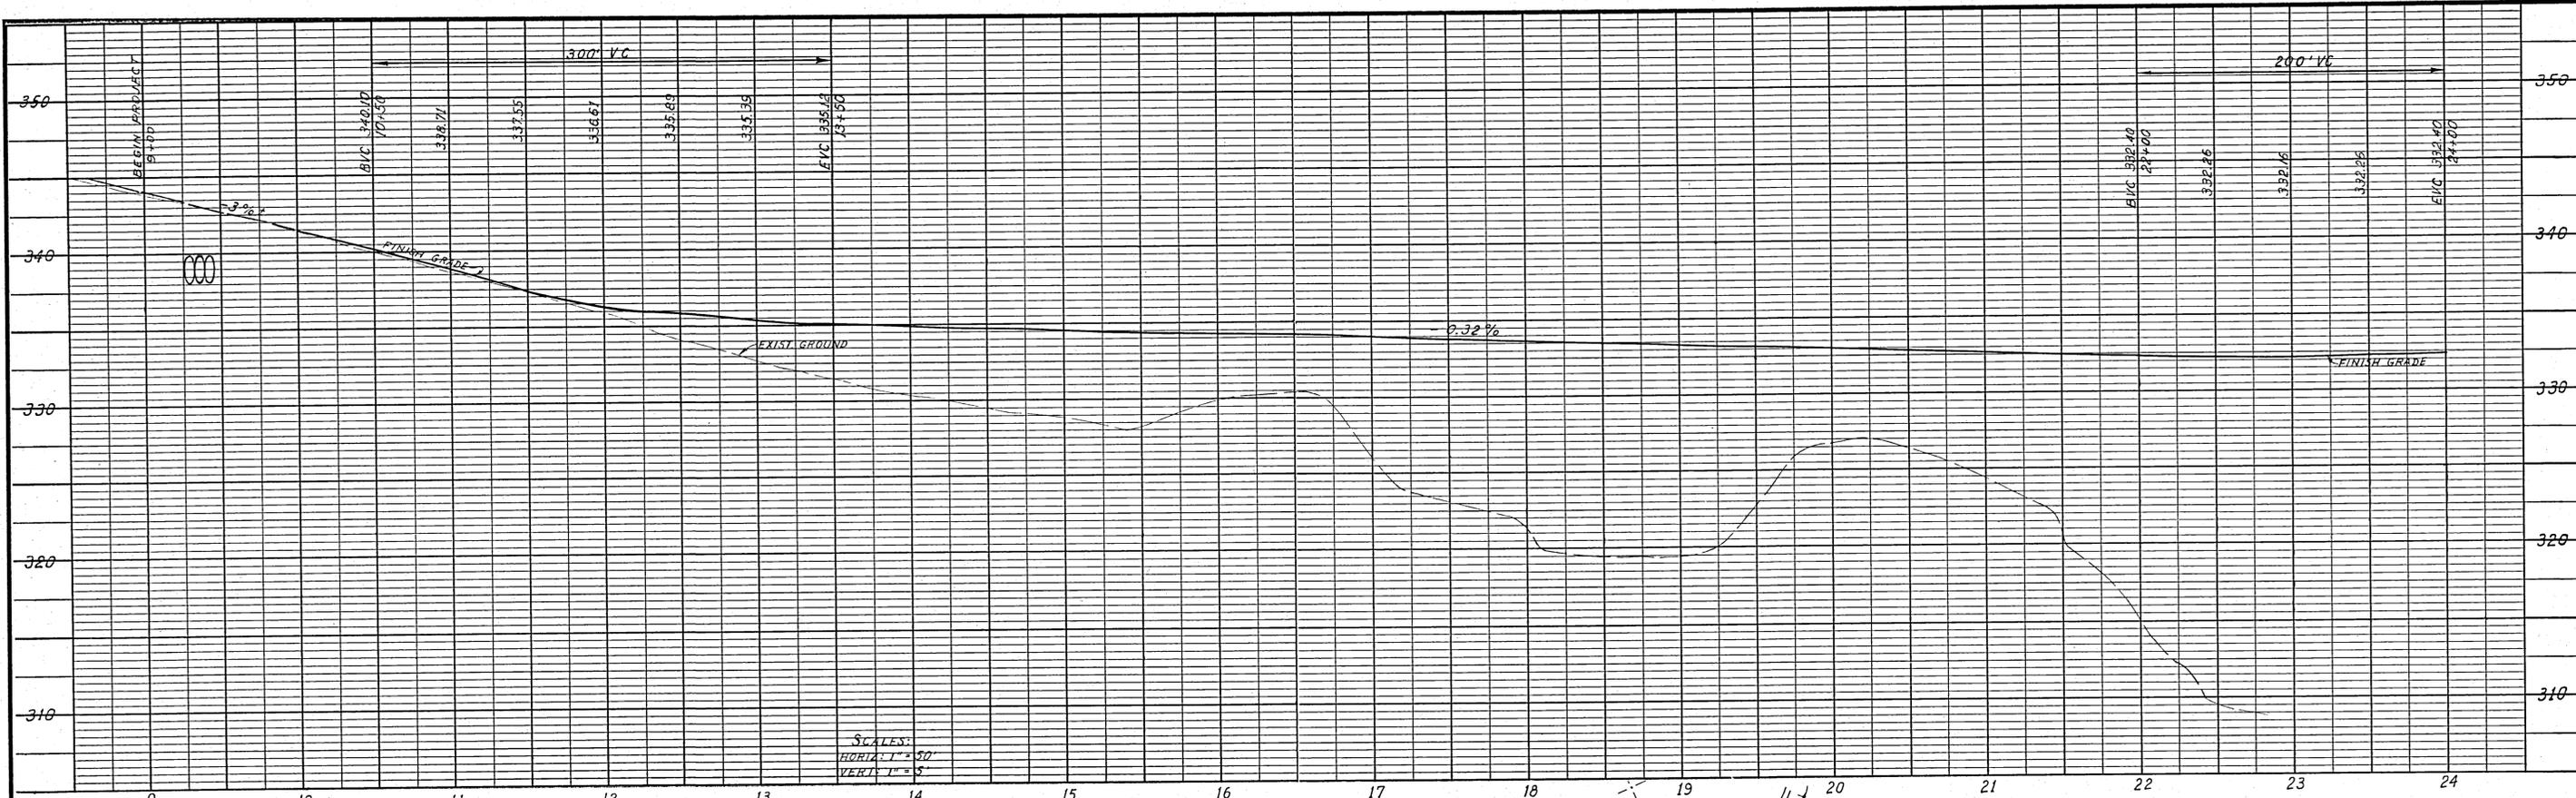

SCALES:
HORIZ. 1" = 50'
VERT. 1" = 5'


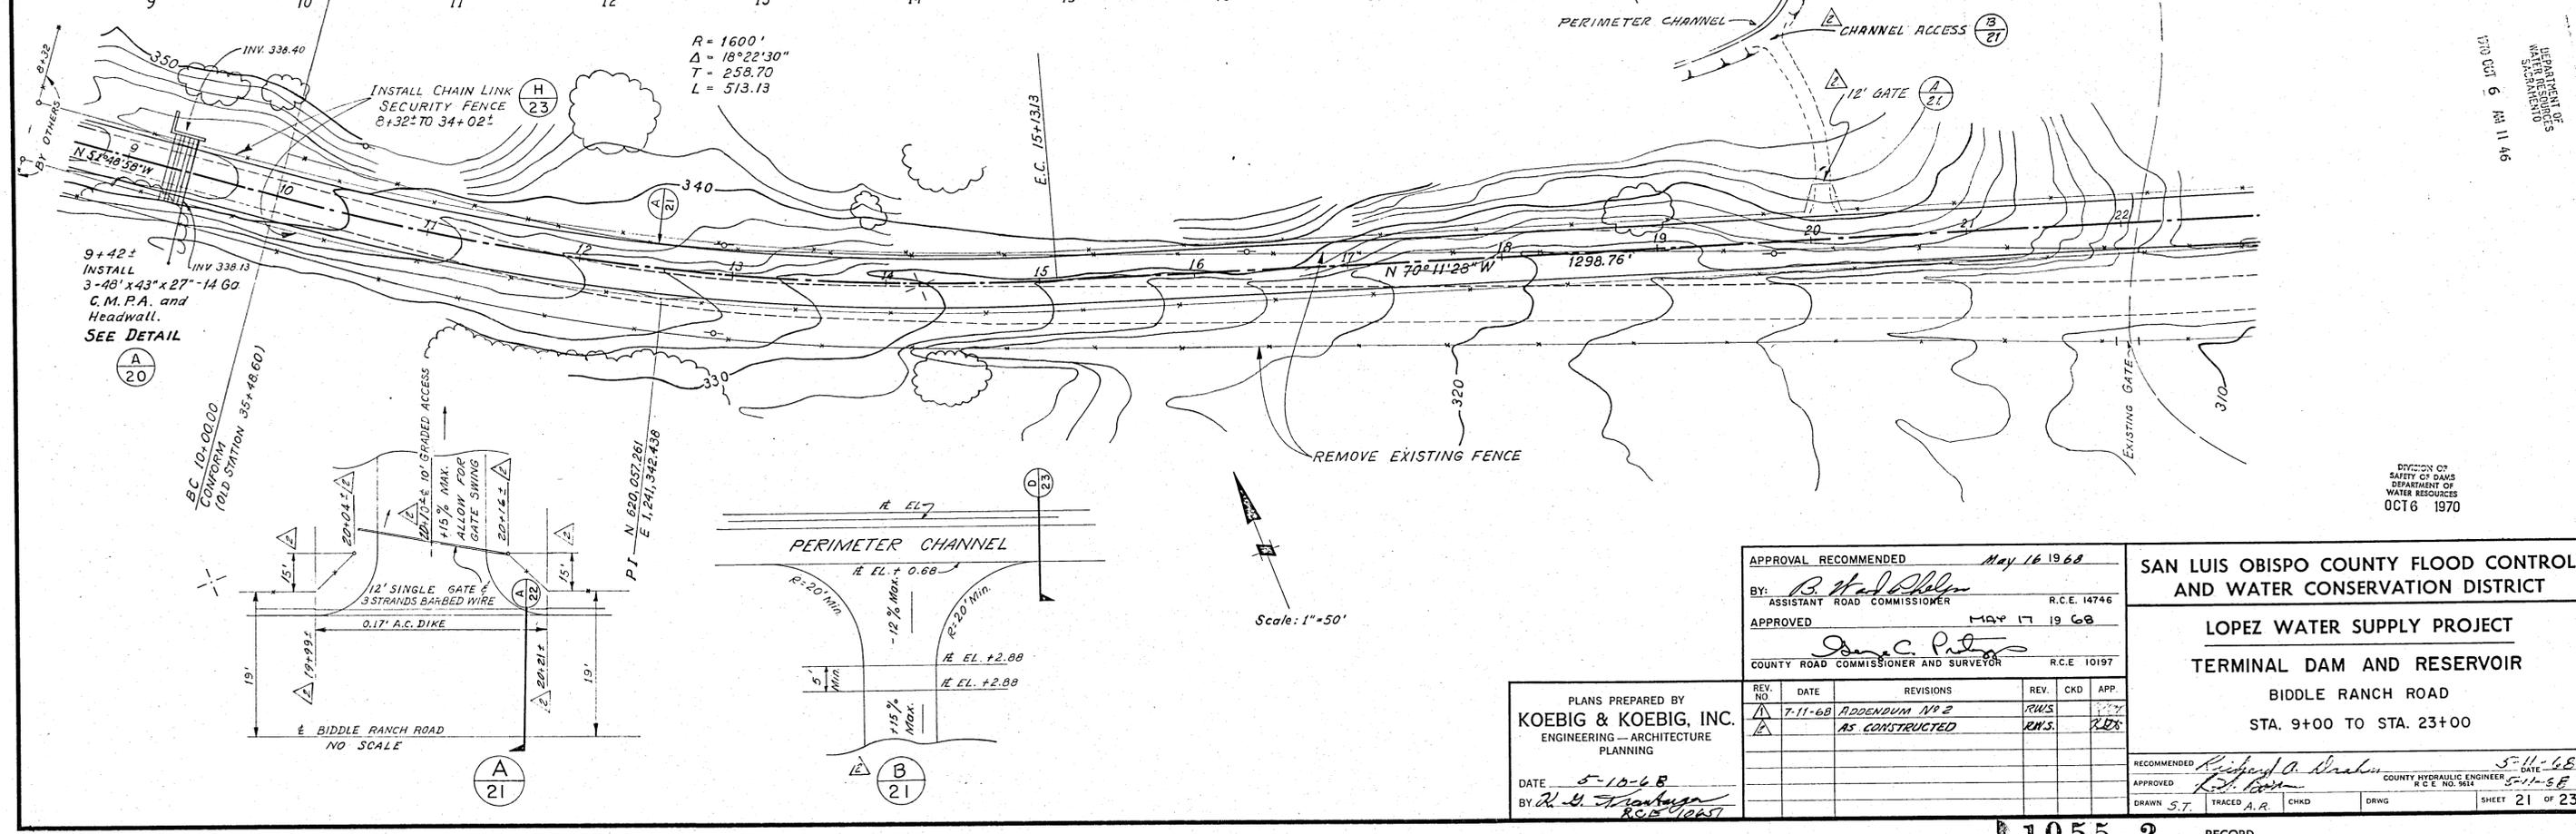


$R = 1600'$
 $\Delta = 18^\circ 22' 30''$
 $T = 258.70$
 $L = 513.13$

INSTALL CHAIN LINK SECURITY FENCE
8+32 TO 34+02

9+42 ±
INSTALL
3-48" x 43" x 27" - 14 60
C.M.P.A. and
Headwall.
SEE DETAIL

BC 10+00.00
CONFORM
OLD STATION 35+48.60

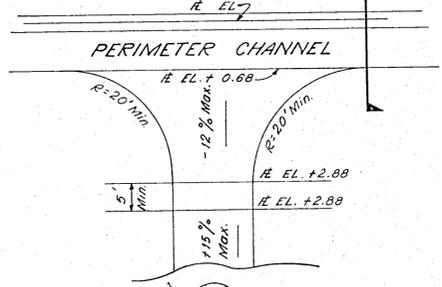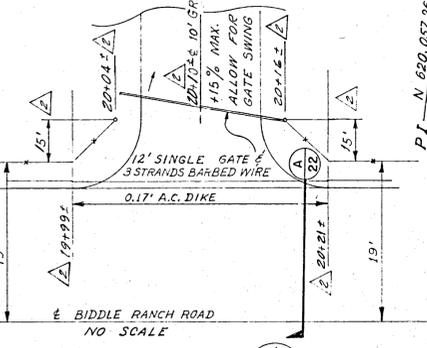

Scale: 1" = 50'

APPROVAL RECOMMENDED *May 16 19 68*
BY: *B. H. ...* ASSISTANT ROAD COMMISSIONER R.C.E. 14746
APPROVED *May 17 19 68*
James C. ... COUNTY ROAD COMMISSIONER AND SURVEYOR R.C.E. 10197

PLANS PREPARED BY
KOEBIG & KOEBIG, INC.
ENGINEERING - ARCHITECTURE
PLANNING
DATE *5-10-68*
BY *R. H. ...* R.C.E. 10657

REV. NO.	DATE	REVISIONS	REV.	CKD.	APP.
1	7-11-68	ADDENDUM NO 2	RWS		
2		AS CONSTRUCTED	RWS		RDS



SAN LUIS OBISPO COUNTY FLOOD CONTROL AND WATER CONSERVATION DISTRICT

LOPEZ WATER SUPPLY PROJECT
TERMINAL DAM AND RESERVOIR
BIDDLE RANCH ROAD
STA. 9+00 TO STA. 23+00



RECOMMENDED *Richard A. ...* COUNTY HYDRAULIC ENGINEER DATE *5-11-68*
APPROVED *R. H. ...* R.C.E. NO. 9614 DATE *5-11-68*
DRAWN S.T. TRACED A.R. CHKD DRWG SHEET 21 OF 23

1055-2

RECORD COPY

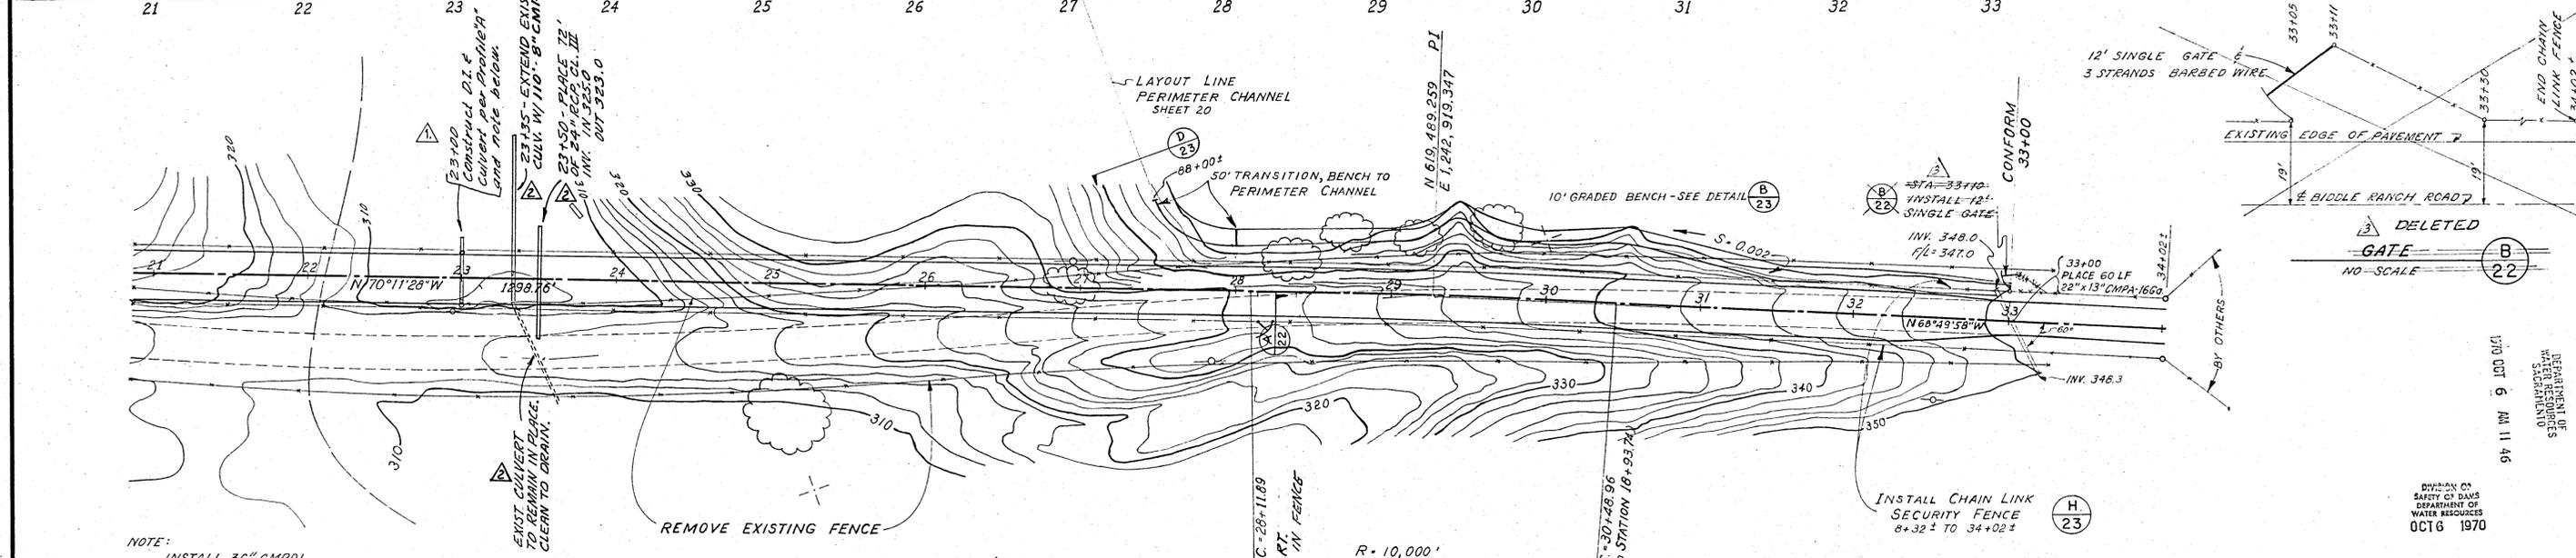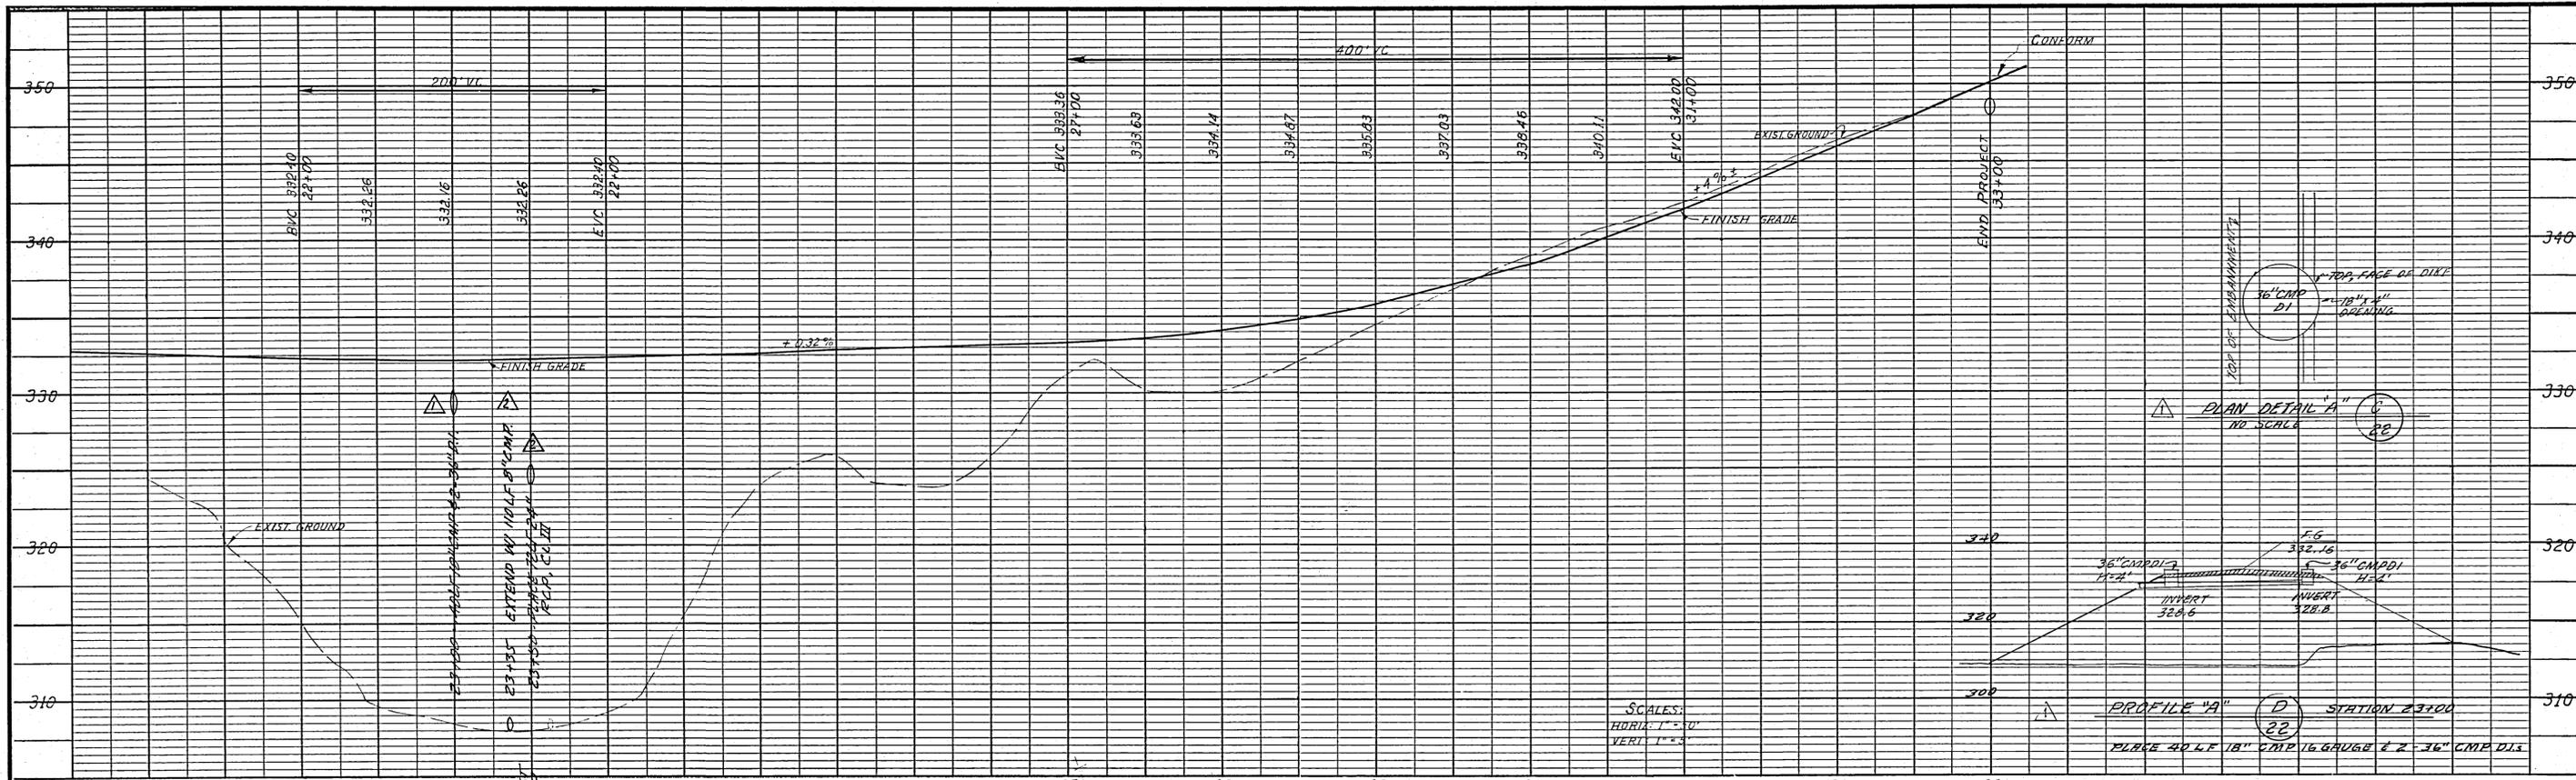

NOTE:
INSTALL 36" CMPDI
BEHIND AC DIKE AT STA. 23+00
AND PROVIDE OPENING TO DRAIN-
COVER SHALL BE STEEL CHECKER
PLATE AS SHOWN IN STANDARD
PLANS SHEET DT5-5 H=4'00"

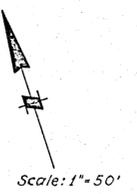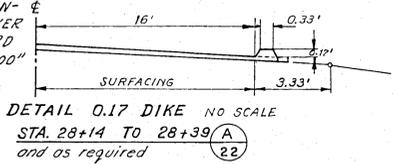

R = 10,000'
Δ = 1° 21' 30"
T = 118.54'
L = 237.07'

BC = 28+11.89
28+16 RT. TO 28+24 RT.
SINGLE B.C.L. GATE IN FENCE

APPROVAL RECOMMENDED *May 16 1968*
BY: *B. Ward Phillips*
ASSISTANT ROAD COMMISSIONER R.C.E. 14746
APPROVED *May 17 1968*
George C. Peterson
COUNTY ROAD COMMISSIONER AND SURVEYOR R.C.E. 10197

SAN LUIS OBISPO COUNTY FLOOD CONTROL
AND WATER CONSERVATION DISTRICT
LOPEZ WATER SUPPLY PROJECT
TERMINAL DAM AND RESERVOIR
BIDDLE RANCH ROAD
STA. 23+00 TO STA. 33+00


PLANS PREPARED BY
KOEBIG & KOEBIG, INC.
ENGINEERING - ARCHITECTURE
PLANNING
DATE 5-10-68
BY *D. J. Krawinkel*
R.C.E. 10051

REV. NO.	DATE	REVISIONS	REV.	CKD	APP.
1	7-11-68	ADDENDUM NO. 2	RWS.		
2	2-11-69	CHANGE ORDER NO. 9 (9-9-68)	RWS.		
3		AS CONSTRUCTED	RWS.		

RECOMMENDED *Richard A. Decker* 5-11-68
APPROVED *R. J. Decker* COUNTY HYDRAULIC ENGINEER DATE 5-11-68
DRAWN ST. TRACED A.R. CHKD DRWG SHEET 22 OF 23


1055-2

RECORD COPY

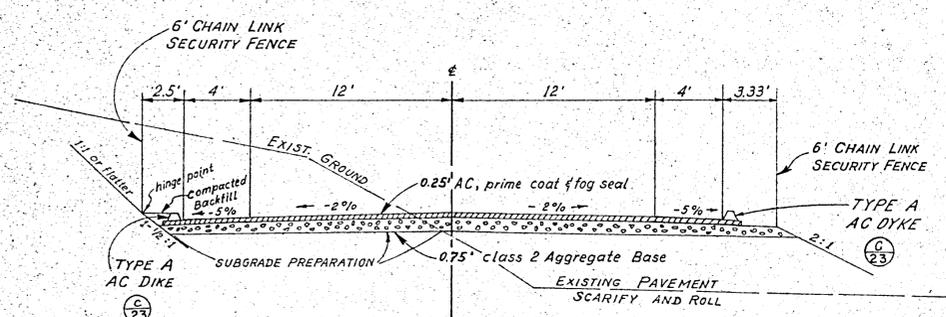


TYPICAL SECTION A
BIDDLE RANCH ROAD
NO SCALE


DESIGN DESIGNATION		REQ. GE - 1.4016 MIN. R = 27 (top 2')	
ADT (67) - 650	D - 60%	ACTUAL THICKNESS	GRAVE EQUIVALENT
ADT (87) - 1950	T - 8%	0.25'	A.C.
DHV - 350	V - 50 mph	0.75'	CI 2 AB
T.I. - 6		1.00	1.405

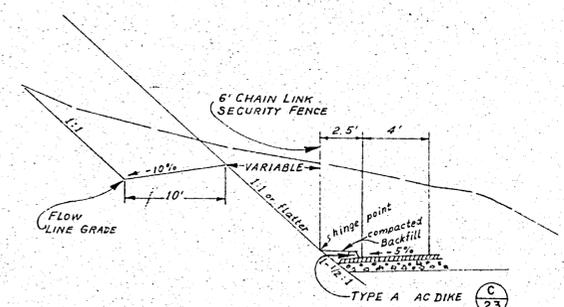


TYPICAL BENCH SECTION B
STA. 28+00 to STA. 33+00
BIDDLE RANCH ROAD
NO SCALE

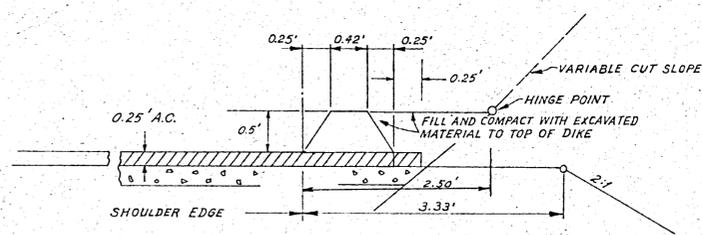

TYPE 'A' A.C. DIKE C
BIDDLE RANCH ROAD
NO SCALE

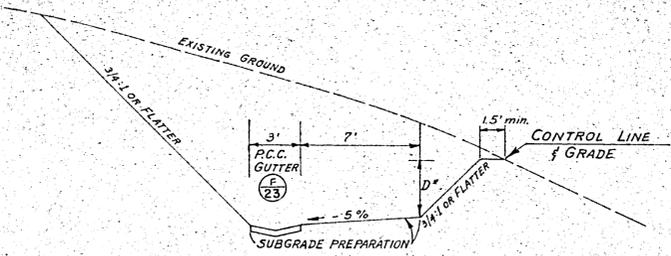


PERIMETER CHANNEL TYPICAL SECTION D
SCALE: 1" = 5'

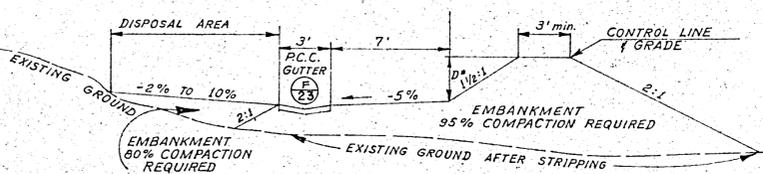


PERIMETER CHANNEL EMBANKMENT SECTION E
SCALE: 1" = 5'


APPROXIMATE STATION TO STATION	D*	DEPTH
0+00 to 25+00	25+00	3.5
25+00 to 50+00	50+00	3.0
50+00 to 72+00	72+00	2.25
72+00 to 88+00	88+00	2.0

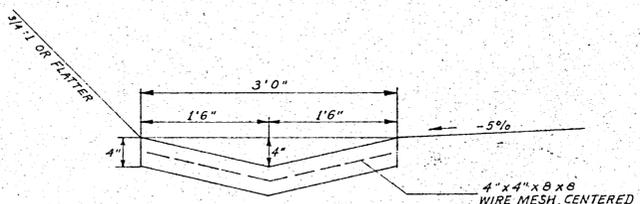


P.C.C. GUTTER DETAIL F
SCALE: 1" = 1'

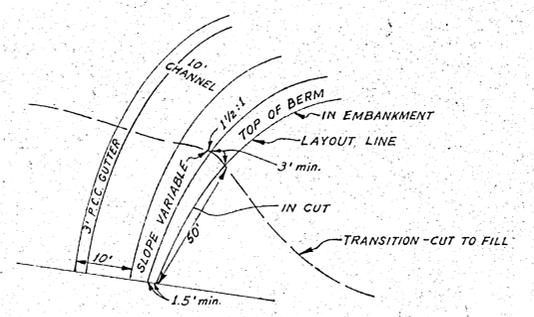

PERIMETER CHANNEL TRANSITION DETAIL G
NO SCALE

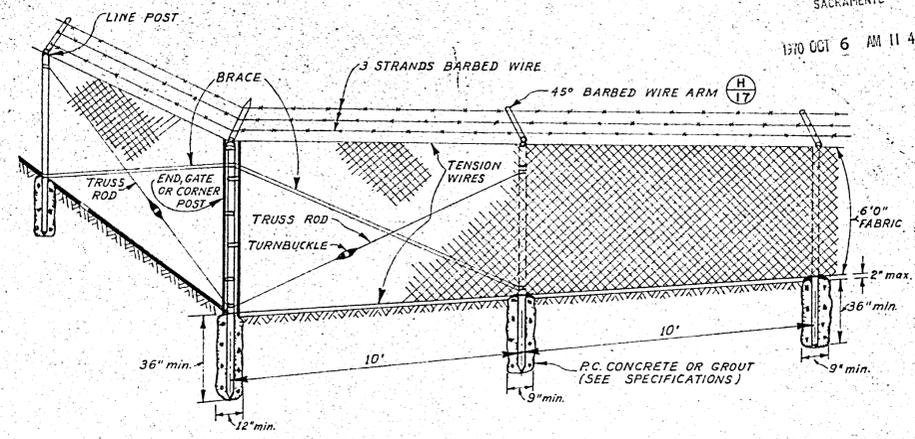

CHAIN LINK SECURITY FENCE H
STA. 8+32± TO STA. 34+02±
BIDDLE RANCH ROAD
NO SCALE

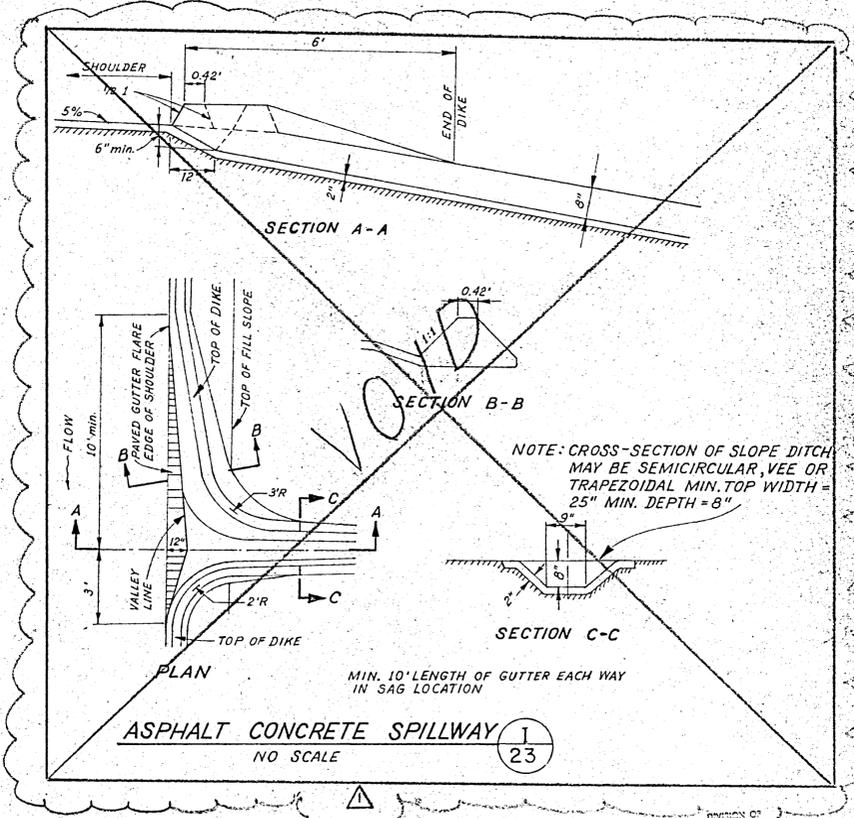

ASPHALT CONCRETE SPILLWAY I
NO SCALE

DIVISION OF SAFETY OF DAMS
DEPARTMENT OF WATER RESOURCES
OCT 6 1970


APPROVAL RECOMMENDED
BY: *[Signature]*
ASSISTANT ROAD COMMISSIONER
APPROVED: *[Signature]*
COUNTY ROAD COMMISSIONER AND SURVEYOR

SAN LUIS OBISPO COUNTY FLOOD CONTROL AND WATER CONSERVATION DISTRICT
LOPEZ WATER SUPPLY PROJECT
TERMINAL DAM AND RESERVOIR
ROADWAY AND PERIMETER CHANNEL
TYPICAL DETAILS

PLANS PREPARED BY
KOEBIG & KOEBIG, INC.
ENGINEERING - ARCHITECTURE
PLANNING
DATE: 5-10-68
BY: *[Signature]*

REV. NO.	DATE	REVISIONS	REV.	CHKD.	APP.
1	7-11-68	APPENDUM NO 2 AS CONSTRUCTED			

RECOMMENDED: *[Signature]*
APPROVED: *[Signature]*
DRAWN: S.T. TRACED: A.R. CHKD: DRWG: SHEET 23 OF 23

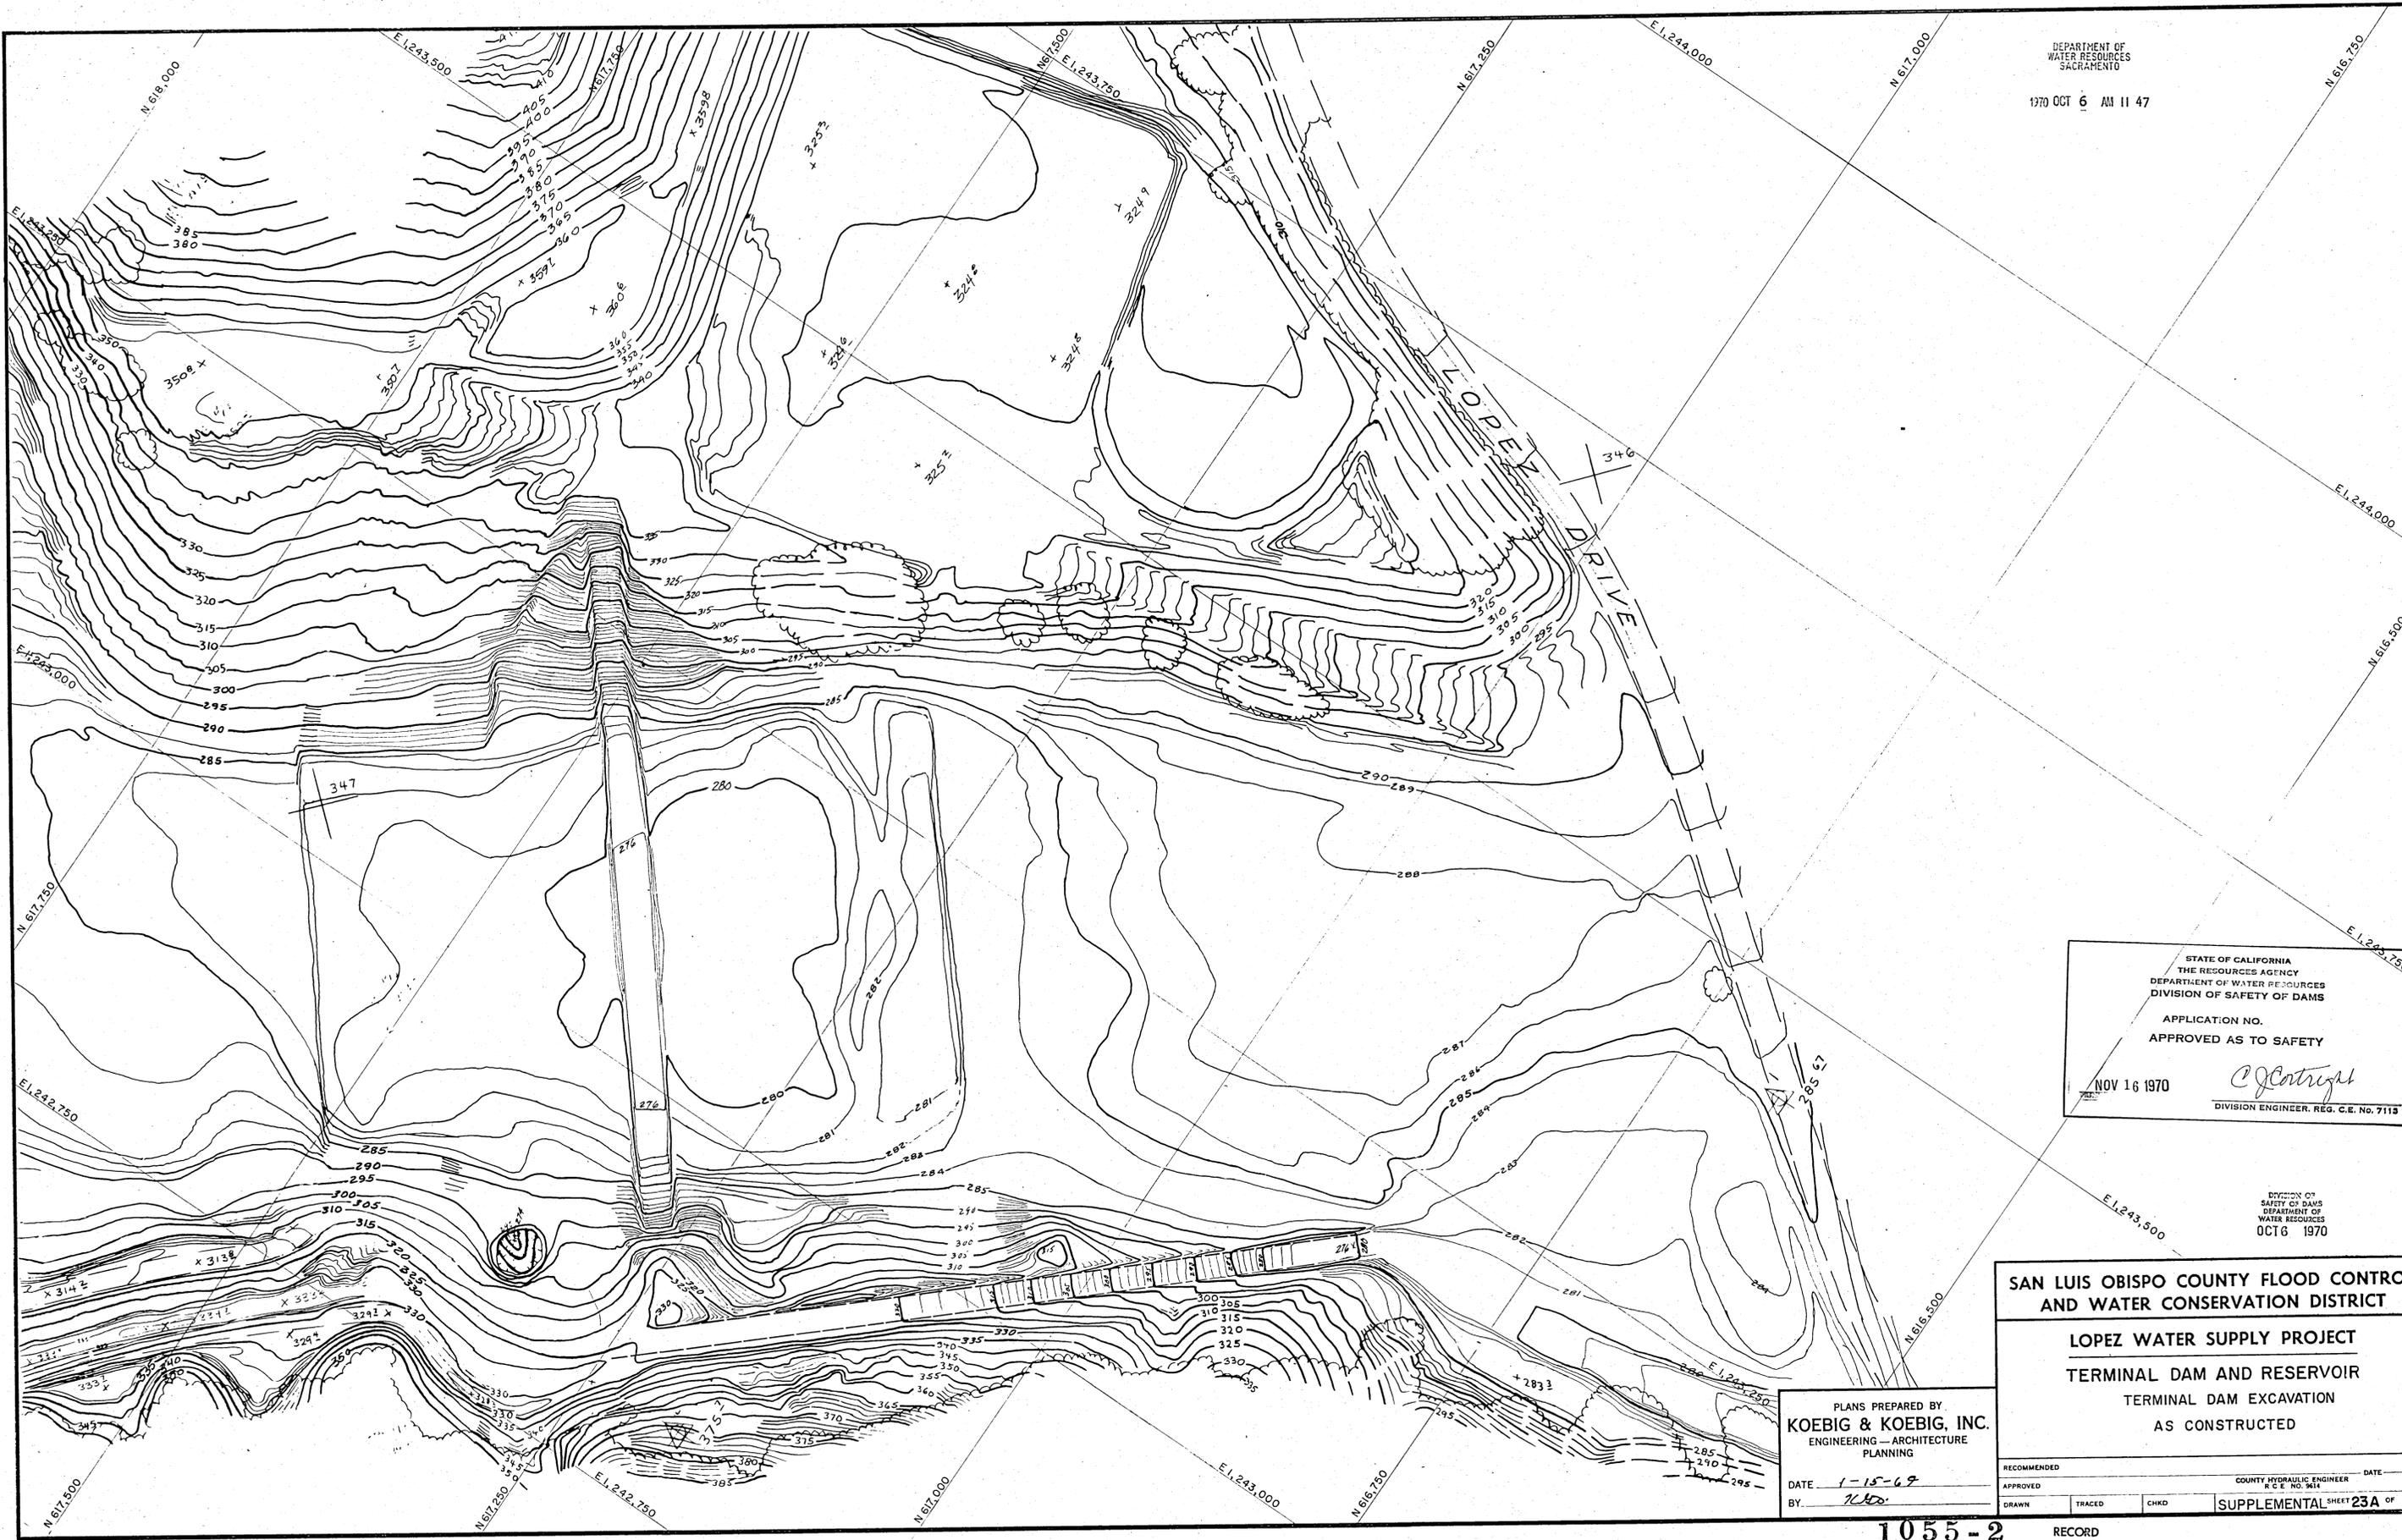

STATE OF CALIFORNIA
THE RESOURCES AGENCY
DEPARTMENT OF WATER RESOURCES
DIVISION OF SAFETY OF DAMS
APPLICATION NO.
APPROVED AS TO SAFETY
NOV 16 1970
C. J. Cottrill
DIVISION ENGINEER, REG. C.E. NO. 7113

SAN LUIS OBISPO COUNTY FLOOD CONTROL
AND WATER CONSERVATION DISTRICT
LOPEZ WATER SUPPLY PROJECT
TERMINAL DAM AND RESERVOIR
TERMINAL DAM EXCAVATION
AS CONSTRUCTED




PLANS PREPARED BY
KOEBIG & KOEBIG, INC.
ENGINEERING - ARCHITECTURE
PLANNING

DATE 1-15-68
BY KKO

RECOMMENDED COUNTY HYDRAULIC ENGINEER DATE
APPROVED R.C.E. NO. 9614
DRAWN TRACED CHKD
SUPPLEMENTAL SHEET 23A OF

1055-2

RECORD COPY

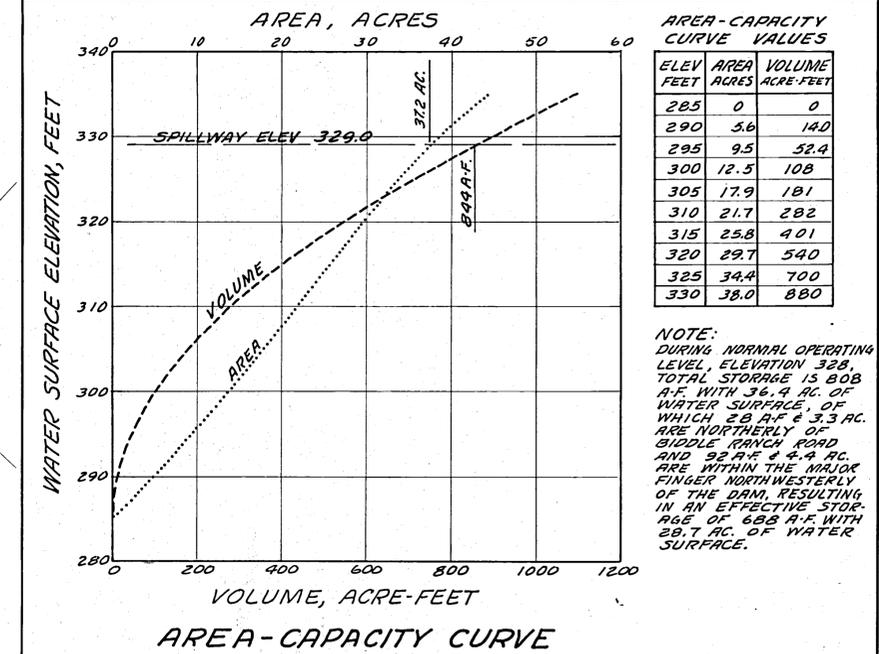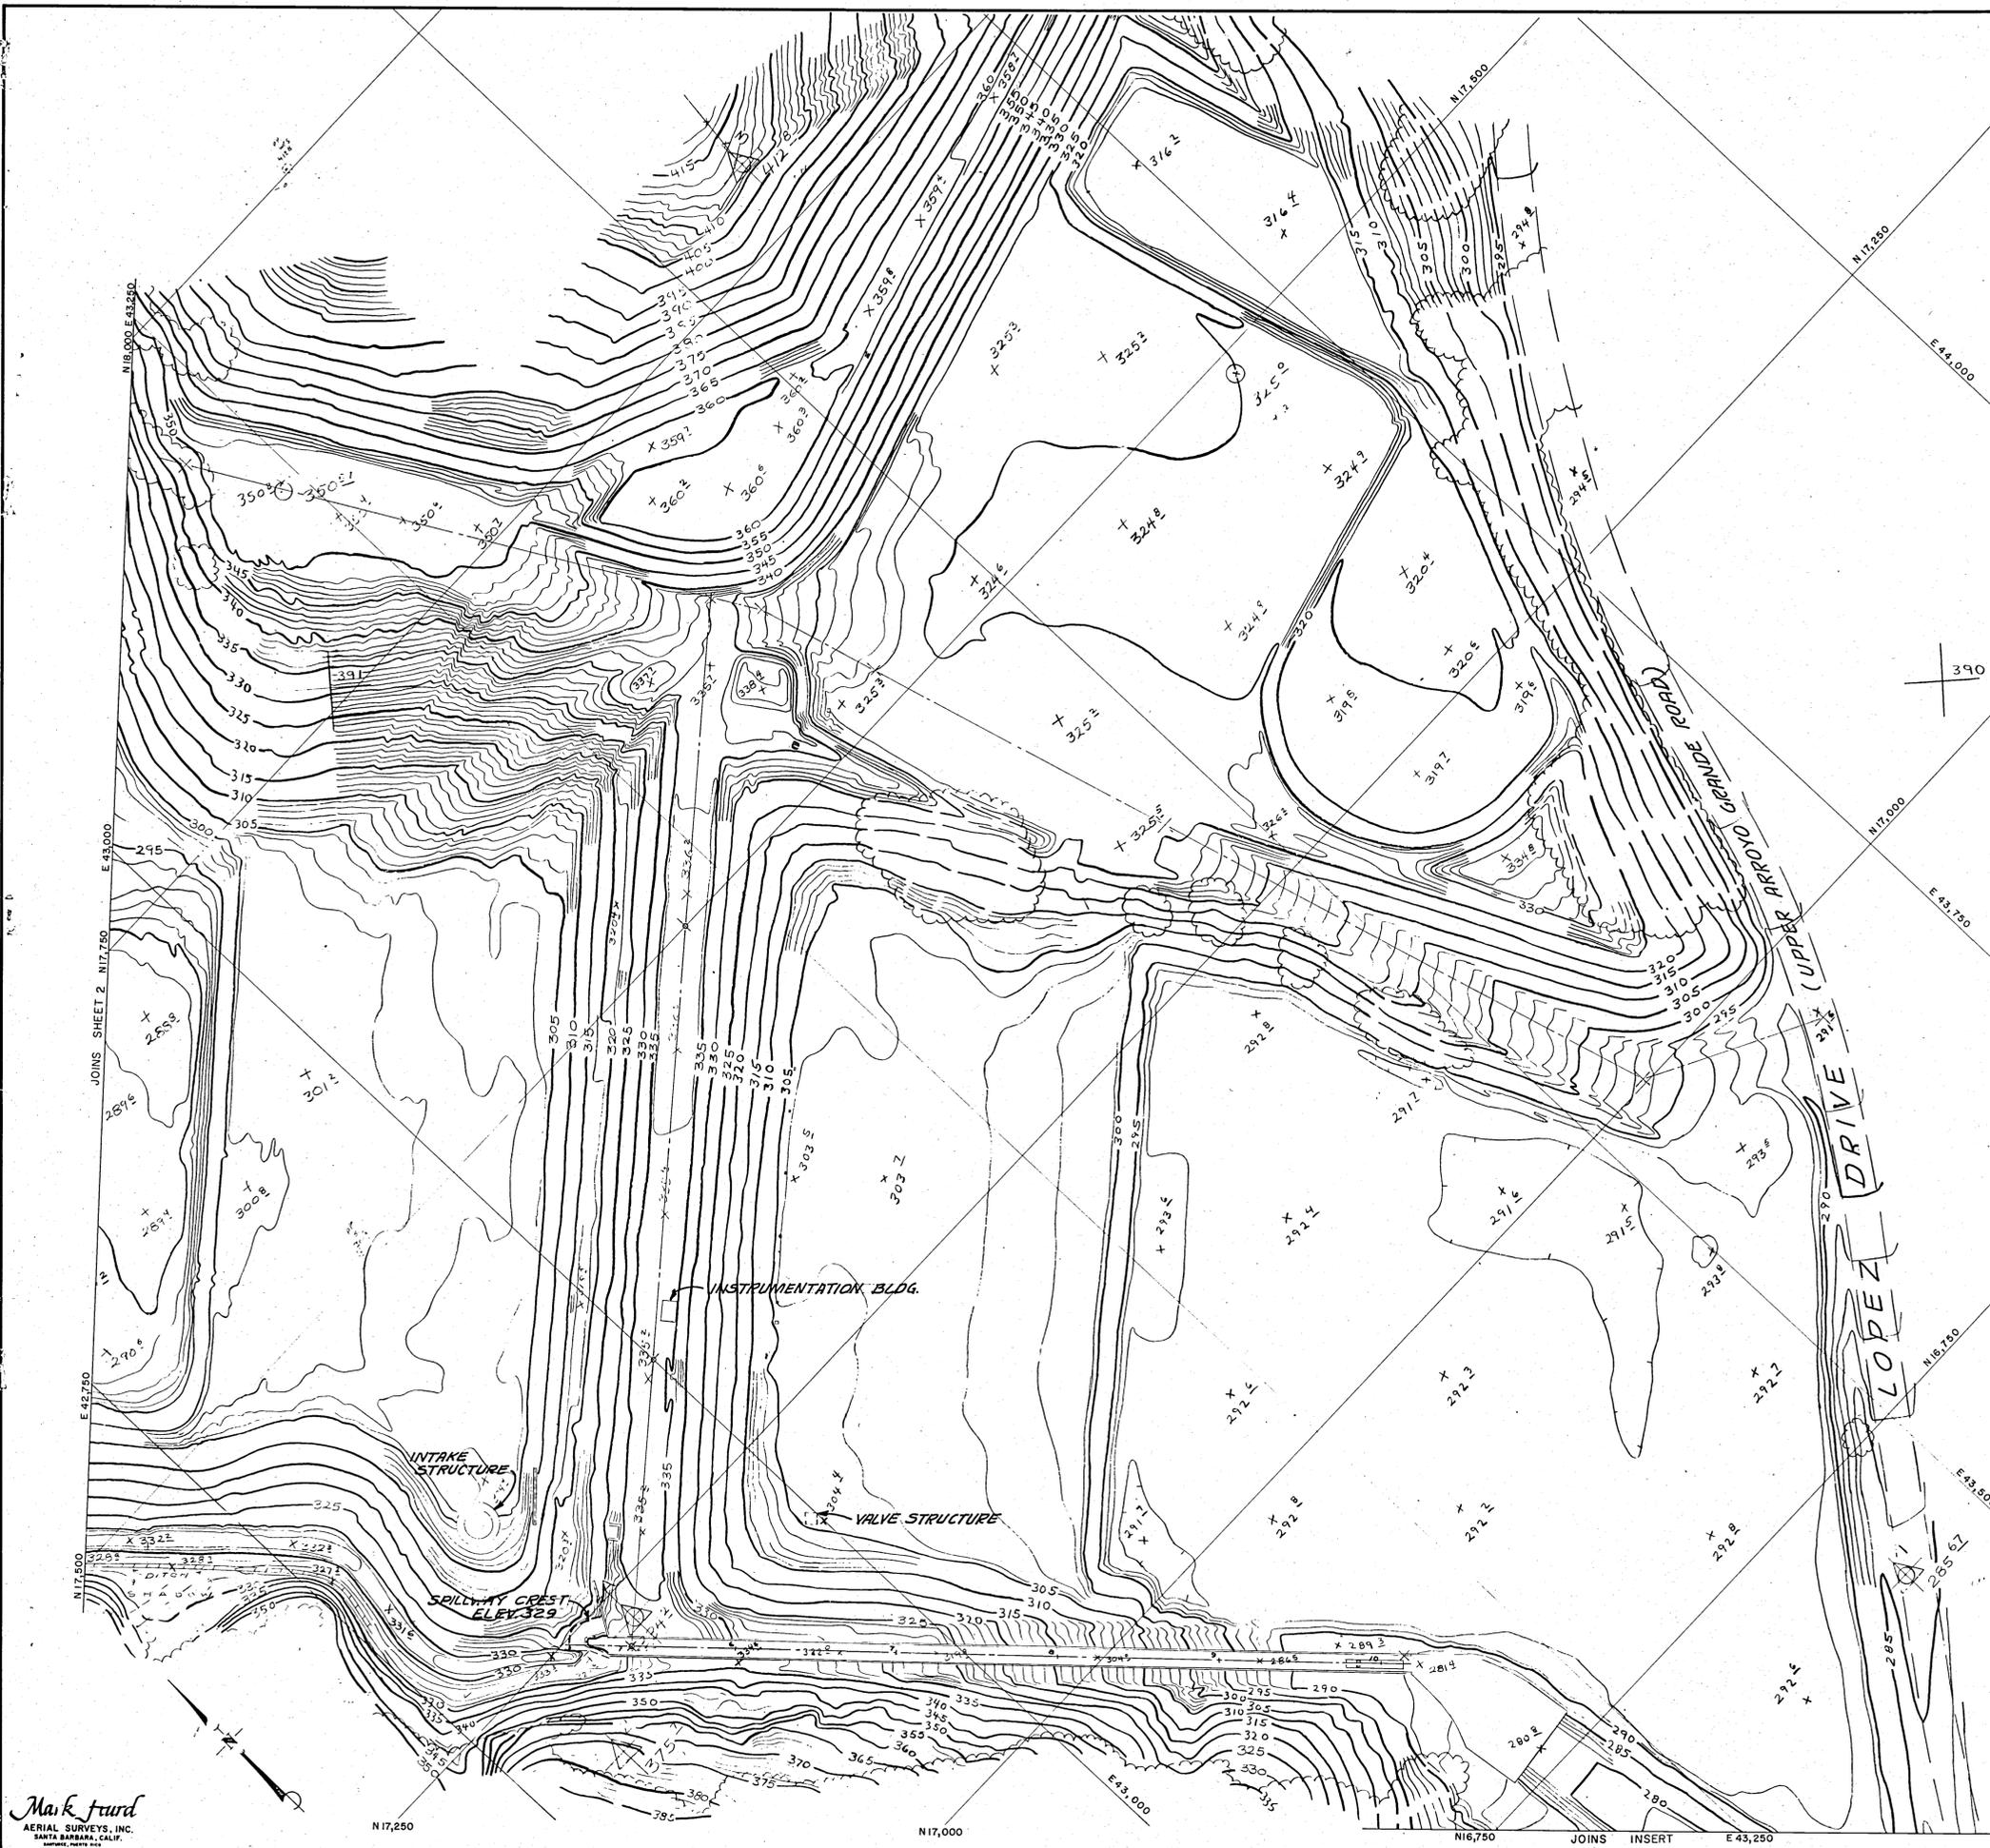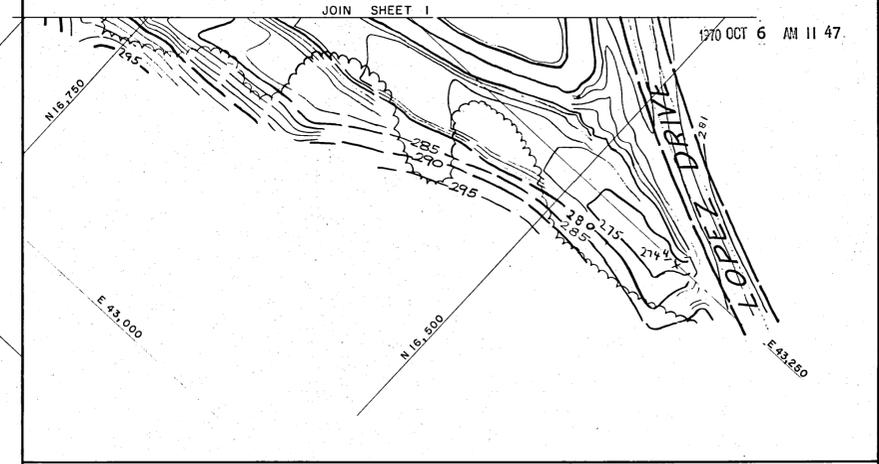

STATE OF CALIFORNIA
THE RESOURCES AGENCY
DEPARTMENT OF WATER RESOURCES
DIVISION OF SAFETY OF DAMS

APPLICANT ON NO.
APPROVED AS TO SAFETY

C. J. [Signature]
DIVISION ENGINEER, REG. C.E. NO. 7113

NOTE:
1. ADD 1,200,000 TO EAST COORDINATES AND 600,000 TO NORTH COORDINATES FOR CALIFORNIA COORDINATE SYSTEM, ZONE Y.
2. PHOTOGRAMMETRY PREPARED FROM AERIAL PHOTOGRAPHS TAKEN DECEMBER 11, 1968

SAN LUIS OBISPO COUNTY FLOOD CONTROL AND WATER CONSERVATION DISTRICT

LOPEZ WATER SUPPLY PROJECT
TERMINAL DAM & RESERVOIR
TERMINAL DAM TOPOGRAPHY
AS CONSTRUCTED

RECOMMENDED BY: *Richard G. [Signature]* 7/11/69
APPROVED BY: *Robert J. [Signature]* 7-27-69
DATE: 1-15-69
BY: *H. H. [Signature]* RCE 10651
DRAWN: [] CHECKED: []

DIVISION OF SAFETY OF DAMS
DEPARTMENT OF WATER RESOURCES
OCT 6 1970

SCALE 1" = 50'

PLANS PREPARED BY
KOEBIG & KOEBIG, INC.
ENGINEERING-ARCHITECTURE
PLANNING

DATE: 1-15-69
BY: *H. H. [Signature]* RCE 10651

Mark Ford
AERIAL SURVEYS, INC.
SANTA BARBARA, CALIF.

Appendix B

Survey Field Notes Performed by the District

Bridge Data, from US to DS

Grieb Ranch Way

Bridge Length = 130'; Bridge width = 24'

24 pilings each 12-14" with 3"x8" cross brace



Talley Farms Road

Bridge Length = 94'; Bridge width = 24'; Single span



Huasna Road

Bridge Length = 87'; Bridge width = 22'

Center span/opening = 43'

Abutment each side, Length = 20', Height = 35-40' (approximate)



Mason Street

Bridge Length = 169'; Bridge width = 28'

Abutment, with concrete arch support under deck

Abutment length = 22'



Bridge Street

Bridge length = 141'; Bridge width = 36'



Traffic Way

Bridge length = 225'; Bridge width = 45'

5 groups/sets of piers



US 101 – Bridge 49-175

Unable to photograph


Fair Oaks

Bridge Length = 130'; Bridge width = 76'



Appendix C

Flood Inundation Maps

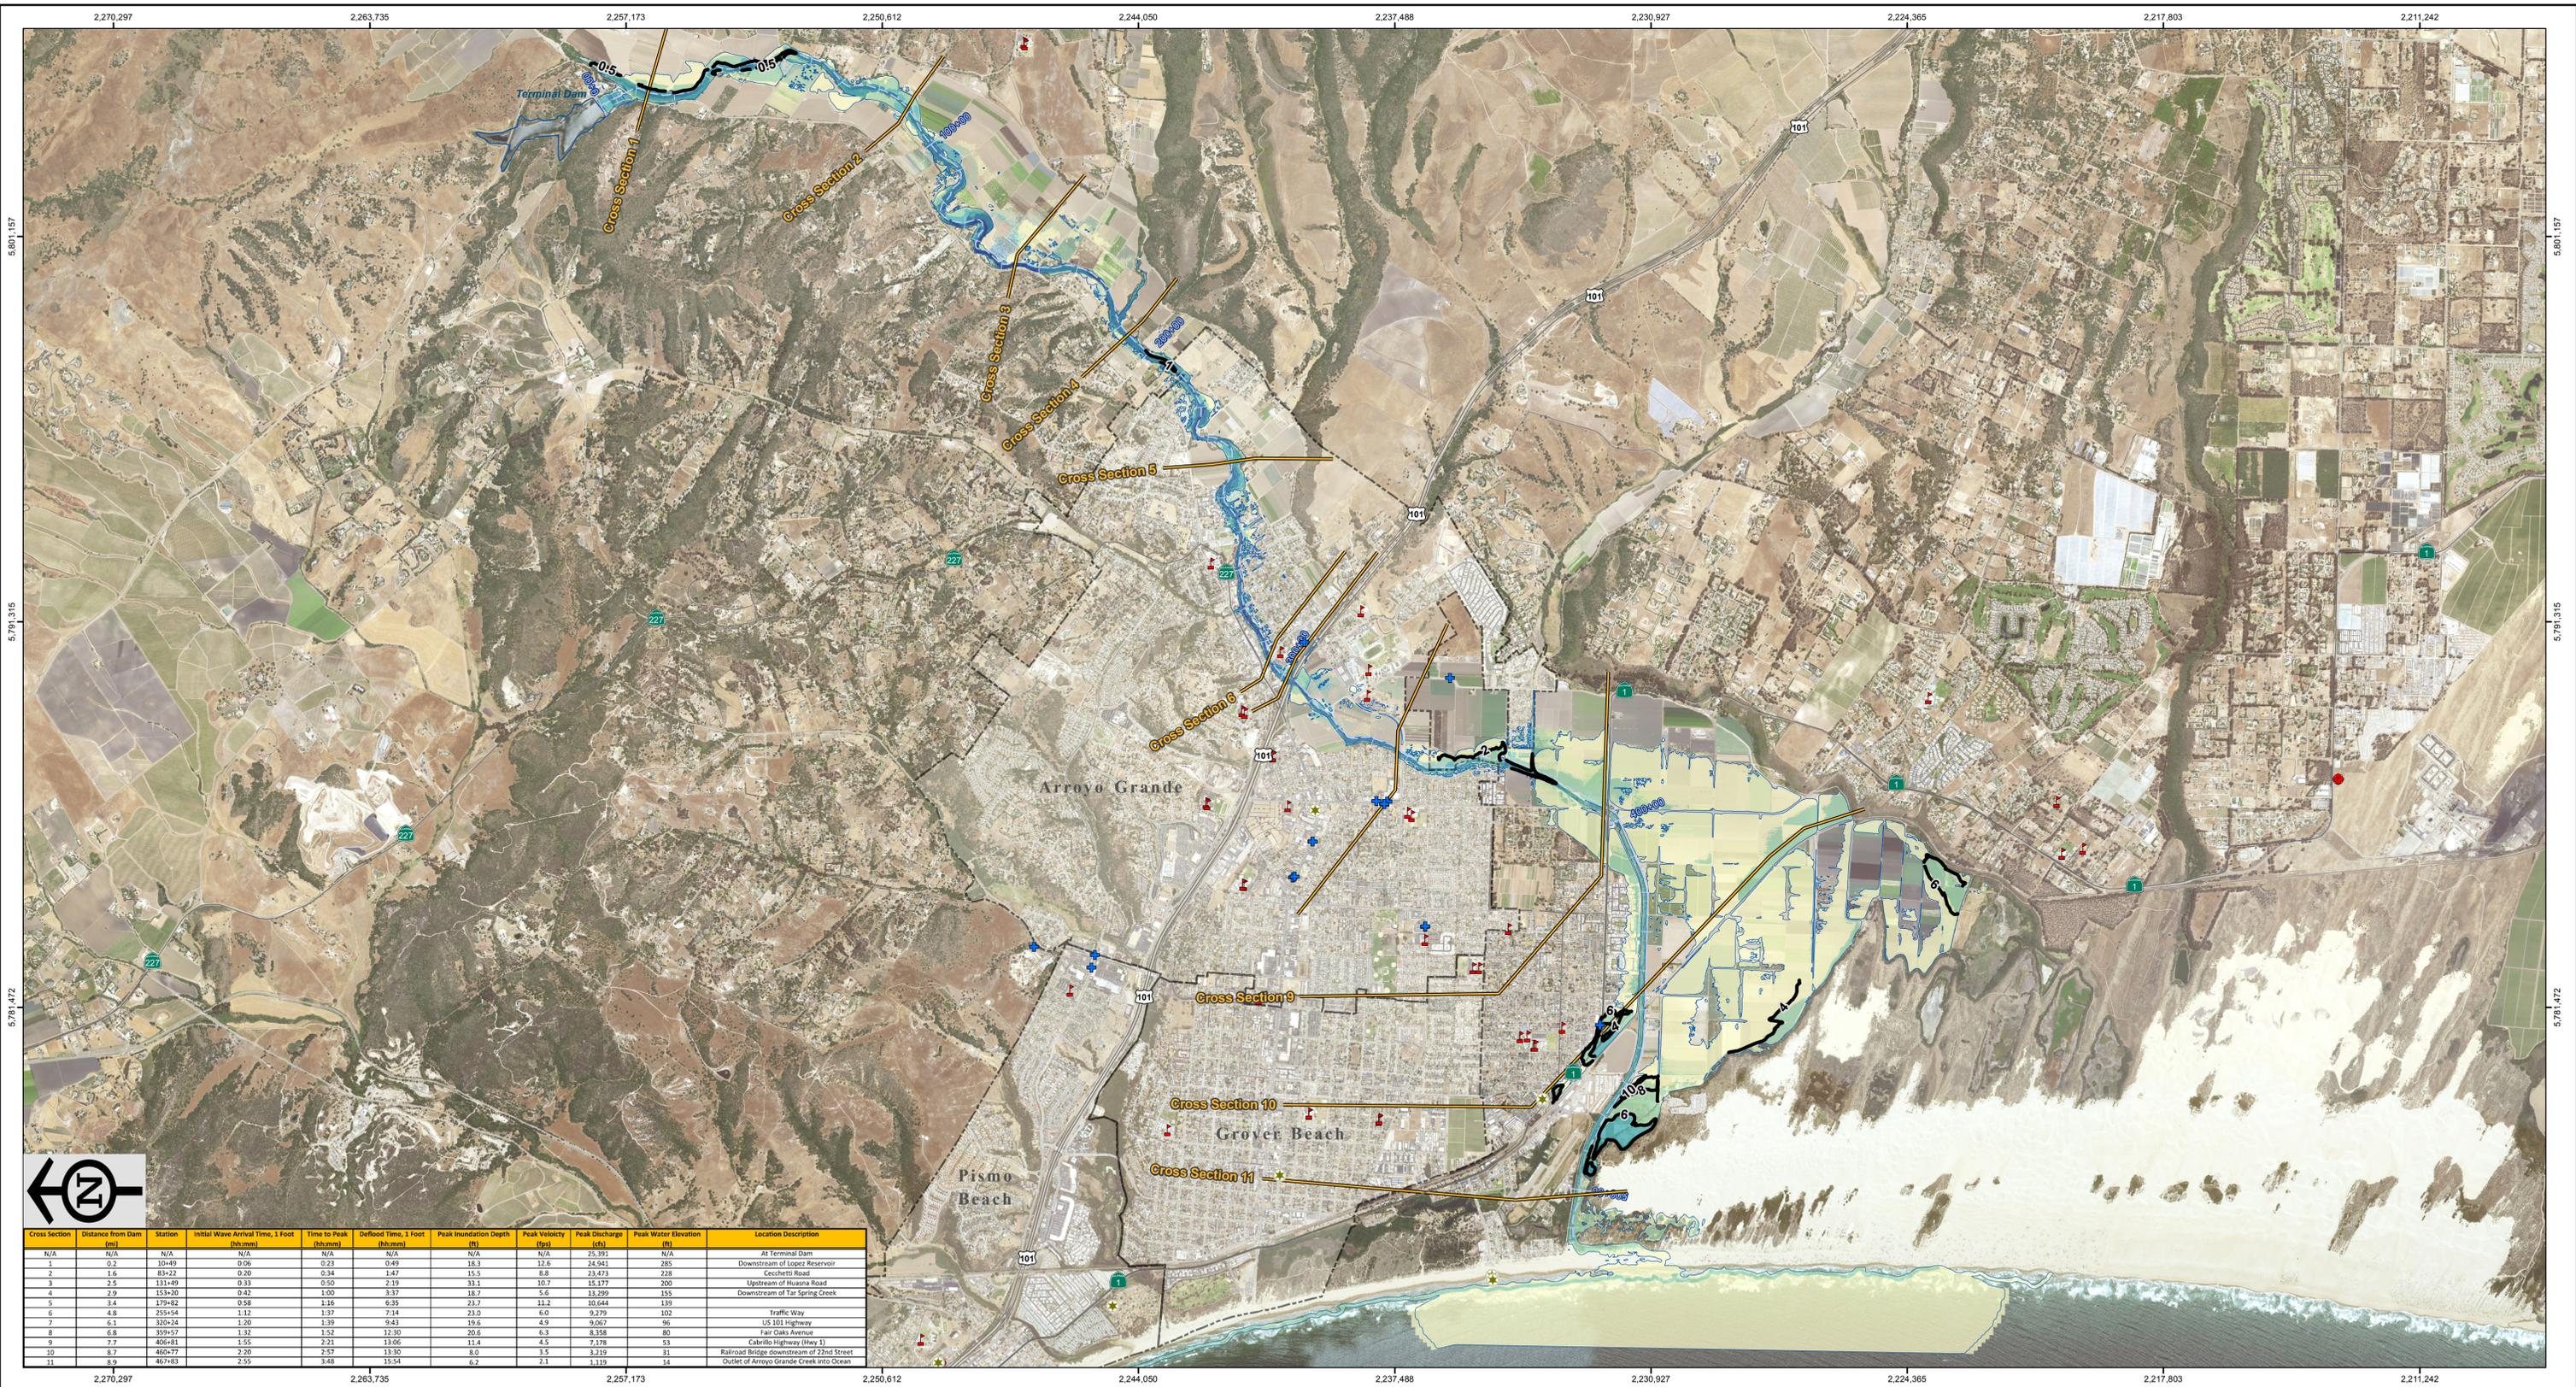


Cross Section	Distance from Dam (mi)	Station	Initial Wave Arrival Time, 1 Foot (hh:mm)	Time to Peak (hh:mm)	Deflood Time, 1 Foot (hh:mm)	Peak Inundation Depth (ft)	Peak Velocity (fps)	Peak Discharge (cfs)	Peak Water Elevation (ft)	Location Description
N/A	N/A	N/A	N/A	N/A	N/A	N/A	N/A	25,391	N/A	At Terminal Dam
1	0.2	10+49	0:26	0:23	0:49	18.3	12.6	24,941	285	Downstream of Lopez Reservoir
2	1.6	83+22	0:20	0:34	1:47	15.5	23,473	228	Cecchetti Road	
3	2.5	131+49	0:33	0:50	2:19	33.1	10,177	200	Upstream of Husona Road	
4	2.9	153+20	0:43	1:00	3:37	18.7	13,299	155	Downstream of Tar Spring Creek	
5	3.4	179+82	0:58	1:16	6:35	23.7	10,644	139		
6	4.8	255+54	1:12	1:37	7:14	23.0	9,279	102	Traffic Way	
7	6.1	320+24	1:20	1:39	9:43	19.6	9,067	96	US 101 Highway	
8	6.8	359+57	1:32	1:52	12:30	20.6	8,358	80	Fair Oaks Avenue	
9	7.7	406+81	1:55	2:21	13:06	11.4	7,178	53	Cabrillo Highway (Hwy 1)	
10	8.7	460+77	2:20	2:57	13:30	8.0	3,219	31	Railroad Bridge downstream of 72nd Street	
11	8.9	467+83	2:59	3:48	13:54	6.2	1,119	14	Outlet of Arroyo Grande Creek into Ocean	

Notes:

- This map was developed for the benefit of local emergency managers and the California Emergency Management Agency. The information shown is approximate and should be used as a guide for emergency response and preparation purposes.
- The inundation map meets all applicable state and federal standards and has been prepared in consideration of all potential downstream hazards by a licensed civil engineer.
- The results presented herein do not reflect the structural integrity of the dam and are not a statement of the dam's safety. The analysis presented is based on a hypothetical dam failure using 2D modeling software with a 100' grid.
- Cross Section Values:
 - Distance from Dam and Stationing are reckoned from the centerline of Terminal Dam along the displayed Flow Path.
 - Distance from Dam is in miles and Stationing is in feet (Stationing 12+34 = 1,234').
 - Initial Wave Arrival Time, 1 Foot is the time to achieve 1 foot of water depth after initiation of the dam break.
 - Time to Peak is the time to achieve the maximum water depth after initiation of the dam break.
 - Deflood Time, 1 Foot is the time elapsed from the flood wave arrival time until water recedes to within one foot of its pre-flood water elevation.

- Cross Section Values continued:
 - Peak Inundation Depth is the maximum water depth.
 - Peak Velocity is the maximum velocity.
 - Peak Discharge is an estimate of the maximum flow rate integrated over the entire cross section line.
 - Peak Water Elevation is the maximum water surface elevation.
 - Time Above 1 Foot is the time water depth is above 1 foot.
 - Location Description indicates major roads that cross, or are near, the Flow Path at that cross section.
- The values displayed in the table for each cross section are the maximum for that parameter along each cross section line, except for the Initial Wave Arrival Time, 1 Foot and Time to Peak which are the minimum for that parameter along each cross section line. The minimum time values associated with 1D channels embedded in the 2D model are excluded.
- For other details refer to the supporting report "Terminal Dam Failure and Inundation Study" 31 December 2017.
- Structures are shown in the aerial photo on the maps but may not clearly display all possible structures potentially within the inundation limits.
- Map projection: California State Plane, Zone 5, Feet, North American Datum 1983. Reference Points and border ticks display these coordinate values. All elevations are referenced to North American Vertical Datum 1988.

- School/Day Care
- Law Enforcement Facility
- CalFire Facility
- Licensed Healthcare Facility
- Flow Path
- Cross Section
- Approx. Time to 1 Foot Depth (hrs)
- Approx. Maximum Flooding Extent
- Maximum Inundation Depth (feet)
 - ≤ 2
 - >2 to 5
 - >5 to 10
 - >10 to 20
 - >20

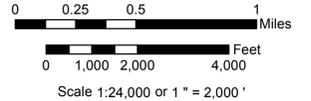

DO NOT DISTRIBUTE THIS MAP OR THE ASSOCIATED MODEL INFORMATION WITHOUT PRIOR NOTIFICATION TO THE FEDERAL DAM OWNER


NOTICE
San Luis Obispo County deems this information to be Confidential. Do not share the information unless prior approval is obtained from SLO County's Dam Safety Officer at (805) 781-5252.

Inundation Depth Map for Fair Weather Hypothetical Failure of Terminal Dam
Flood Depth and Arrival Time
Federal Dam ID: CA00888 State Dam ID: 1055.002
Detail Sheet 1 of 1
San Luis Obispo County
© 2017 San Luis Obispo County

Rev	Date	Description	Prepared By	Accepted By
	31 December 2017	DRAFT	GEI Consultants	

Dam Owner: San Luis Obispo County Flood Control and Water Conservation District
County Government Center, Room 206
San Luis Obispo, CA 93408
Information Contact: John Diodati, (805) 781-5252
Emergency Contact: (805) 781-5252

Inundation Analysis Performed by and Inundation Maps Created by: GEI Consultants, Inc.
Mark Forthner, PE 48266


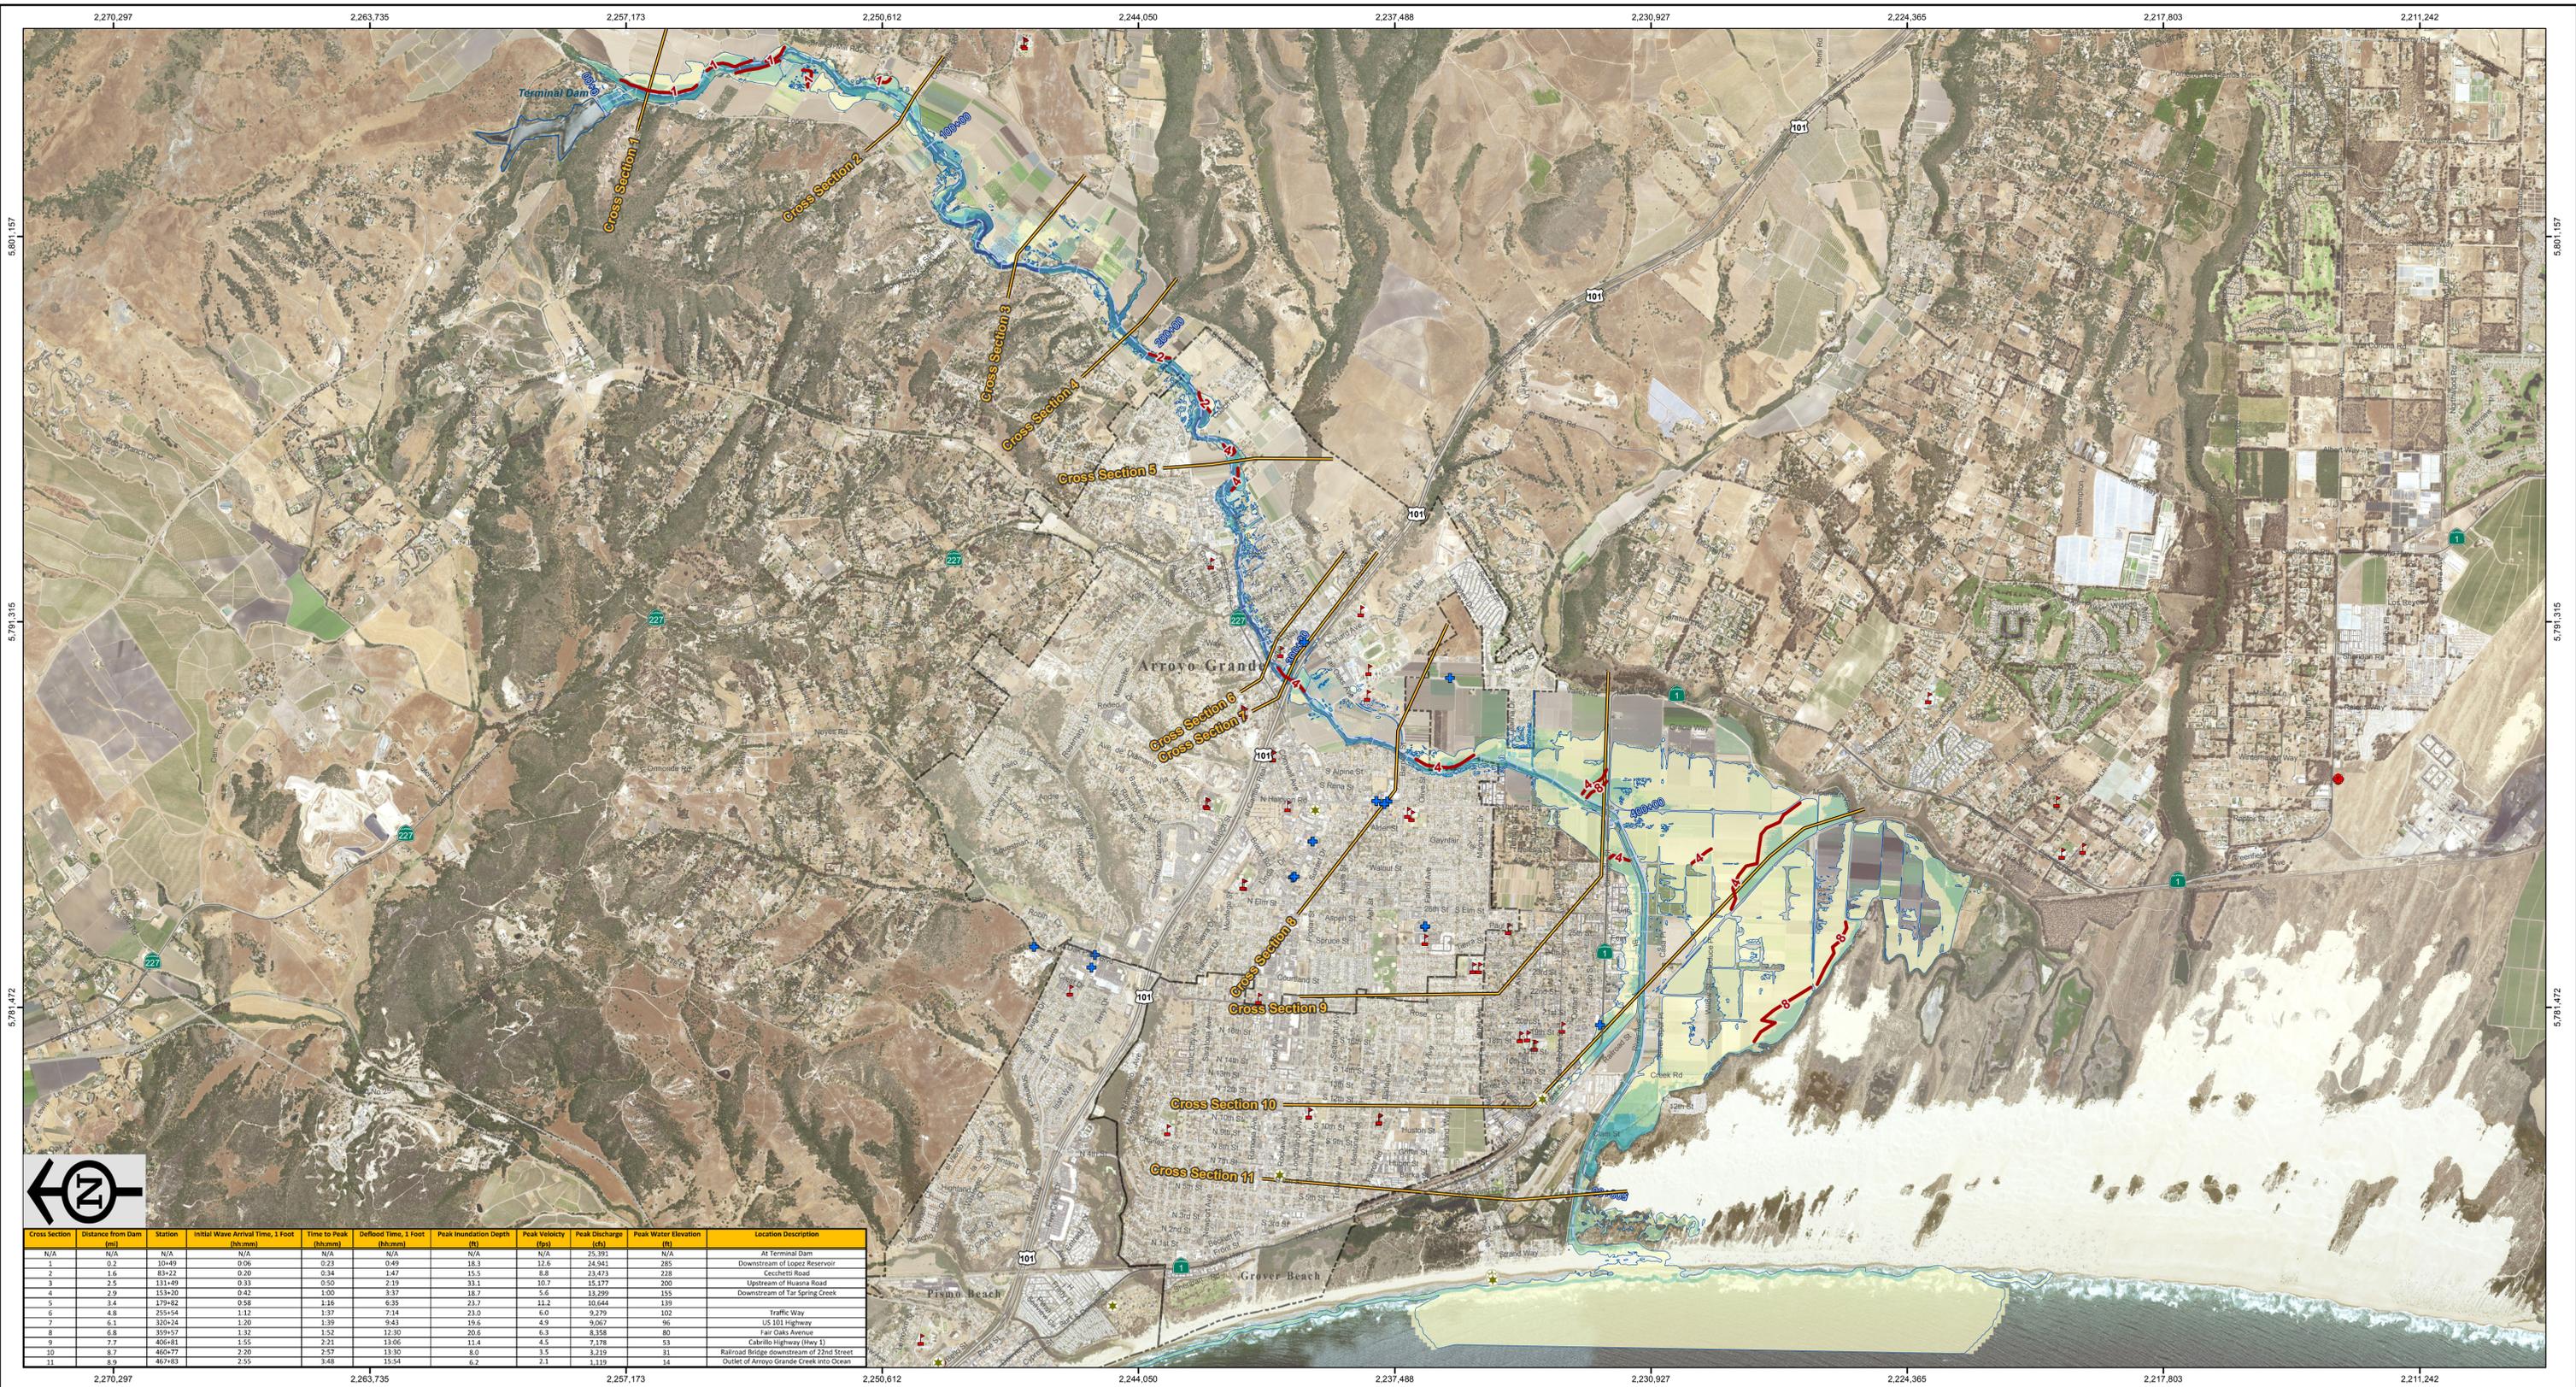


Cross Section	Distance from Dam (mi)	Station	Initial Wave Arrival Time, 1 Foot (hh:mm)	Time to Peak (hh:mm)	Deflood Time, 1 Foot (hh:mm)	Peak Inundation Depth (ft)	Peak Velocity (fps)	Peak Discharge (cfs)	Peak Water Elevation (ft)	Location Description
N/A	N/A	N/A	N/A	N/A	N/A	N/A	N/A	25,391	N/A	At Terminal Dam
1	0.2	10+49	0:26	0:23	0:49	18.3	12.6	24,941	285	Downstream of Lopez Reservoir
2	1.6	83+22	0:20	0:34	1:47	15.5	8.8	23,473	228	Cecchetti Road
3	2.5	131+49	0:33	0:50	2:19	33.1	10.7	15,177	200	Upstream of Husona Road
4	2.9	153+20	0:43	1:00	3:37	18.7	5.6	13,299	155	Downstream of Tar Spring Creek
5	3.4	179+82	0:58	1:16	6:35	23.7	11.2	10,644	139	
6	4.8	255+54	1:12	1:37	7:14	23.0	6.0	9,279	102	Traffic Way
7	6.1	320+24	1:20	1:39	9:43	19.6	4.9	9,067	96	US 101 Highway
8	6.8	359+57	1:34	1:52	12:30	20.6	6.3	8,358	80	Fair Oaks Avenue
9	7.7	406+81	1:55	2:21	13:06	11.4	4.5	7,178	53	Cabrillo Highway (Hwy 1)
10	8.7	460+77	2:20	2:57	13:30	8.0	3.5	3,219	31	Railroad Bridge downstream of 72nd Street
11	8.9	467+83	2:59	3:48	13:54	6.2	2.1	1,119	14	Outlet of Arroyo Grande Creek into Ocean

Notes:

- This map was developed for the benefit of local emergency managers and the California Emergency Management Agency. The information shown is approximate and should be used as a guide for emergency response and preparation purposes.
- The inundation map meets all applicable state and federal standards and has been prepared in consideration of all potential downstream hazards by a licensed civil engineer.
- The results presented herein do not reflect the structural integrity of the dam and are not a statement of the dam's safety. The analysis presented is based on a hypothetical dam failure using 2D modeling software with a 100' grid.
- Cross Section Values:
 - Distance from Dam and Stationing are reckoned from the centerline of Terminal Dam along the displayed Flow Path.
 - Distance from Dam is in miles and Stationing is in feet (Stationing 12+34 = 1,234').
 - Initial Wave Arrival Time, 1 Foot is the time to achieve 1 foot of water depth after initiation of the dam break.
 - Time to Peak is the time to achieve the maximum water depth after initiation of the dam break.
 - Deflood Time, 1 Foot is the time elapsed from the flood wave arrival time until water recedes to within one foot of its pre-flood water elevation.

- Cross Section Values continued:
 - Peak Inundation Depth is the maximum water depth.
 - Peak Velocity is the maximum velocity.
 - Peak Discharge is an estimate of the maximum flow rate integrated over the entire cross section line.
 - Peak Water Elevation is the maximum water surface elevation.
 - Time Above 1 Foot is the time water depth is above 1 foot.
 - Location Description indicates major roads that cross, or are near, the Flow Path at that cross section.
- The values displayed in the table for each cross section are the maximum for that parameter along each cross section line, except for the Initial Wave Arrival Time, 1 Foot and Time to Peak which are the minimum for that parameter along each cross section line. The minimum time values associated with 1D channels embedded in the 2D model are excluded.
- For other details refer to the supporting report "Terminal Dam Failure and Inundation Study" 31 December 2017.
- Structures are shown in the aerial photo on the maps but may not clearly display all possible structures potentially within the inundation limits.
- Map projection: California State Plane, Zone 5, Feet, North American Datum 1983. Reference Points and border ticks display these coordinate values. All elevations are referenced to North American Vertical Datum 1988.

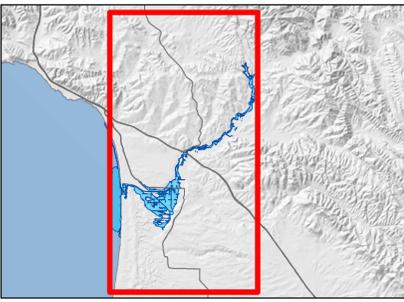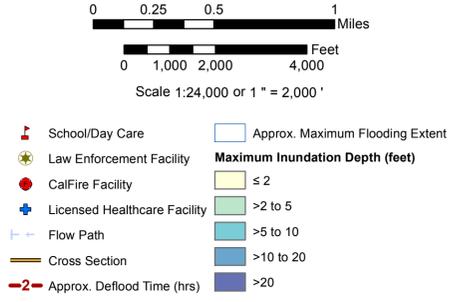

DO NOT DISTRIBUTE THIS MAP OR THE ASSOCIATED MODEL INFORMATION WITHOUT PRIOR NOTIFICATION TO THE FEDERAL DAM OWNER

NOTICE
San Luis Obispo County deems this information to be Confidential. Do not share the information unless prior approval is obtained from SLO County's Dam Safety Officer at (805) 781-5252.

Inundation Depth Map for Fair Weather Hypothetical Failure of Terminal Dam
Flood Depth and Time to Deflood
Federal Dam ID: CA00888 State Dam ID: 1055.002
Detail Sheet 1 of 1
San Luis Obispo County
© 2017 San Luis Obispo County

Rev	Date	Description	Prepared By	Accepted By
	31 December 2017	DRAFT	GEI Consultants	

Dam Owner: San Luis Obispo County Flood Control and Water Conservation District
County Government Center, Room 206
San Luis Obispo, CA 93408
Information Contact: John Diodati, (805) 781-5252
Emergency Contact: (805) 781-5252

Inundation Analysis Performed by and Inundation Maps Created By: GEI Consultants, Inc.
Mark Forthner, PE 48266