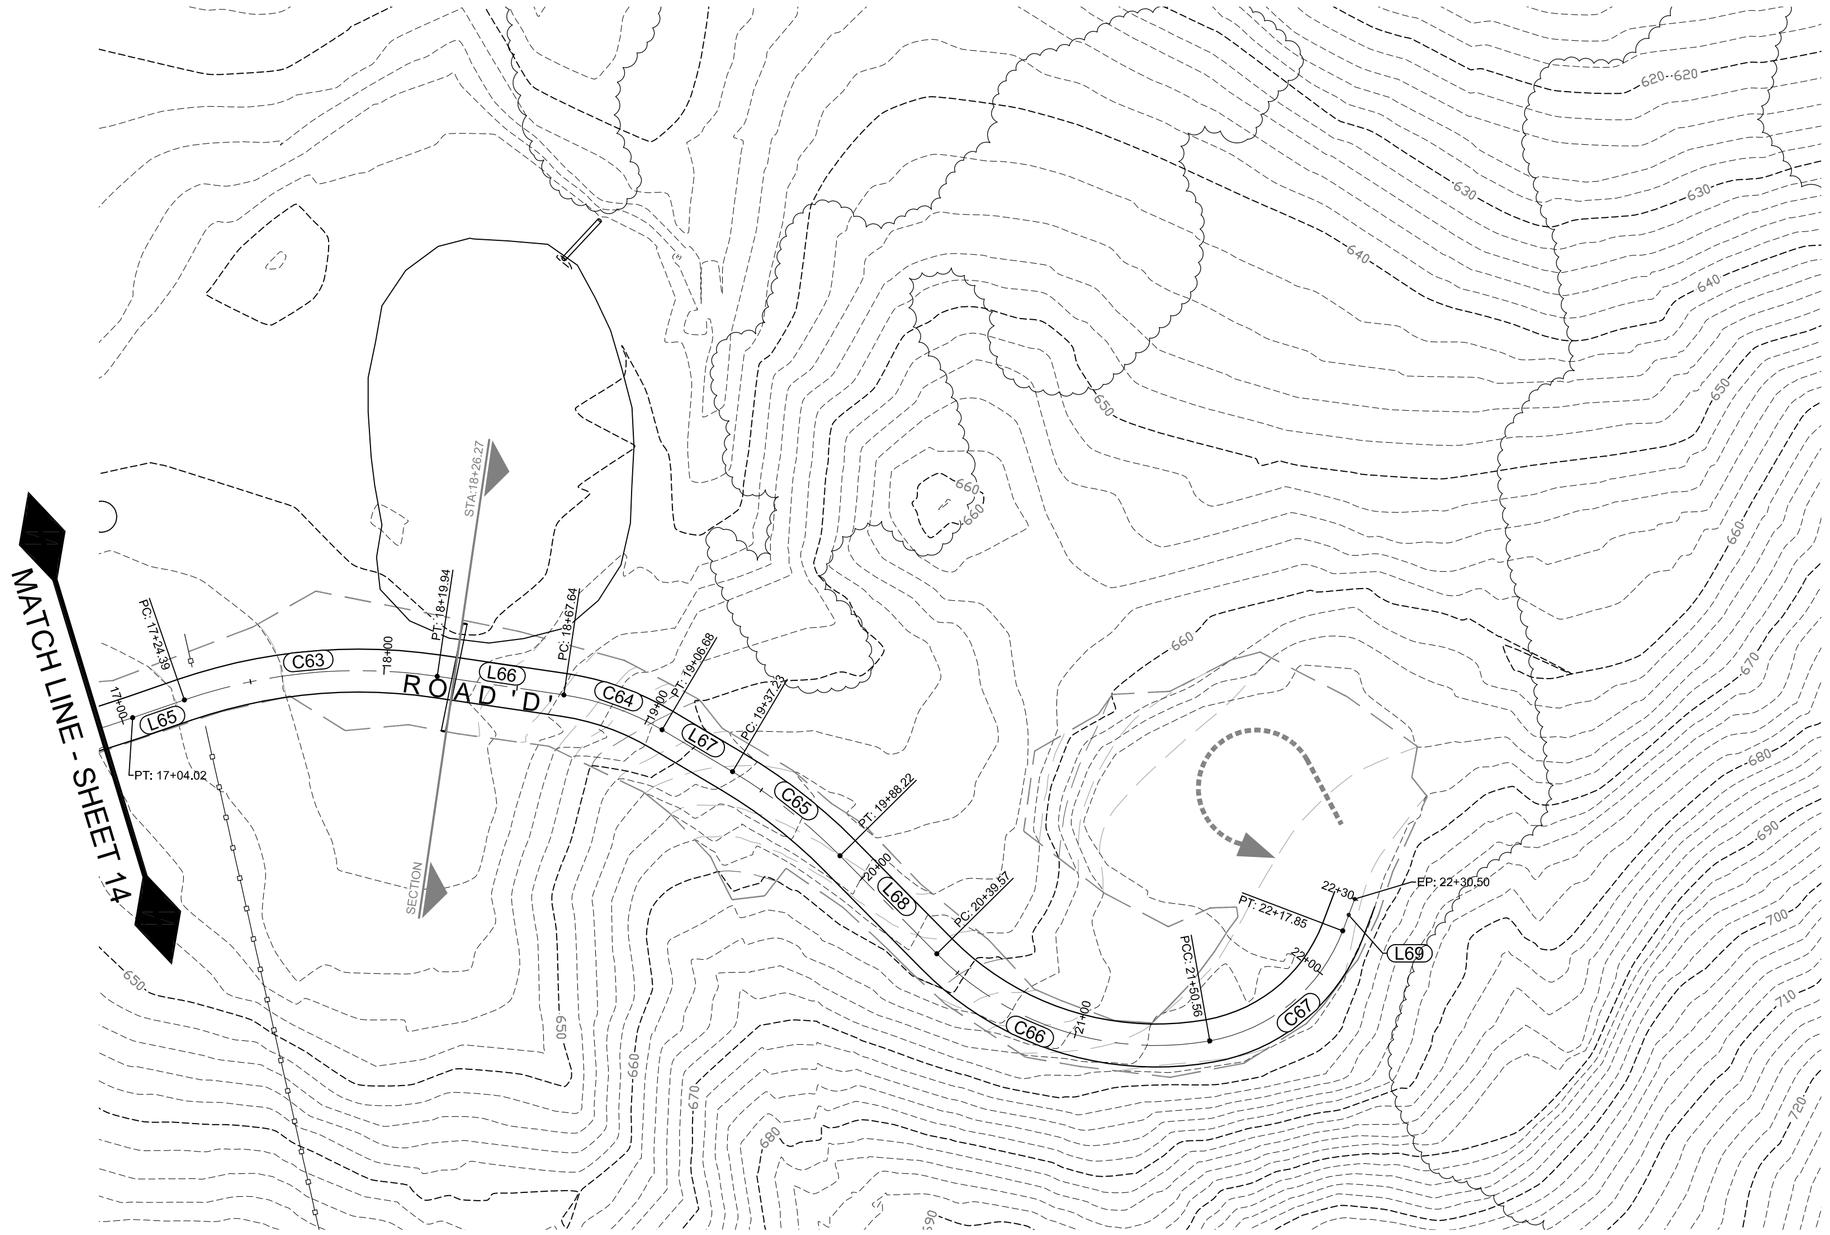

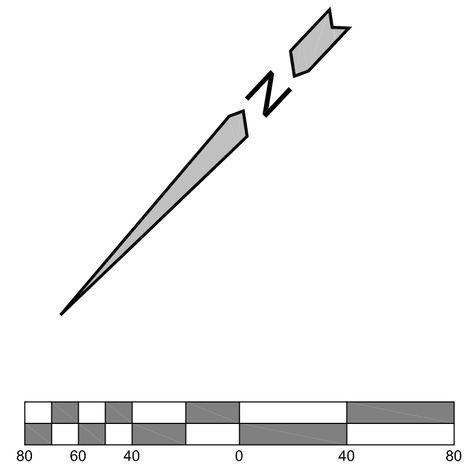

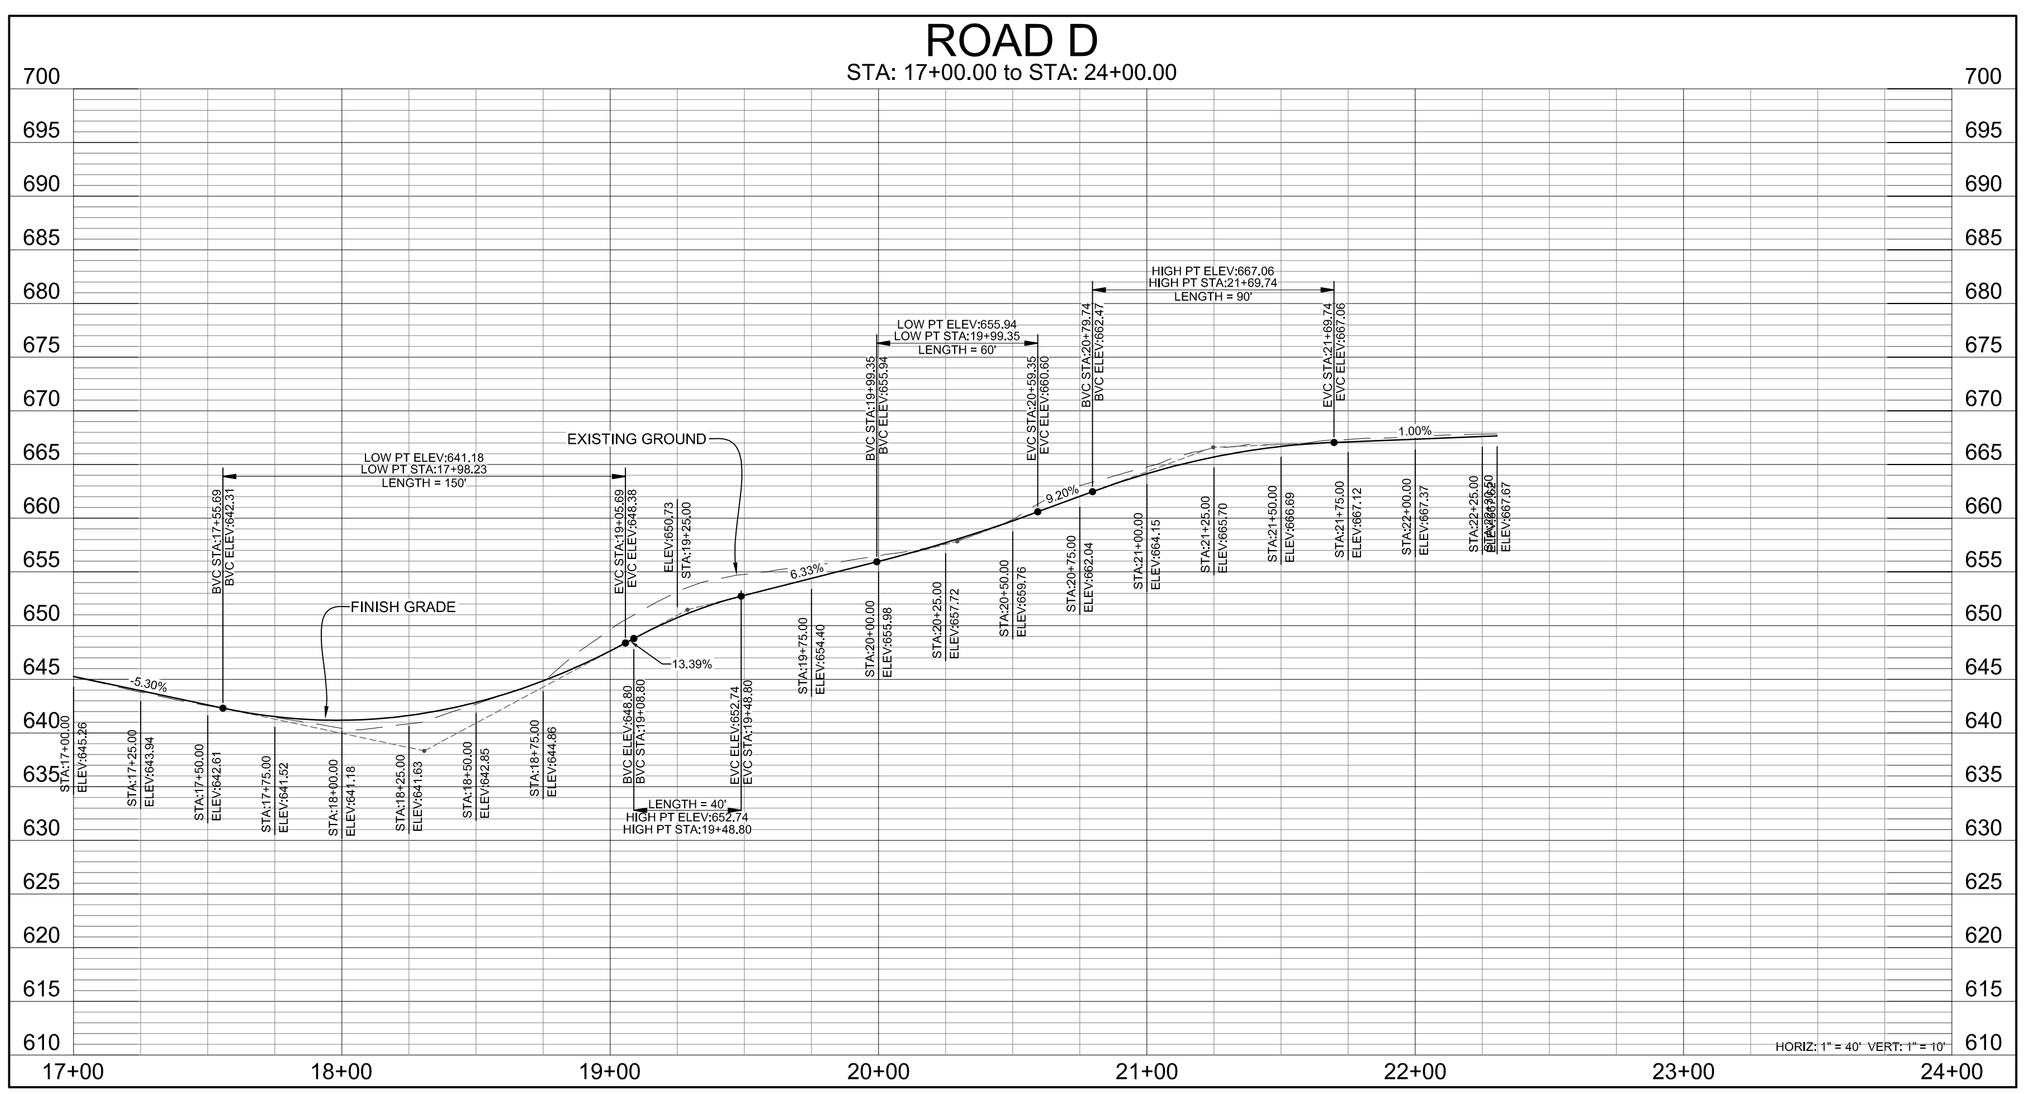

CENTERLINE DATA

ROAD D

SEGMENT	LENGTH	BEARING	RADIUS	DELTA (Δ)
L65	20.38'	S27°38'07"W	- - -	- - -
C63	95.55'	- - -	200.00	27°22'22"
L66	47.70'	S55°00'29"W	- - -	- - -
C64	39.04'	- - -	100.00	22°22'07"
L67	30.55'	S77°22'36"W	- - -	- - -
C65	50.99'	- - -	200.00	14°36'27"
L68	51.36'	N88°00'57"W	- - -	- - -
C66	110.99'	- - -	115.00	55°17'52"
C67	67.29'	- - -	65.00	59°18'36"
L69	12.65'	S22°37'25"E	- - -	- - -

SWALE SECTION

SCOPE OF WORK

AS-BUILT PLAN:

CUT:	441 CY
FILL:	576 CY
TOTAL EARTHWORK:	1017 CY

REMEDIAL WORK:

AREA - NO REMEDIAL WORK BETWEEN STA 17+00 TO END

NOTE: EXTENT OF REMEDIAL WORK TO BE CONSIDERED PER ENGINEERING GEOLOGIST AT THE TIME OF MITIGATION. SEE GEOSOLUTIONS GEOLOGY REPORT NO. SLO6539-3, 2-26-10.

TOTAL REMEDIAL EARTHWORK

TOTAL EARTHWORK: 0 CY

REVISION	DESCRIPTION	ISSUE DATE	BY

PROJECT ENGINEER

DATED

REGISTERED PROFESSIONAL ENGINEER
MATT PRIESS
RCE 69213
Exp. 6/30/10
CIVIL
STATE OF CALIFORNIA

GRANITE RIDGE
ENGINEERING GROUP
240 DAFFODIL AVE. NIPOMO CA 93444
(805) 720-2958 www.graniteridgegroup.com

ROAD D
STA 17+00 TO END

VERFIY SCALE
BAR IS ONE INCH
0 1"

SHEET DATA	
Job Name:	MIRAMONTE RANCH
Cad File:	AS BUILT GRADING
Plot Date:	5-11-2010
Drawn By:	MP
Sheet	15 OF 21

THIS DOCUMENT, AND THE IDEAS AND DESIGNS INCORPORATED HEREIN, IN WHOLE OR IN PART, IS THE PROPERTY OF G.R.E.G.

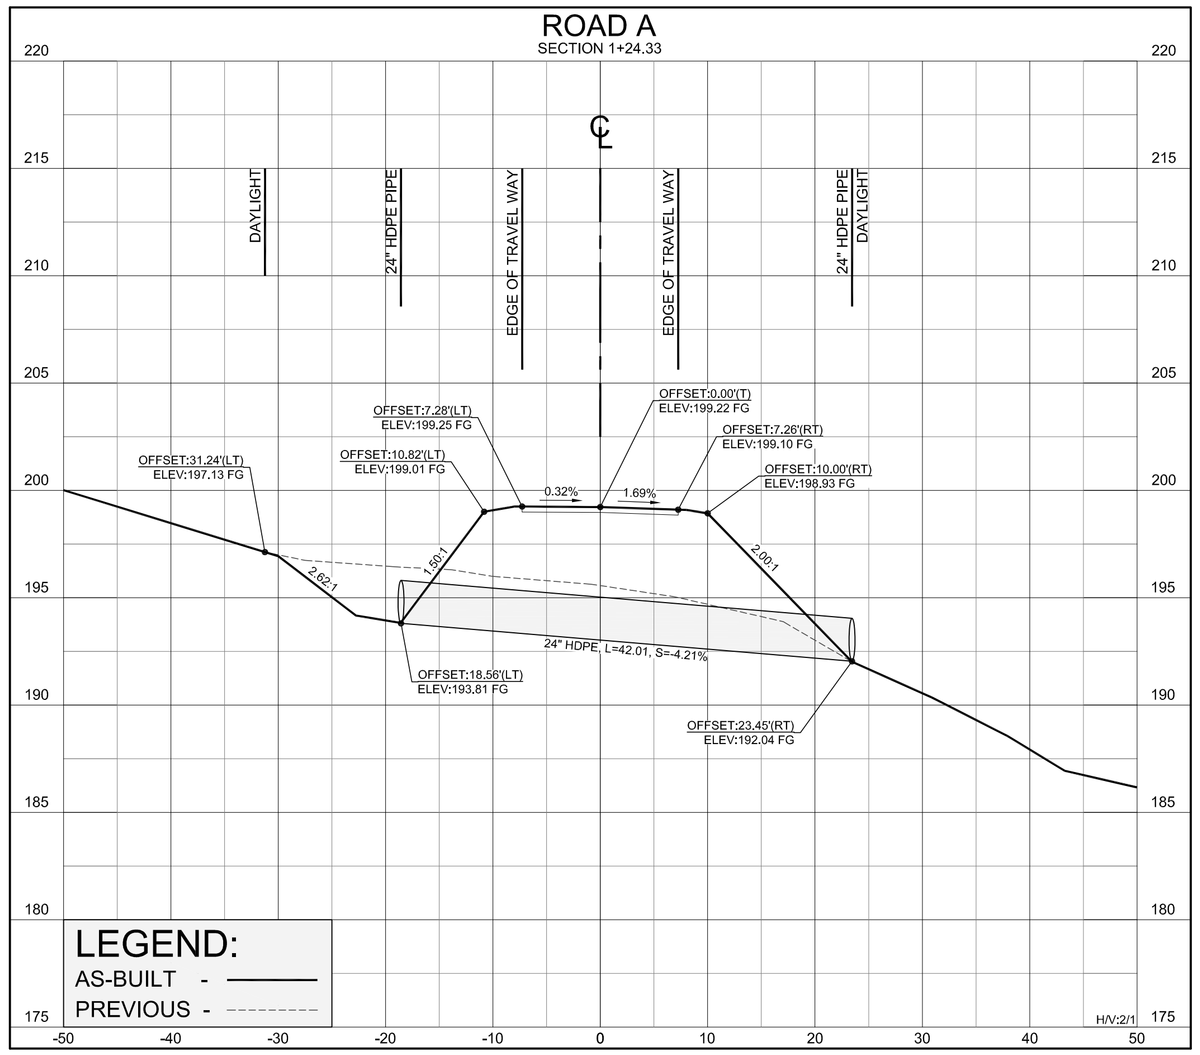

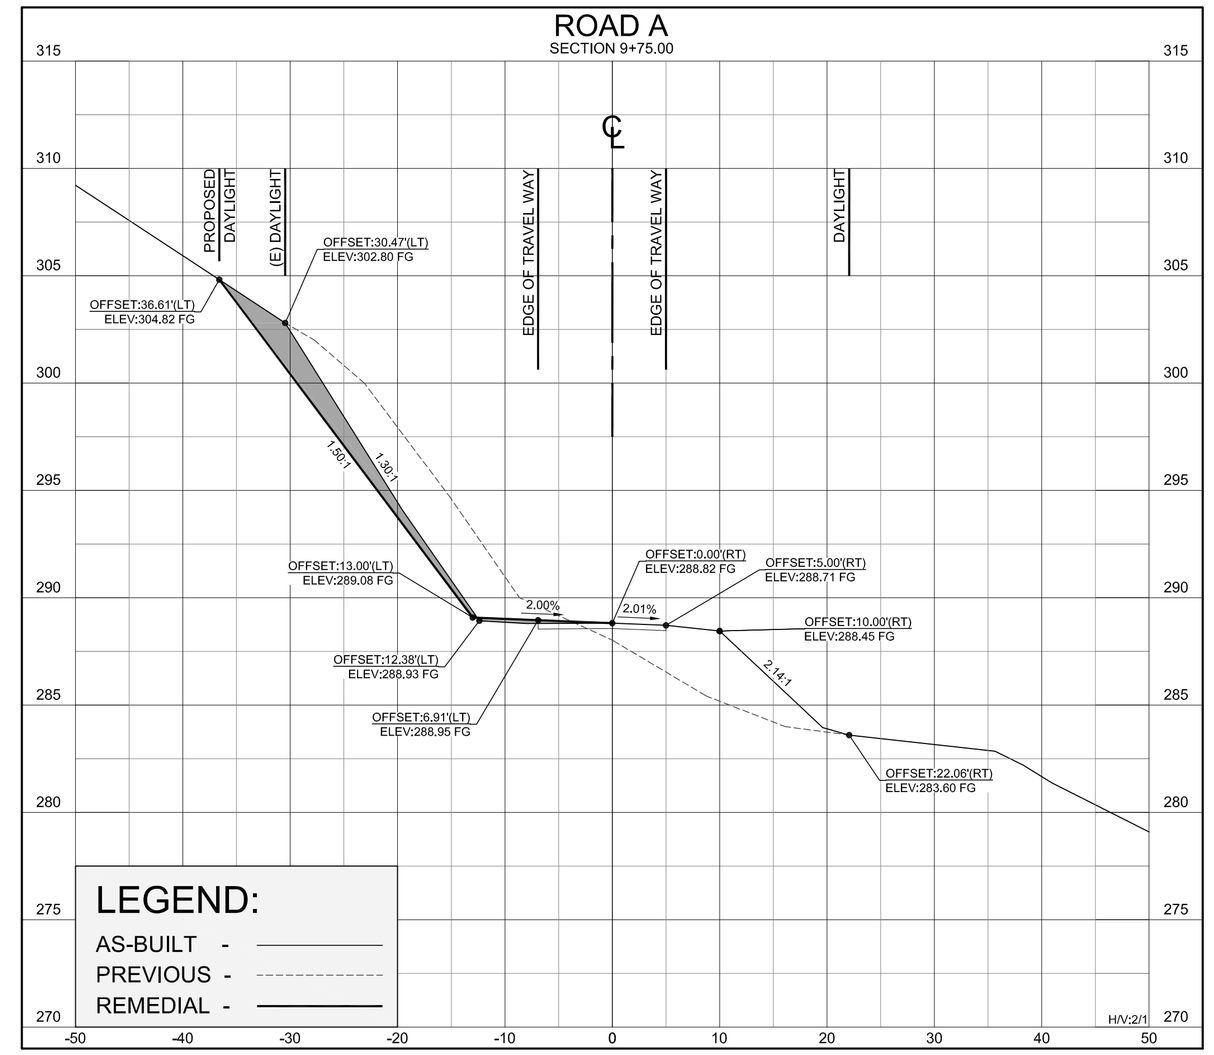

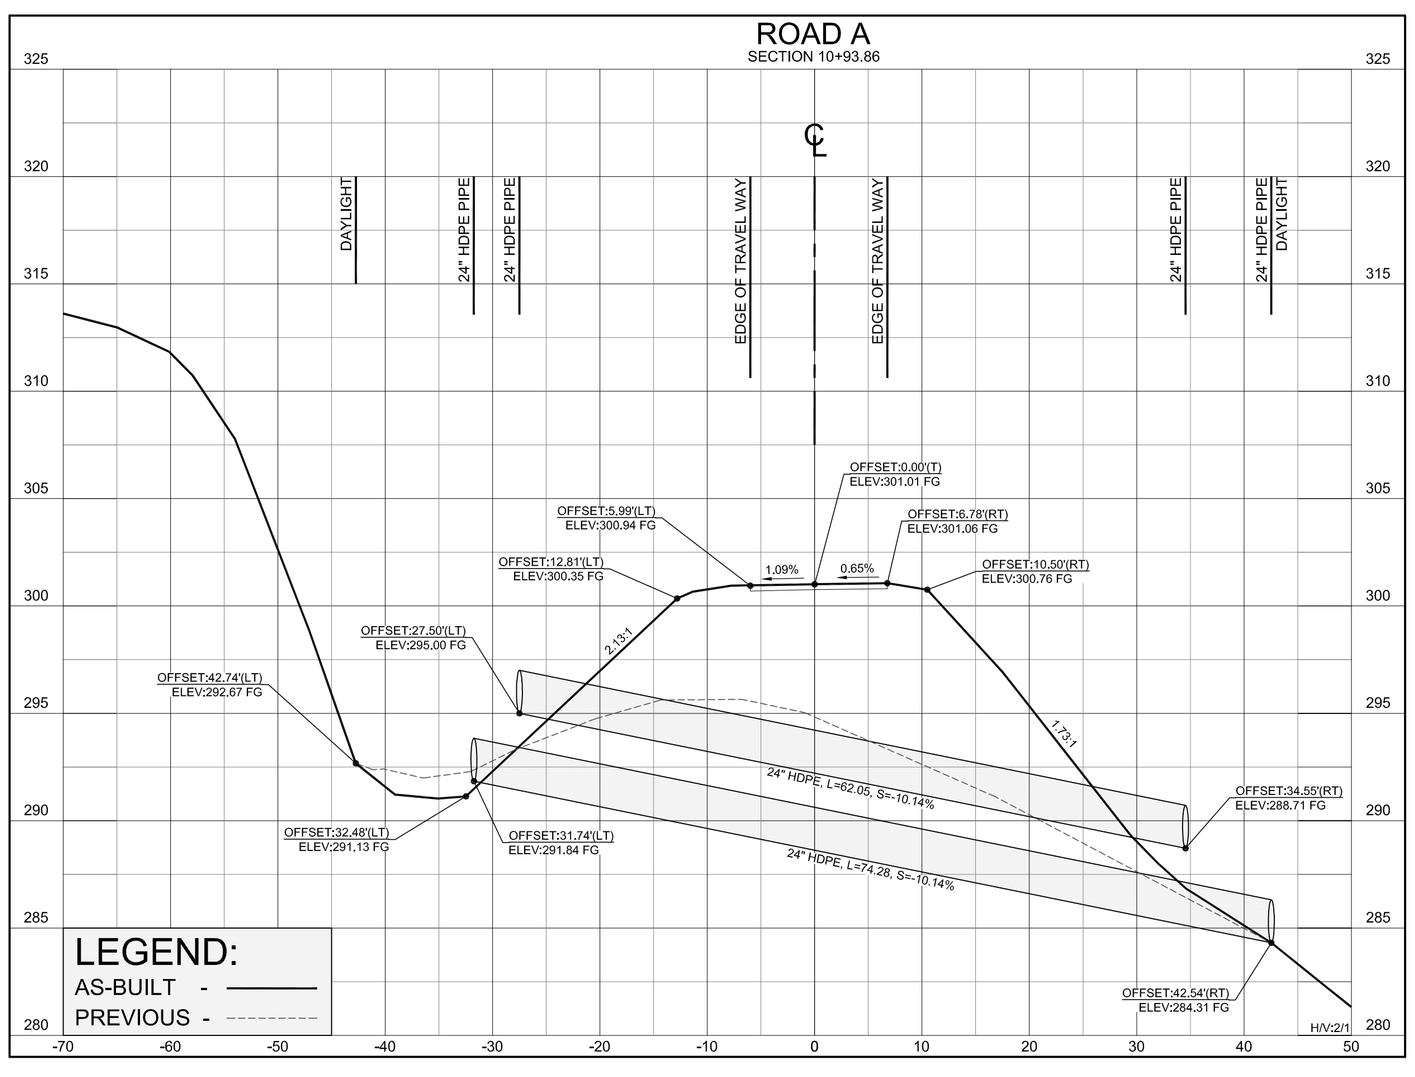

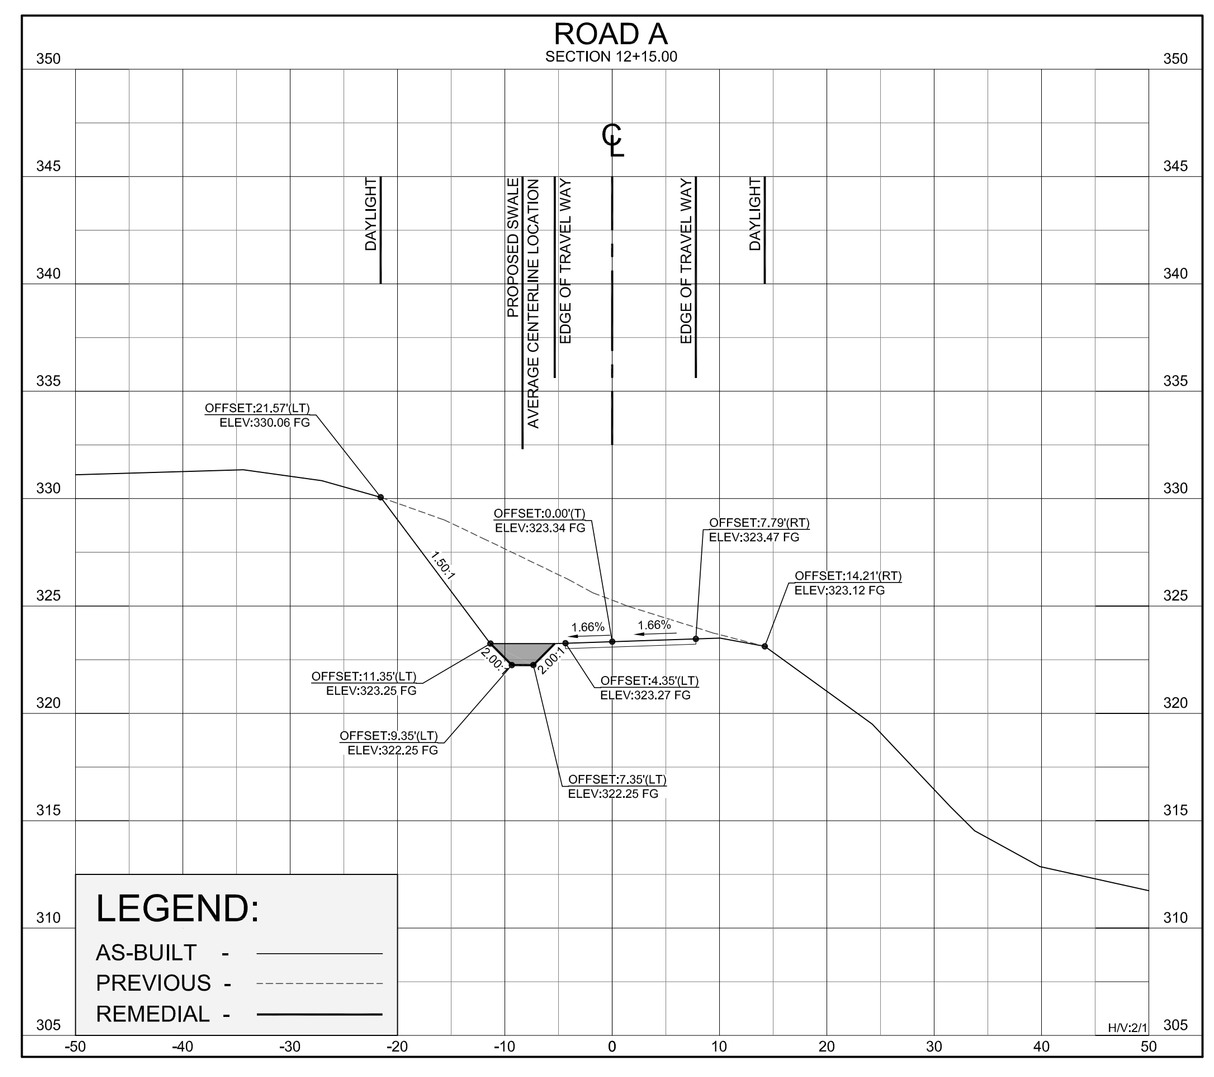

AS-BUILT SECTIONS

REMEDIAL WORK SECTIONS

REVISION

REVISION	DESCRIPTION	ISSUE DATE	BY

PROJECT ENGINEER

DATED

REGISTERED PROFESSIONAL ENGINEER * MATT PRIESS * RCE 69213 Exp. 6/30/10 CIVIL * STATE OF CALIFORNIA

GRANITE RIDGE
ENGINEERING GROUP
240 DAFFODIL AVE. NIPOMO CA 93444
(805) 720-2958 www.graniteridgegroup.com

ROAD 'A' SECTIONS
(1+24.33) (9+75) (10+93.86) (12+15)

VERFIY SCALE
BAR IS ONE INCH
0 1"

SHEET DATA

Job Name:	MIRAMONTE RANCH
Cad File:	AS BUILT GRADING
Plot Date:	5-11-2010
Drawn By:	MP
Sheet	16 OF 21

THIS DOCUMENT, AND THE IDEAS AND DESIGNS INCORPORATED HEREIN, IN WHOLE OR IN PART, IS THE PROPERTY OF G.R.E.G.

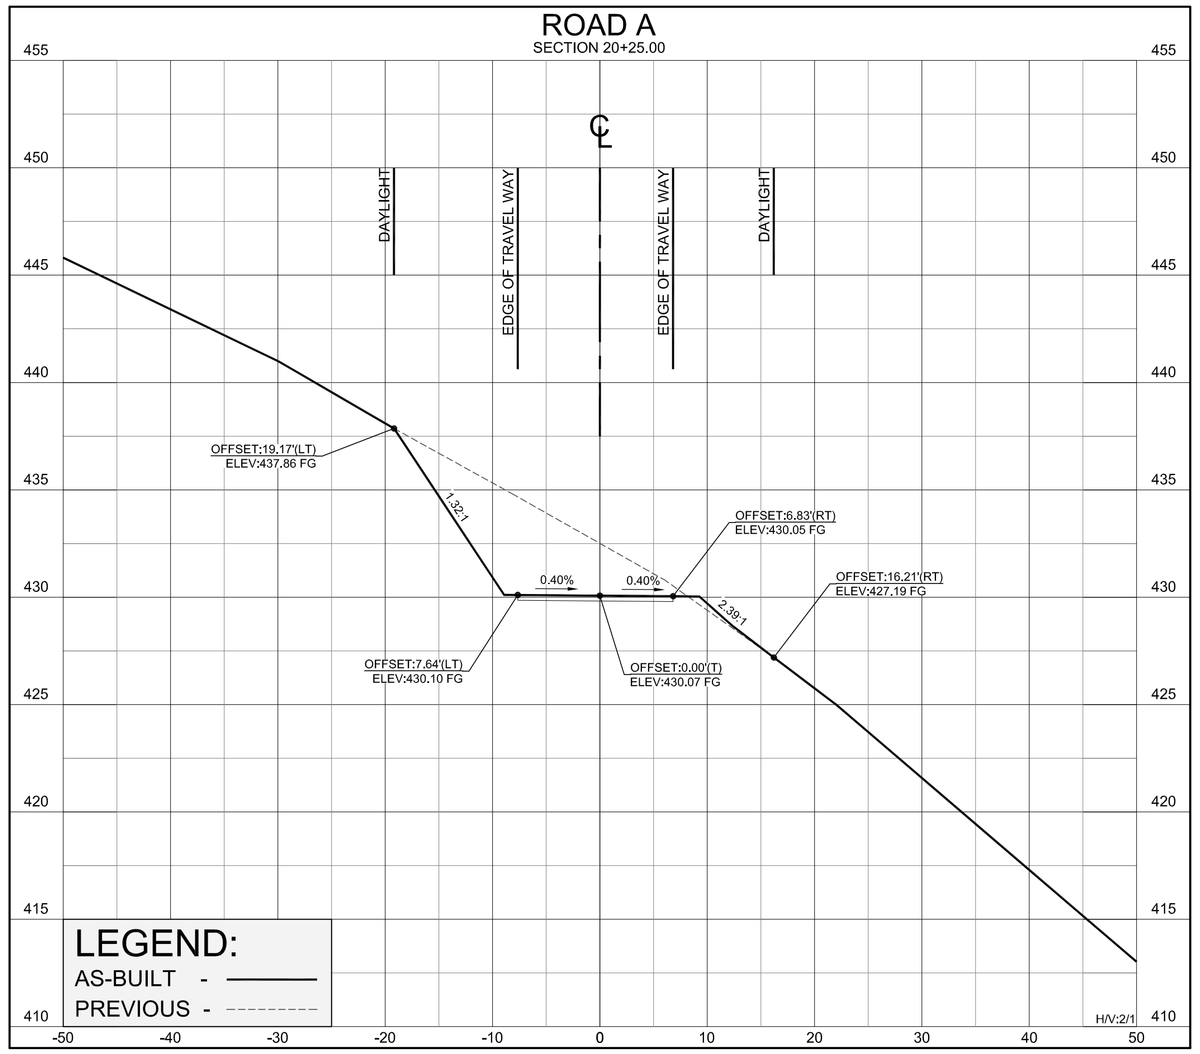

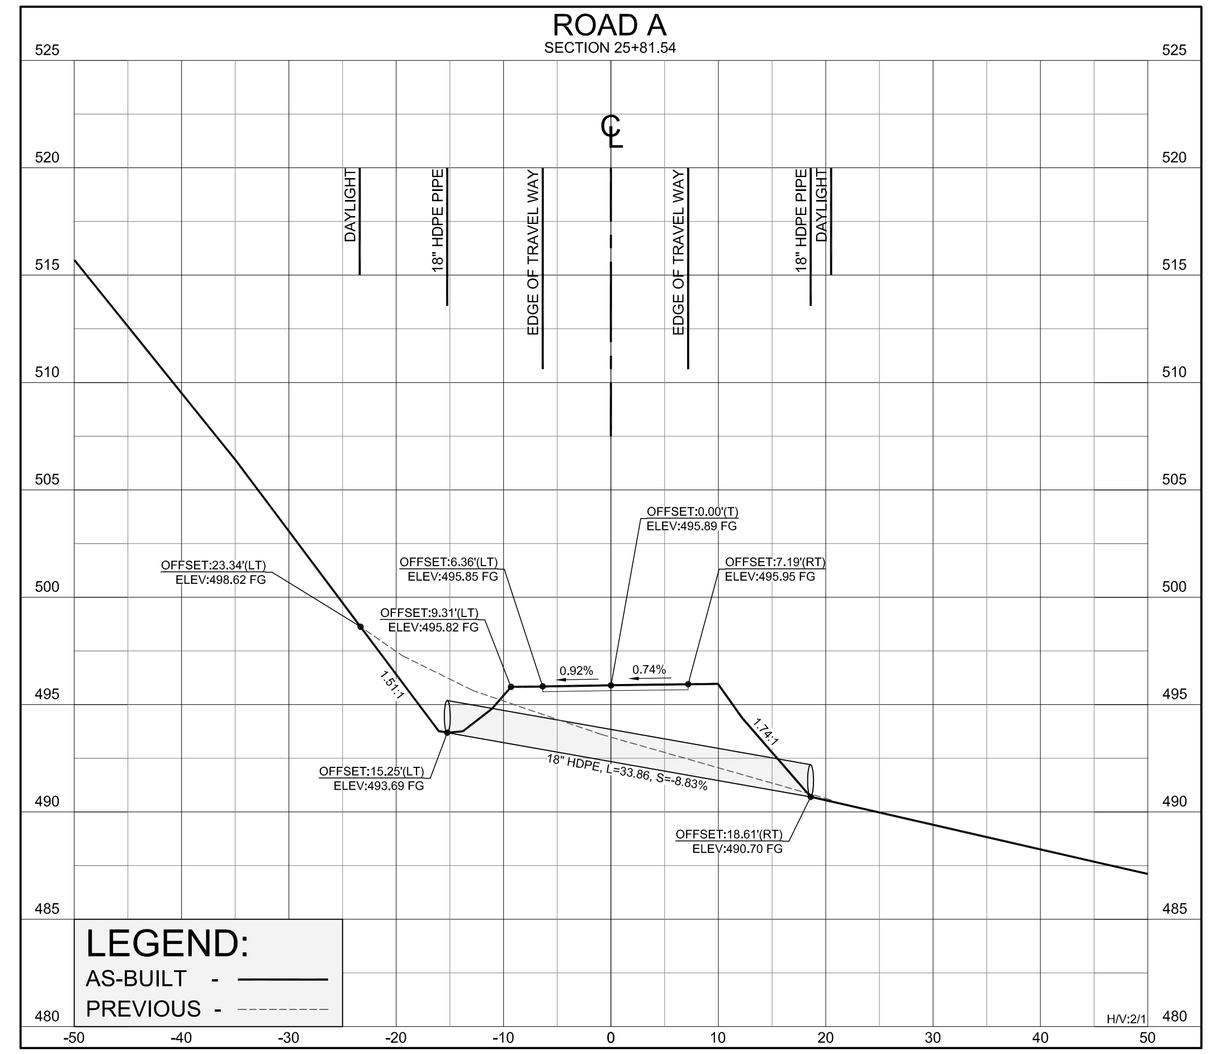

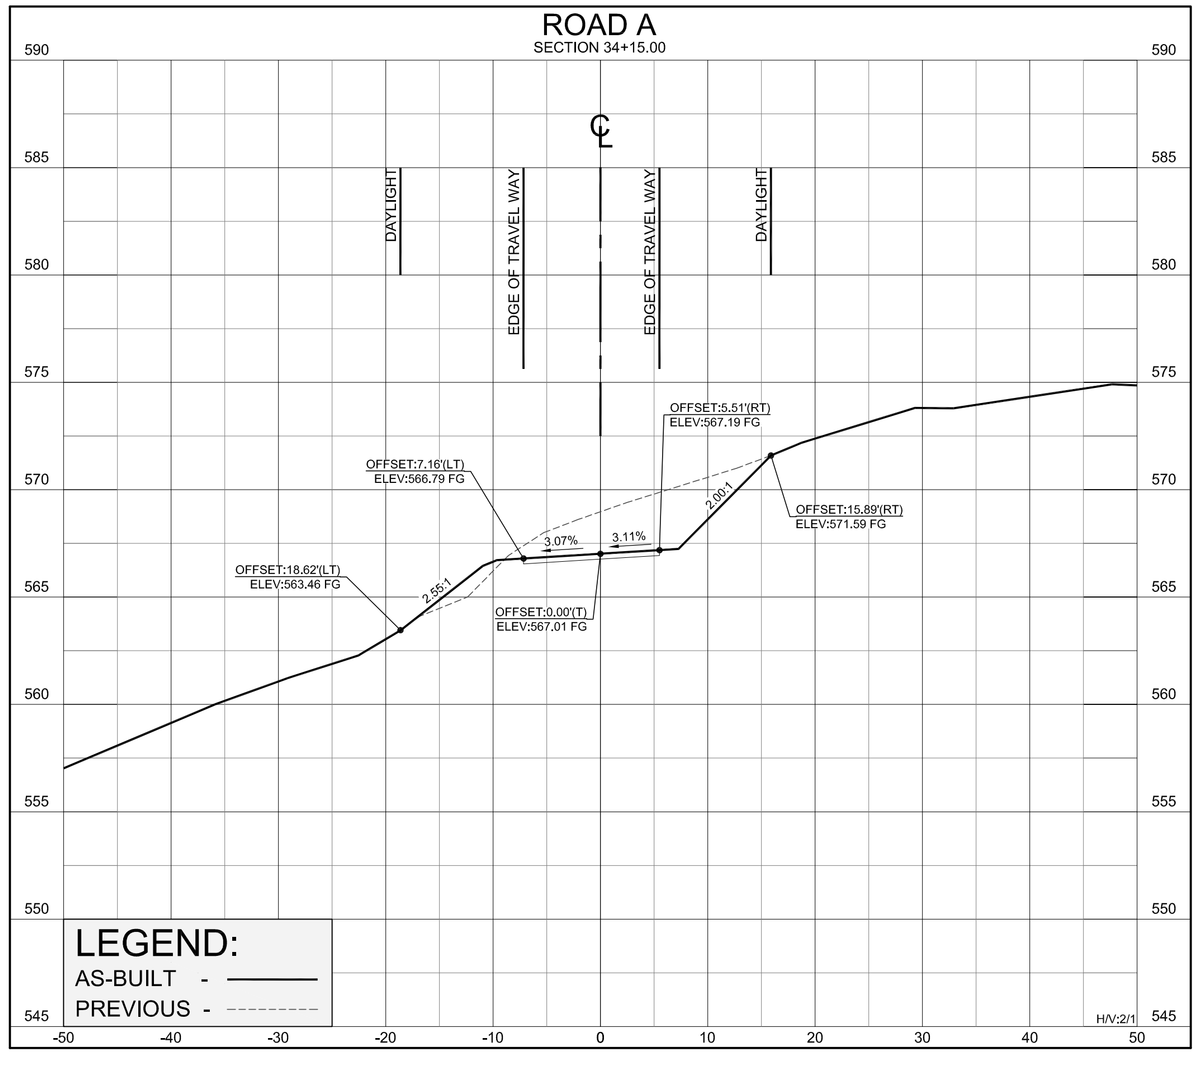

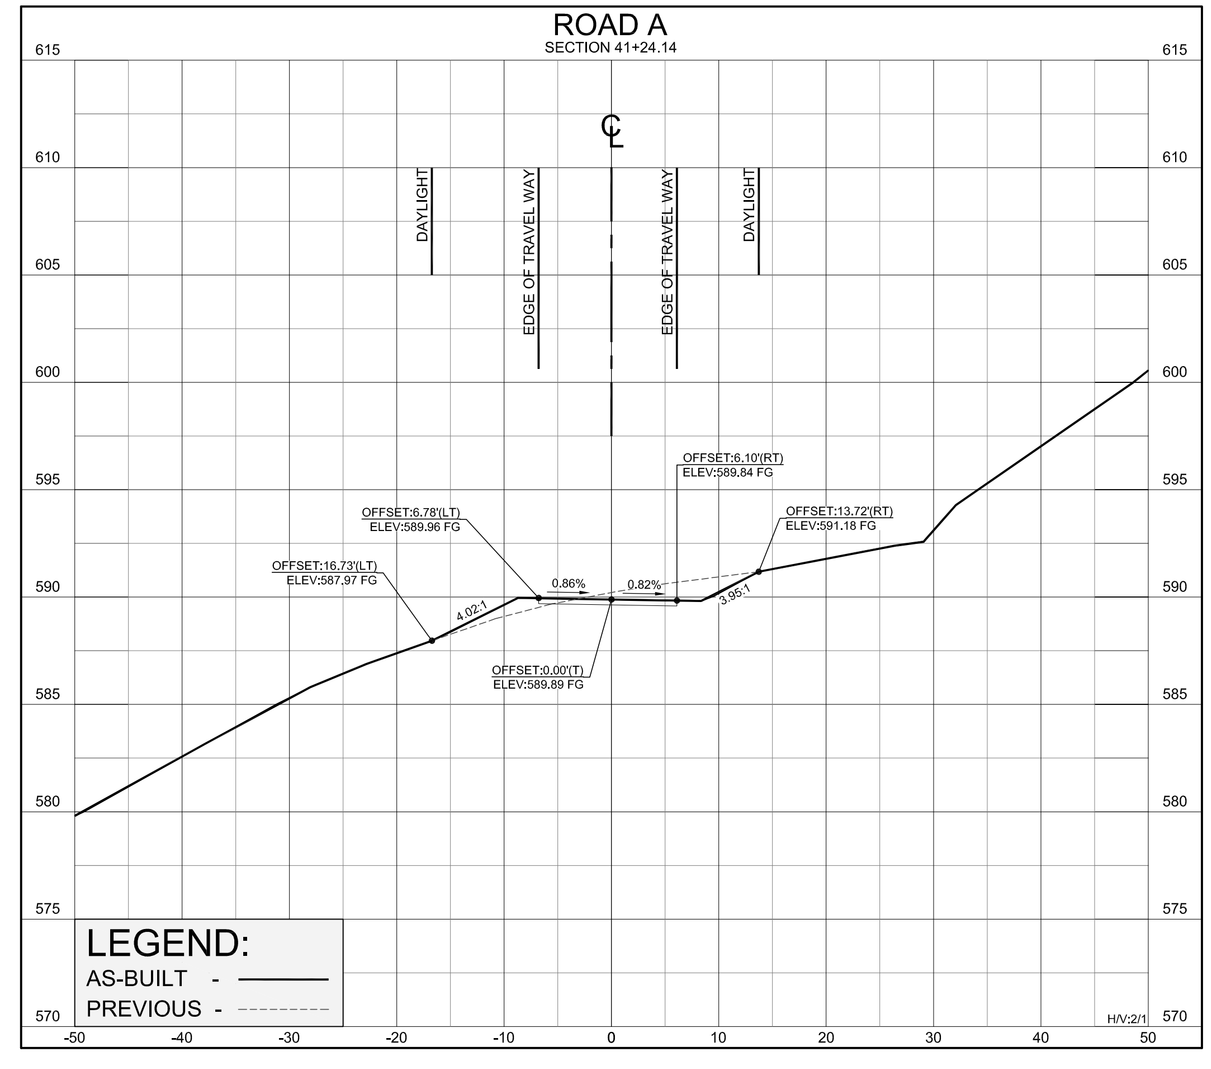

AS-BUILT SECTIONS

REVISION	DESCRIPTION	ISSUE DATE	BY

REVISION

PROJECT ENGINEER

DATED

REGISTERED PROFESSIONAL ENGINEER • JAY PRIESS • RCE 69213 Exp. 6/30/10 • CIVIL • STATE OF CALIFORNIA

GRANITE RIDGE ENGINEERING GROUP
240 DAFFODIL AVE. NIPOMO CA 93444
(805) 720-2958 www.graniteridgegroup.com

ROAD 'A' SECTIONS
(20+25) (25+81.54) (34+15) (41+24.14)

VERFIY SCALE
BAR IS ONE INCH
0 1"

SHEET DATA

Job Name:	MIRAMONTE RANCH
Cad File:	AS BUILT GRADING
Plot Date:	5-11-2010
Drawn By:	MP
Sheet	17 OF 21

THIS DOCUMENT, AND THE IDEAS AND DESIGNS INCORPORATED HEREIN, IN WHOLE OR IN PART, IS THE PROPERTY OF G.R.E.G.

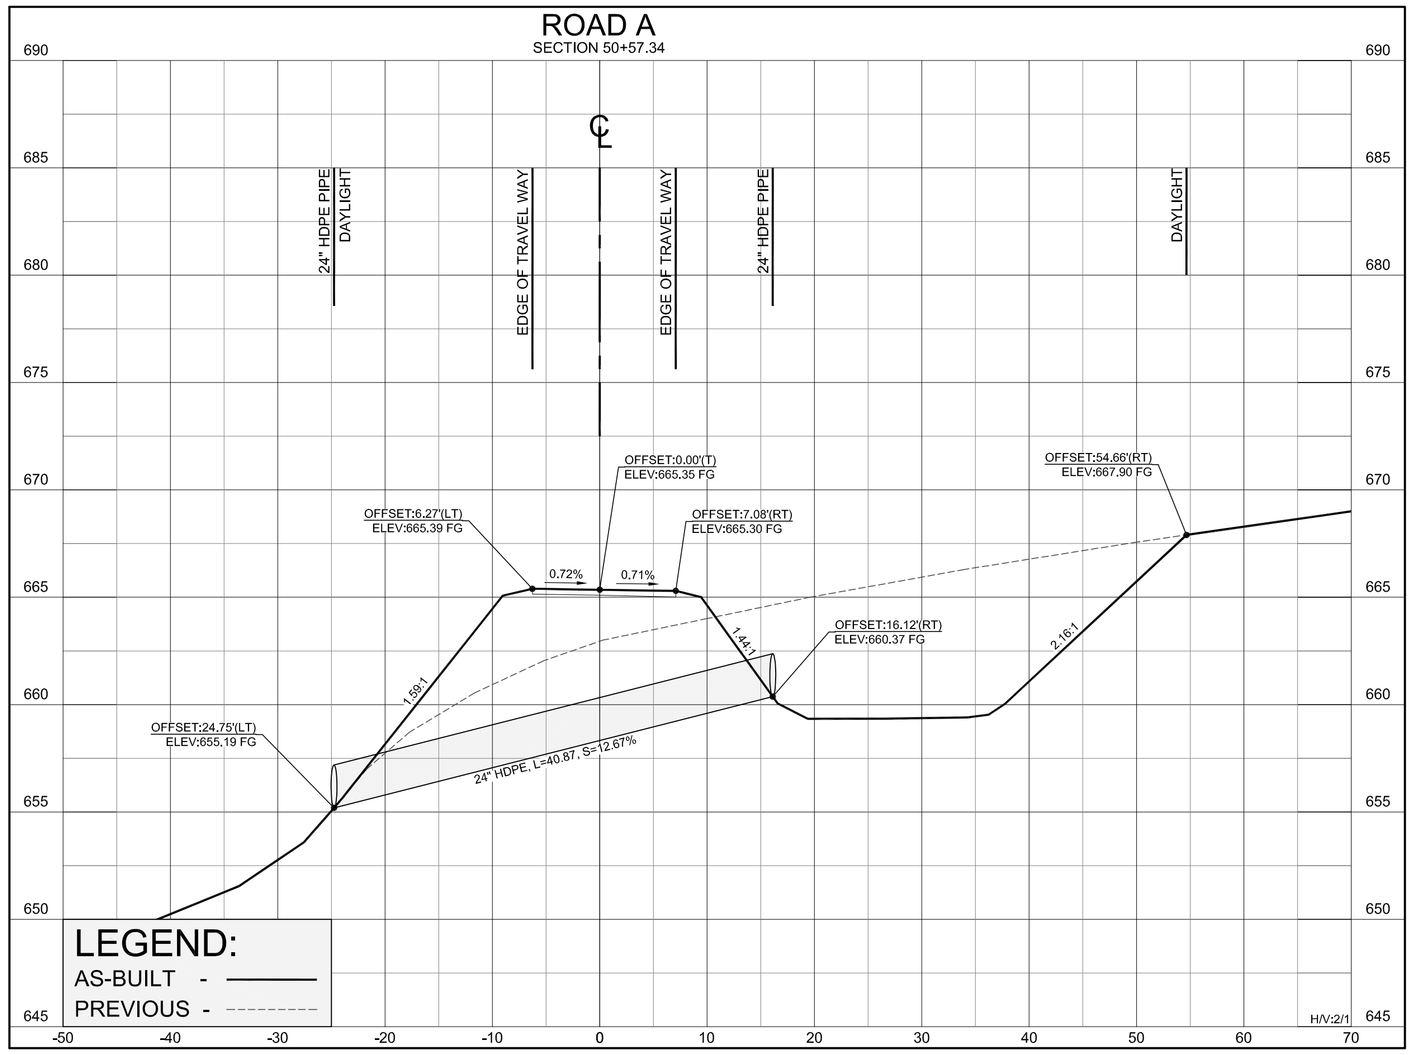

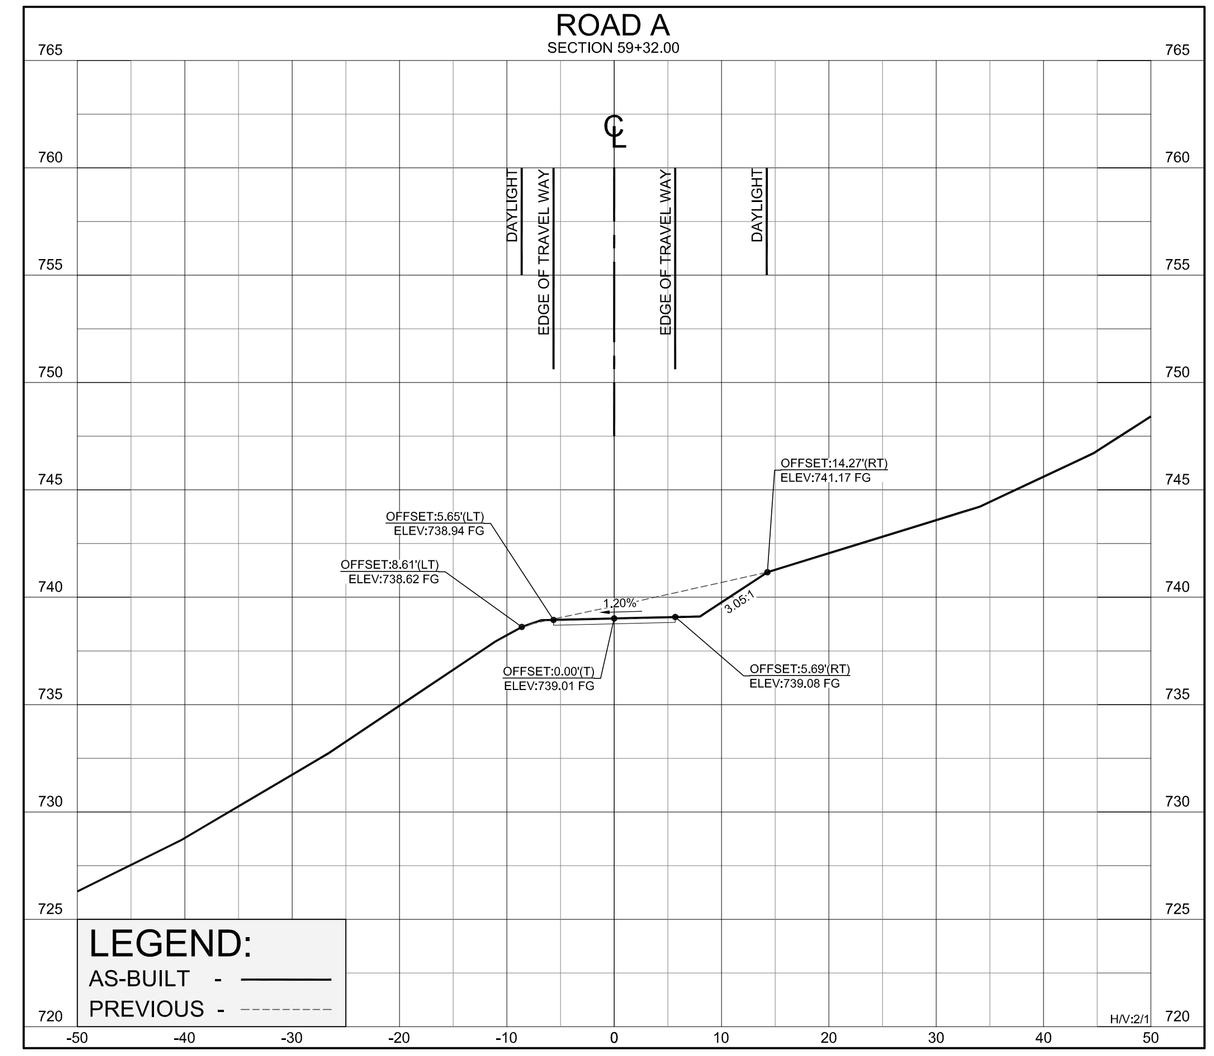

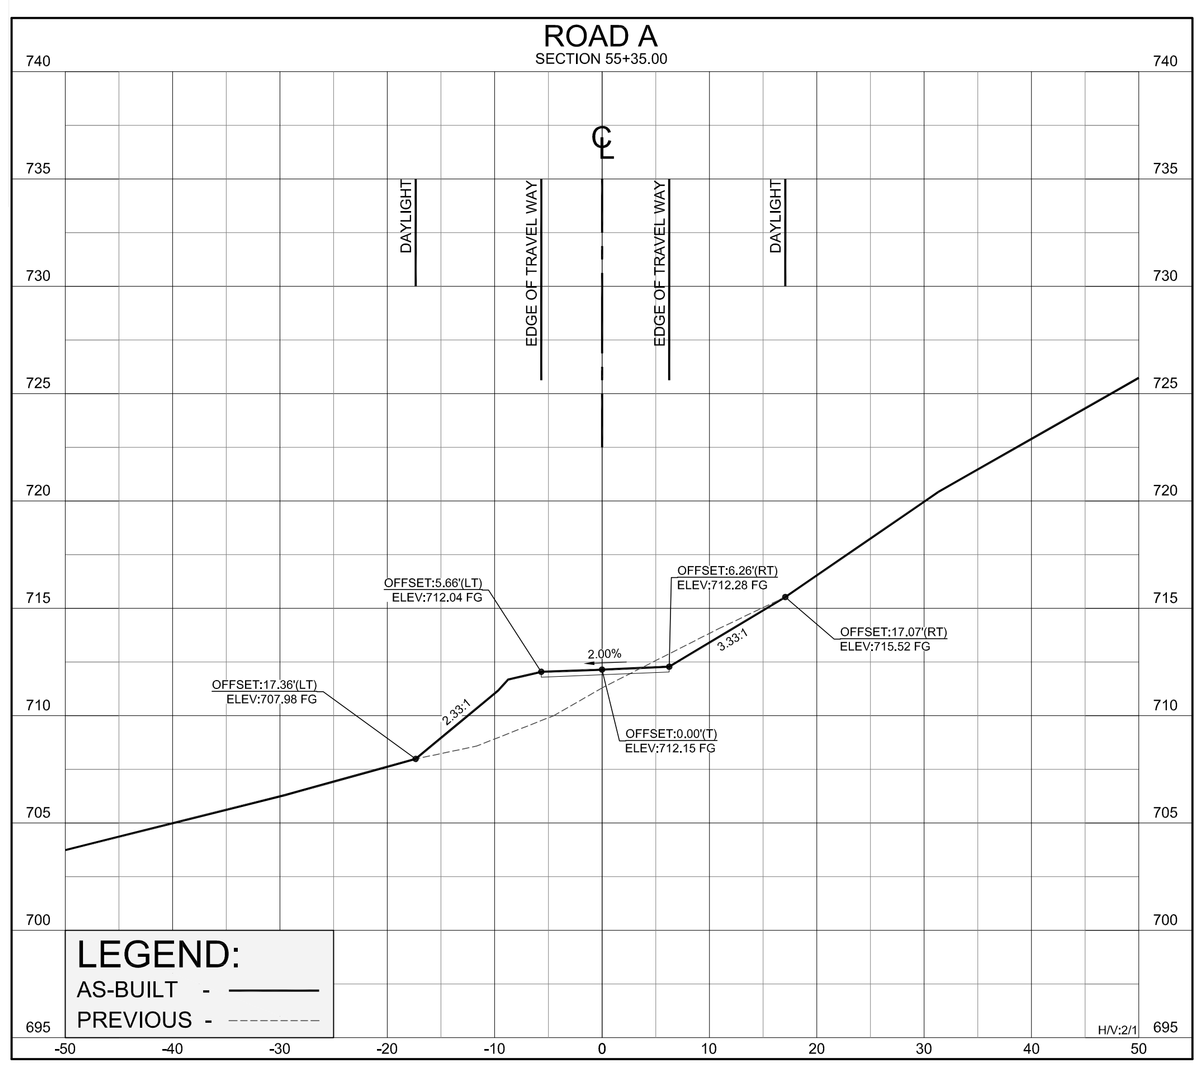

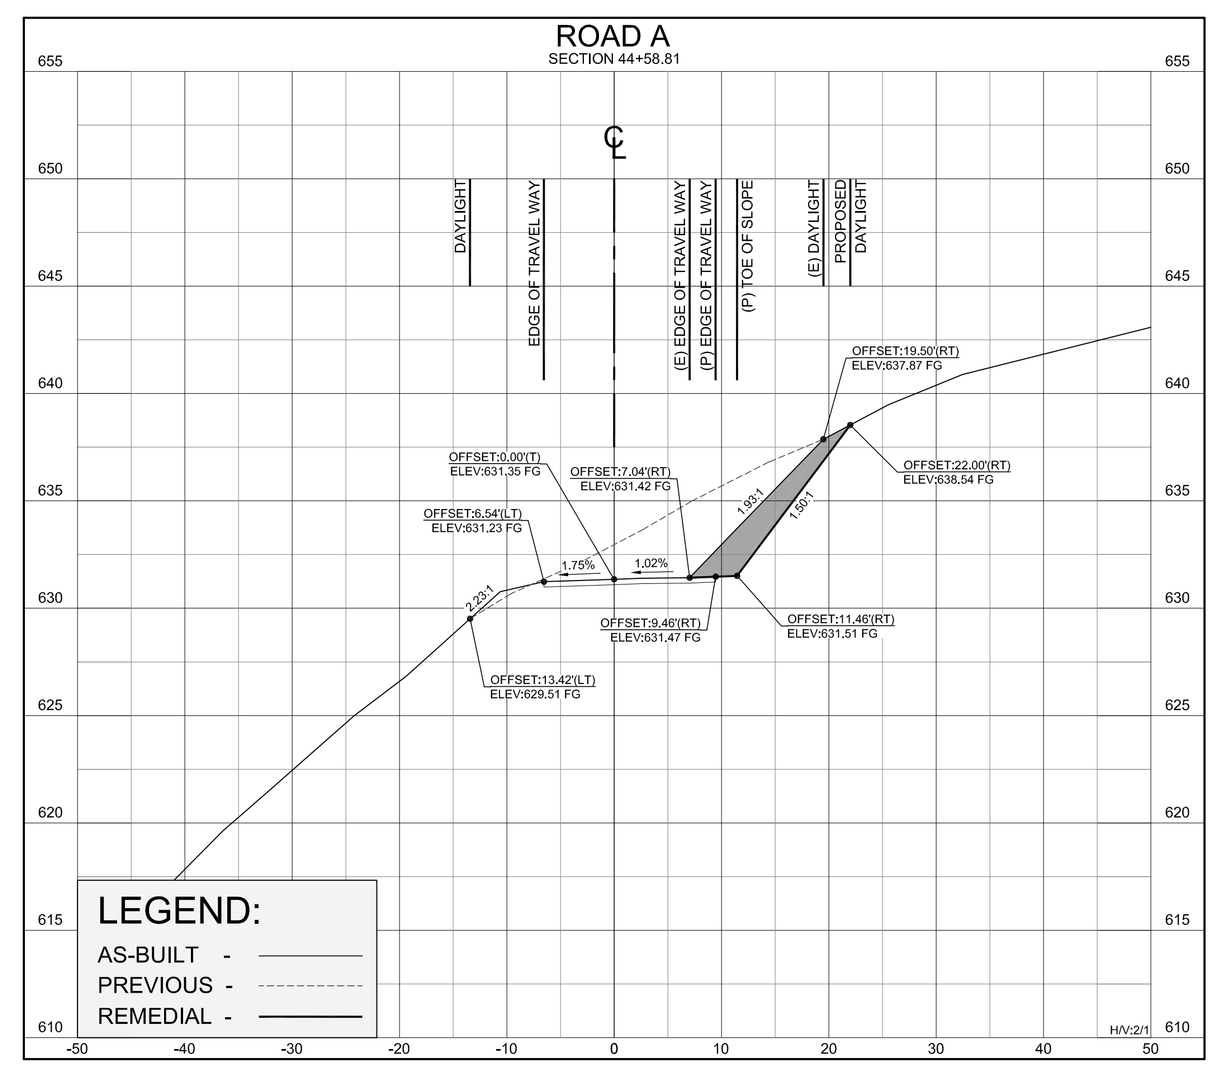

AS-BUILT SECTIONS

REMEDIAL WORK SECTION

REVISION	DESCRIPTION	ISSUE DATE	BY

REVISION

PROJECT ENGINEER

DATED

REGISTERED PROFESSIONAL ENGINEER • JAY T. PRIESS • RCE 69213 Exp. 6/30/10 • CIVIL • STATE OF CALIFORNIA

GRANITE RIDGE ENGINEERING GROUP
240 DAFFODIL AVE. NIPOMO CA 93444
(805) 720-2958 www.graniteridgegroup.com

ROAD 'A' SECTIONS
(44+58.81)(50+57.34)(55+35)(59+32)

VERFIY SCALE
BAR IS ONE INCH
0 1"

SHEET DATA	
Job Name:	MIRAMONTE RANCH
Cad File:	AS BUILT GRADING
Plot Date:	5-11-2010
Drawn By:	MP
Sheet	18 OF 21

THIS DOCUMENT, AND THE IDEAS AND DESIGNS INCORPORATED HEREIN, IN WHOLE OR IN PART, IS THE PROPERTY OF G.R.E.G.

ROAD 'B'
AS-BUILT SECTIONS

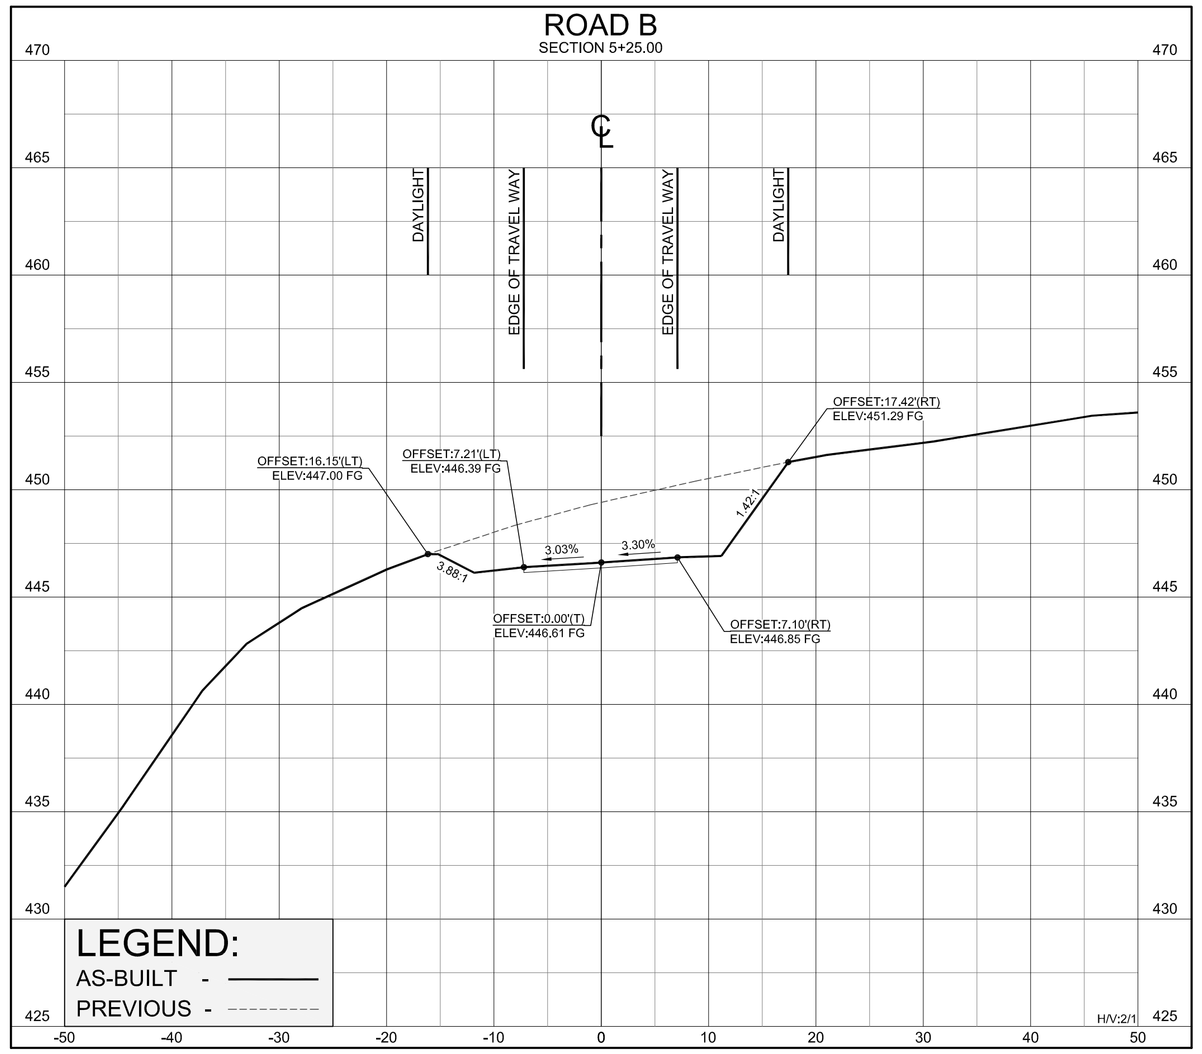

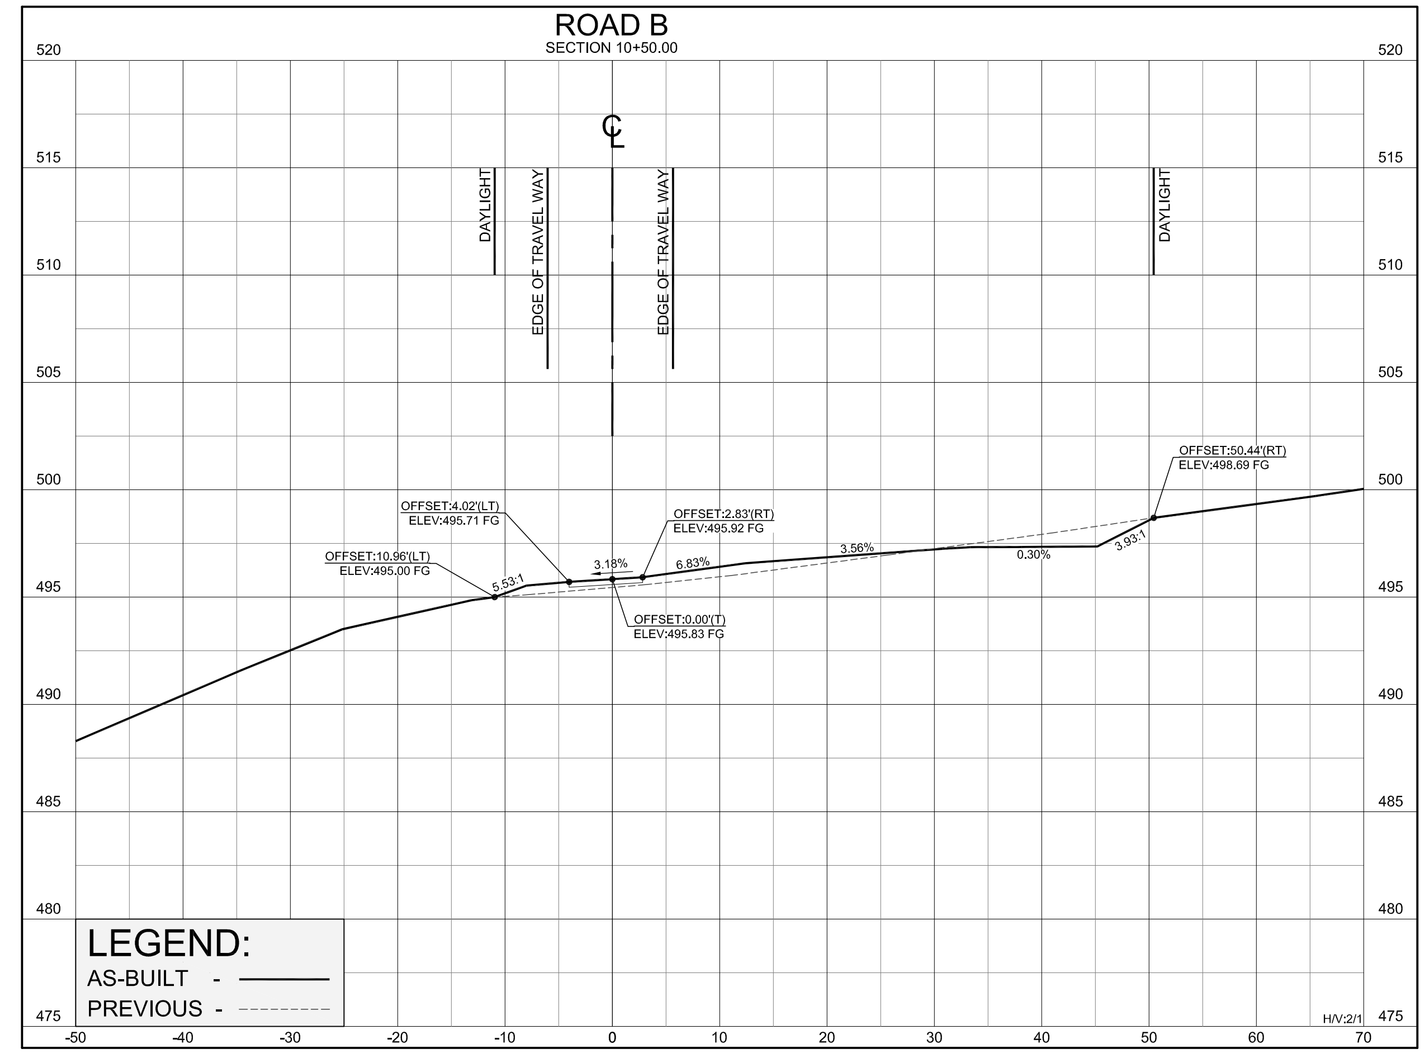

ROAD 'C'
AS-BUILT SECTIONS

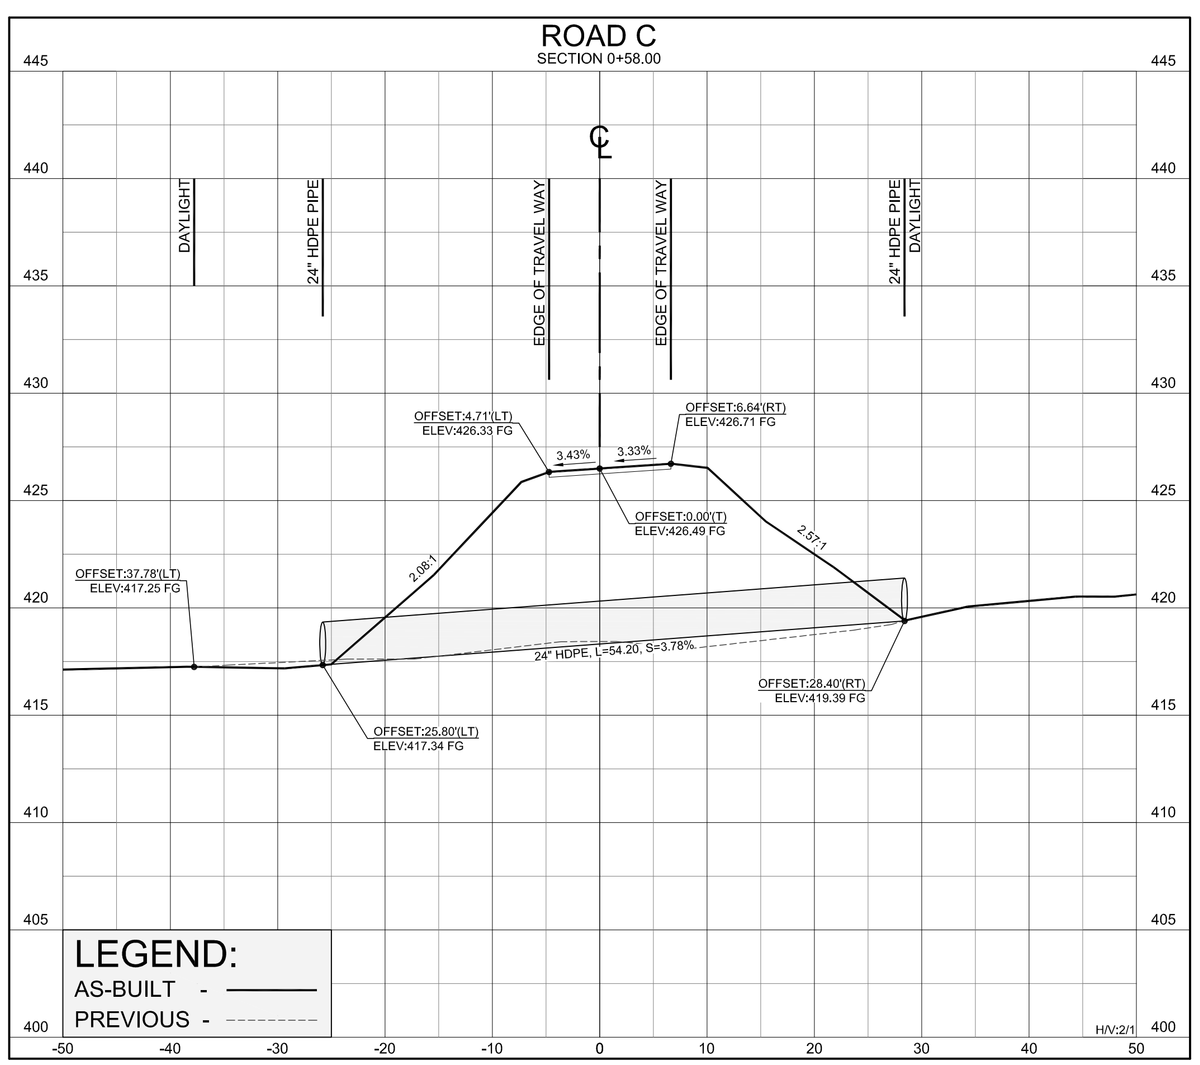

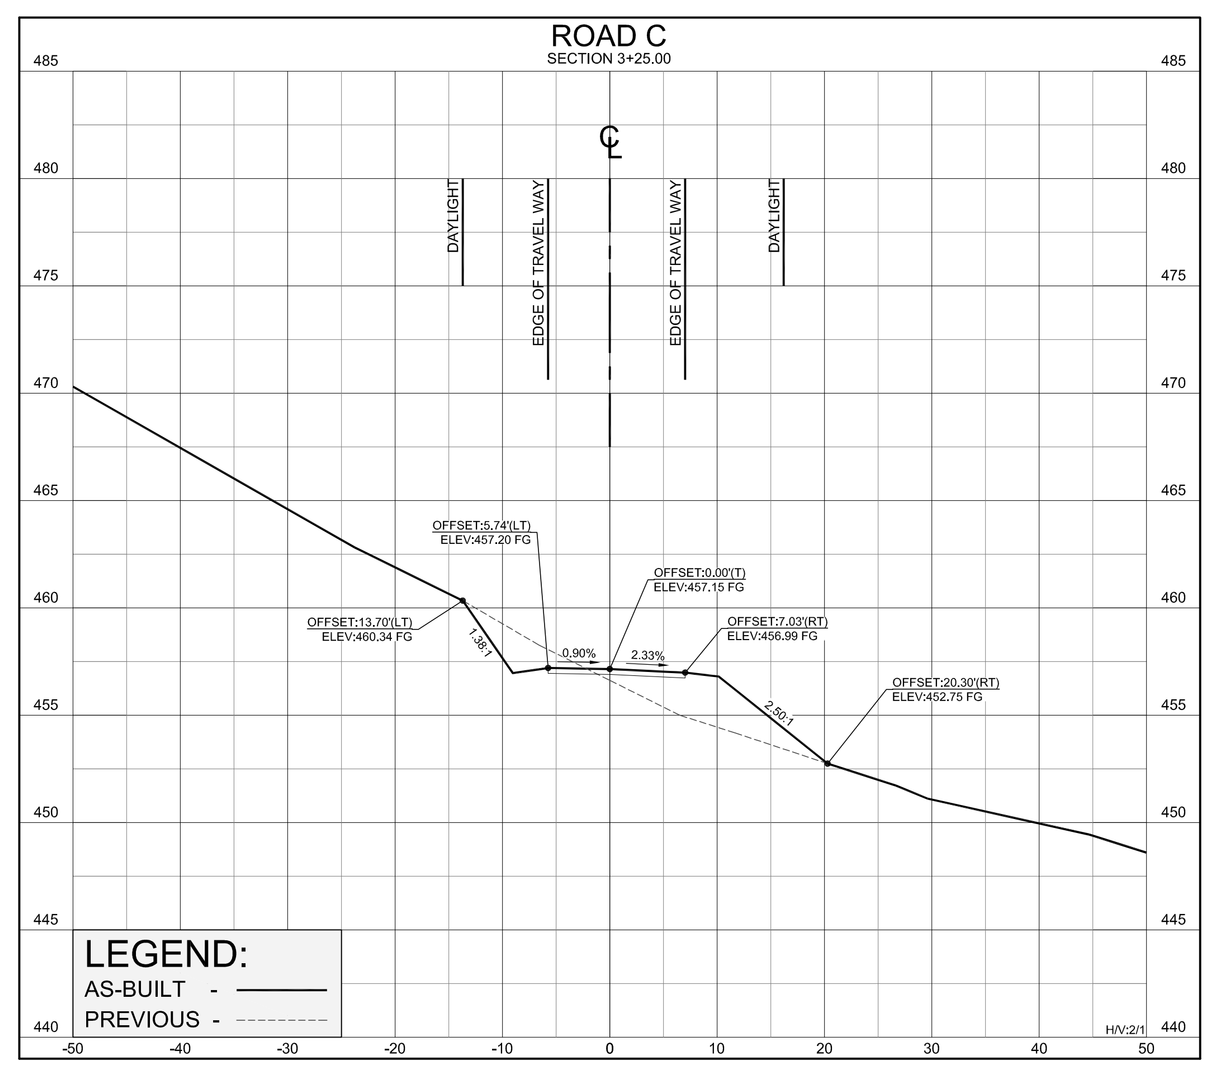

REVISION

REVISION	DESCRIPTION	ISSUE DATE	BY

PROJECT ENGINEER

DATED

REGISTERED PROFESSIONAL ENGINEER
MATT PRIESS
RCE 69213
Exp. 6/30/10
CIVIL
STATE OF CALIFORNIA

GRANITE RIDGE
ENGINEERING GROUP
240 DAFFODIL AVE. NIPOMO CA 93444
(805) 720-2958 www.graniteridgegroup.com

ROAD 'B' SECTIONS (5+25 & 10+50)
ROAD 'C' SECTIONS (0+58 & 3+25)

VERFIY SCALE
BAR IS ONE INCH
0 1"

SHEET DATA

Job Name:	MIRAMONTE RANCH
Cad File:	AS BUILT GRADING
Plot Date:	5-11-2010
Drawn By:	MP
Sheet	19 OF 21

THIS DOCUMENT, AND THE IDEAS AND DESIGNS INCORPORATED HEREIN, IN WHOLE OR IN PART, IS THE PROPERTY OF G.R.E.G.

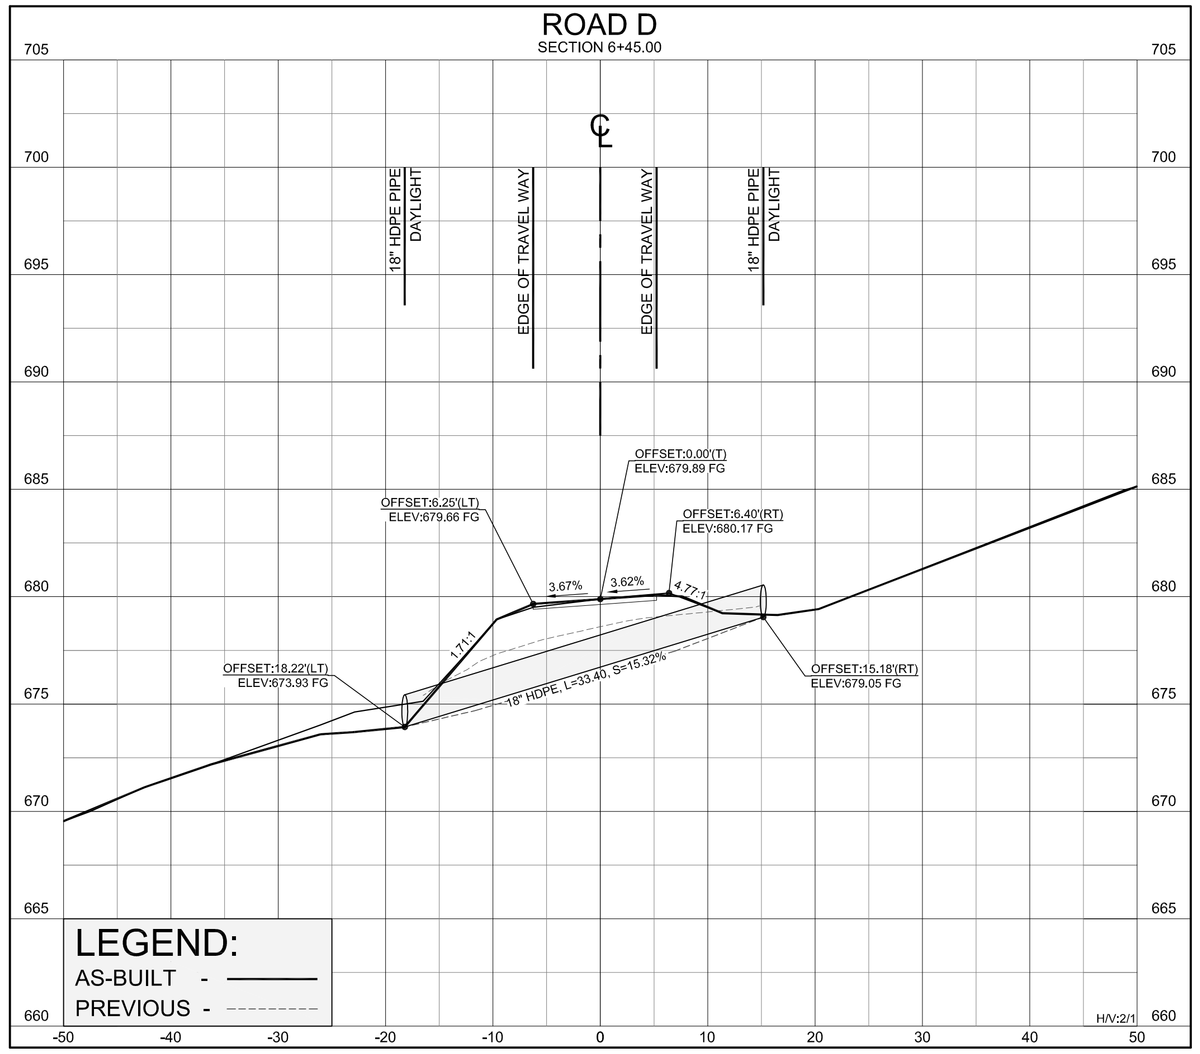

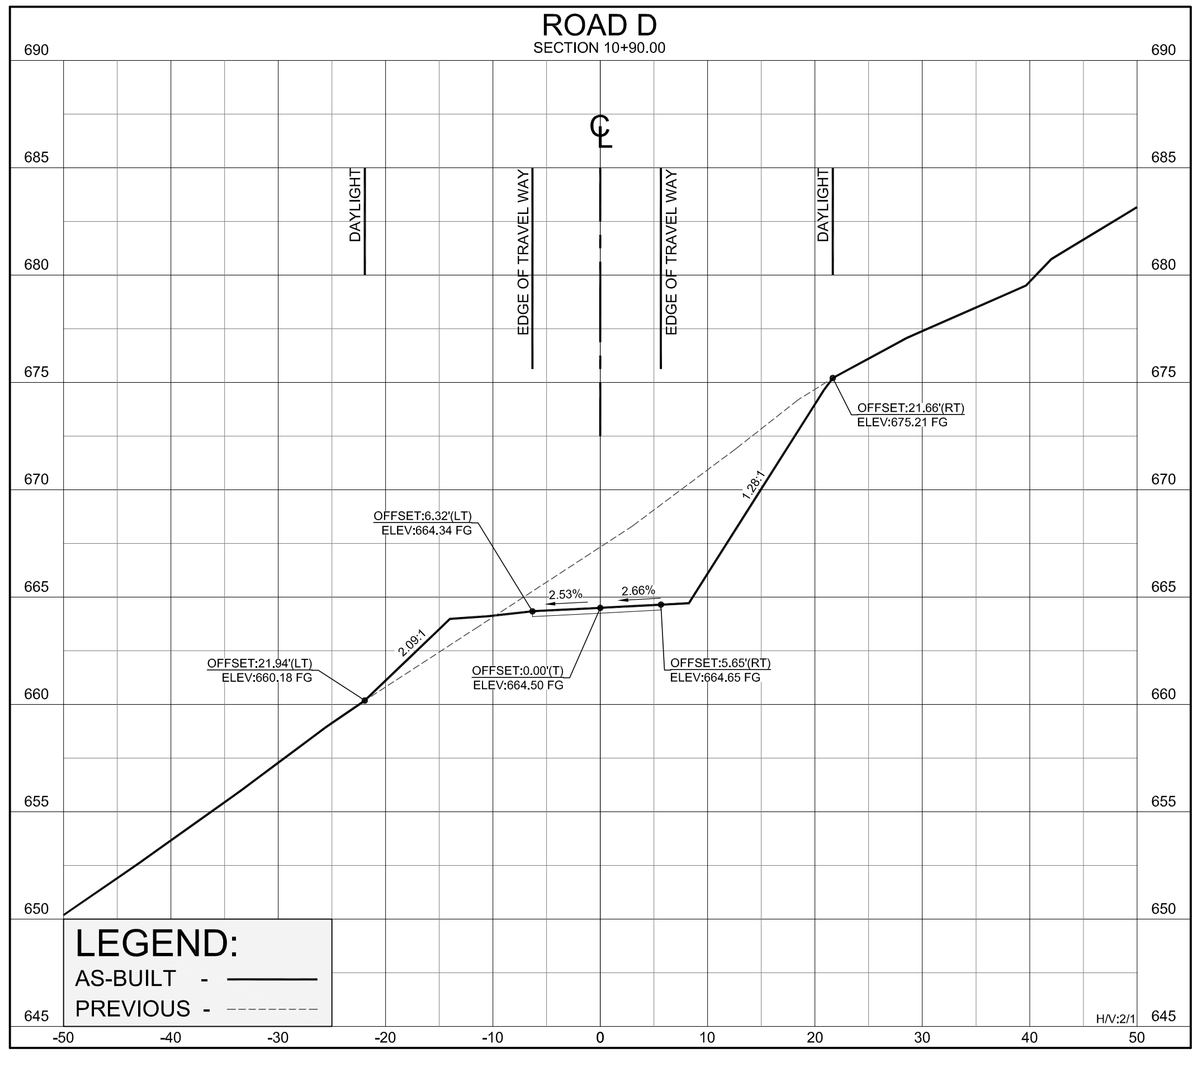

AS-BUILT SECTIONS

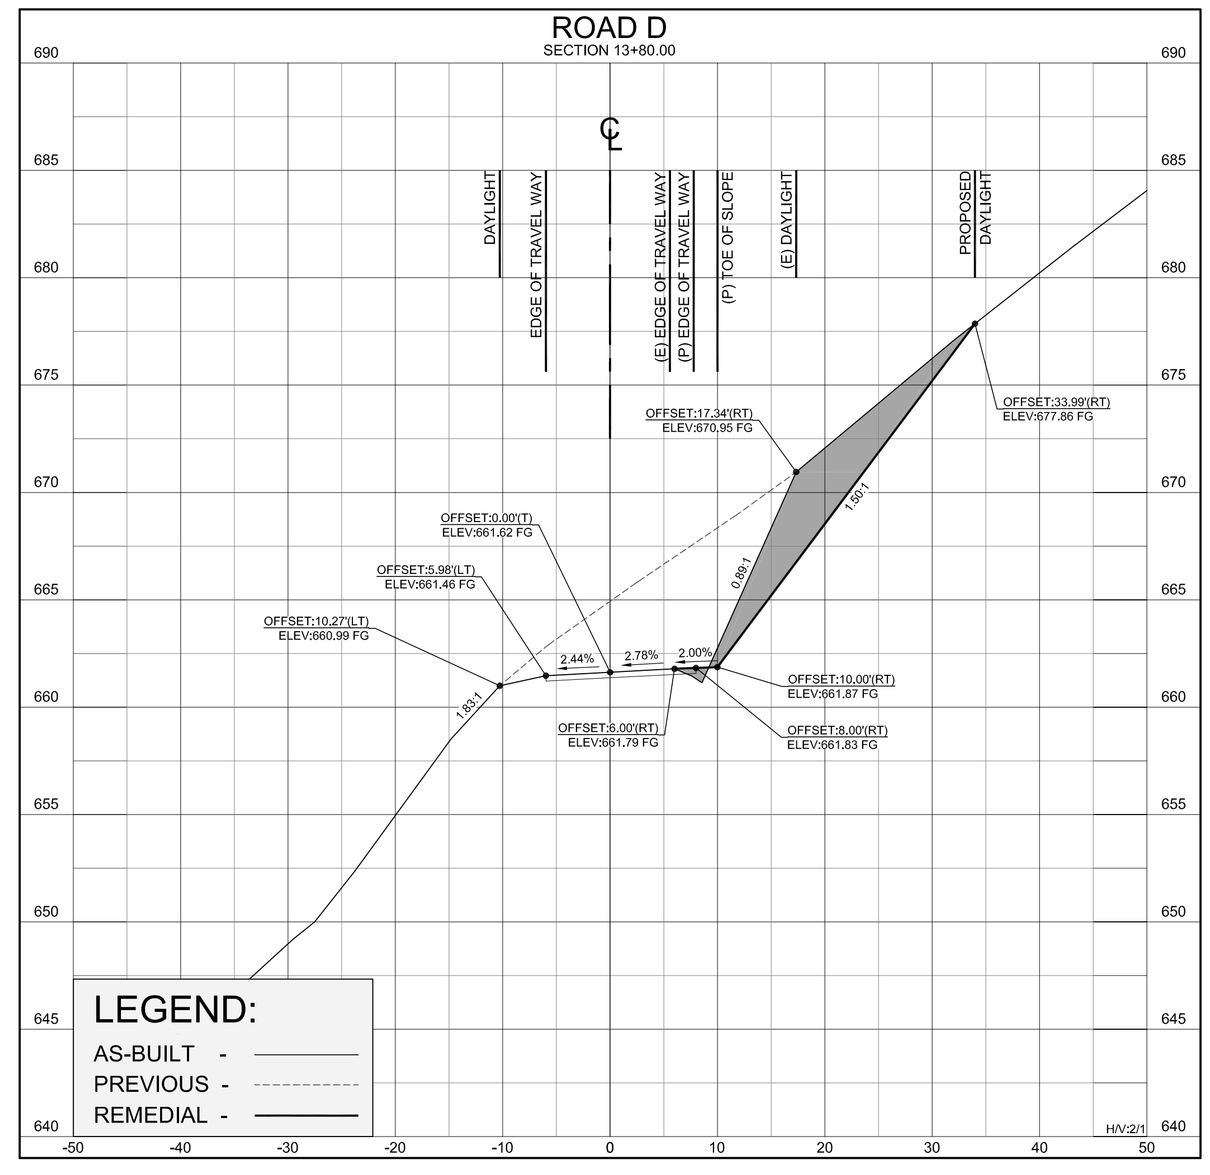

REMEDIAL WORK SECTION

REVISION	DESCRIPTION	ISSUE DATE	BY

REVISION

PROJECT ENGINEER

DATED

MARK PROFESSIONAL ENGINEER PRIESS
RCE 69213
Exp. 6/30/10
CIVIL
REGISTERED PROFESSIONAL ENGINEER • STATE OF CALIFORNIA

GRANITE RIDGE
ENGINEERING GROUP
240 DAFFODIL AVE. NIPOMO CA 93444
(805) 720-2958 www.graniteridgegroup.com

ROAD 'D' SECTIONS
(8+50) (10+90) (13+80)

VERFIY SCALE
BAR IS ONE INCH
0 1"

SHEET DATA	
Job Name:	MIRAMONTE RANCH
Cad File:	AS BUILT GRADING
Plot Date:	5-11-2010
Drawn By:	MP
Sheet	20 OF 21

THIS DOCUMENT, AND THE IDEAS AND DESIGNS INCORPORATED HEREIN, IN WHOLE OR IN PART, IS THE PROPERTY OF G.R.E.G.

AS-BUILT SECTIONS

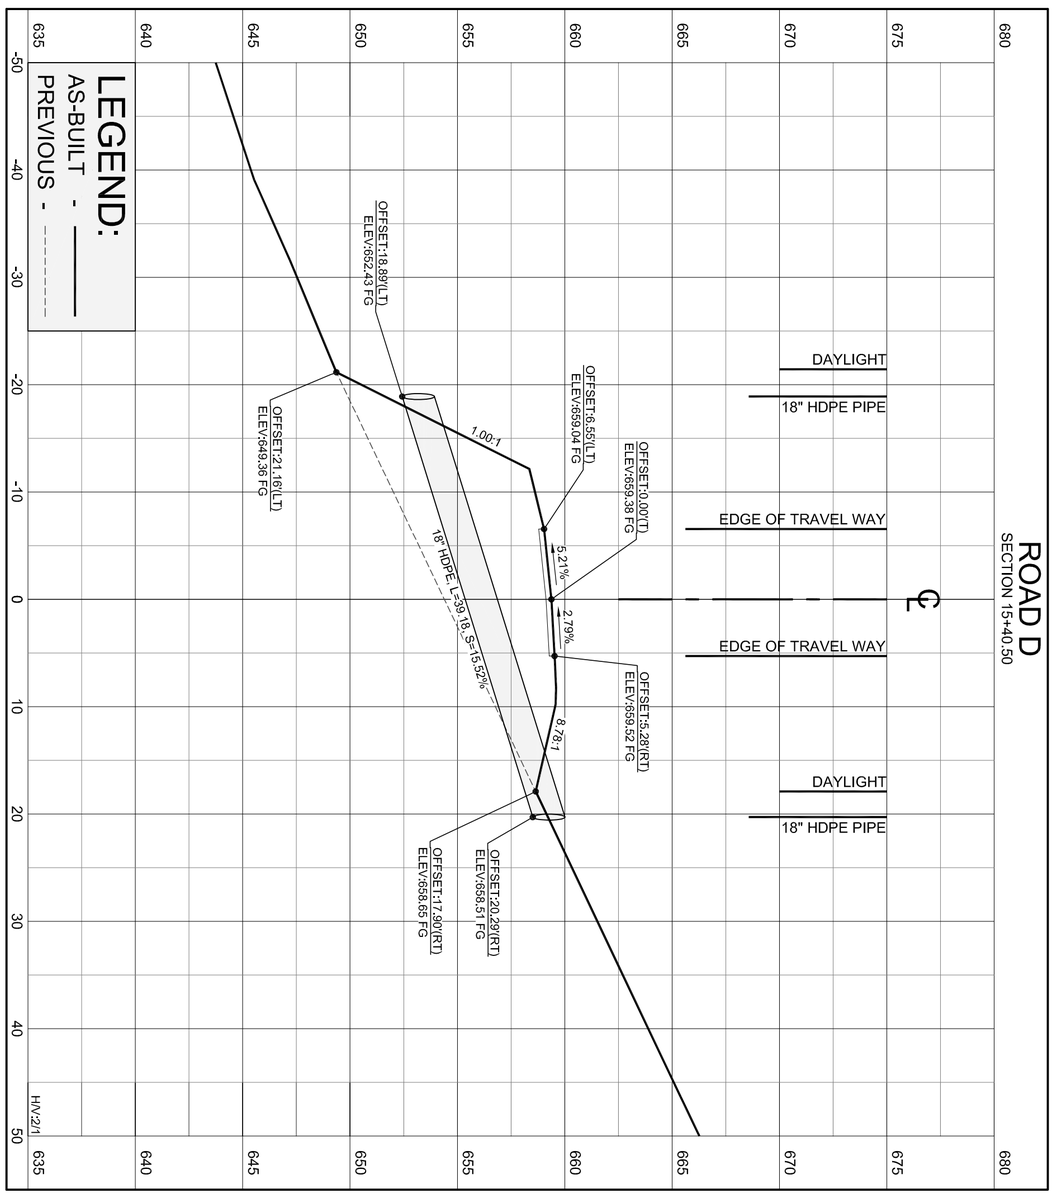

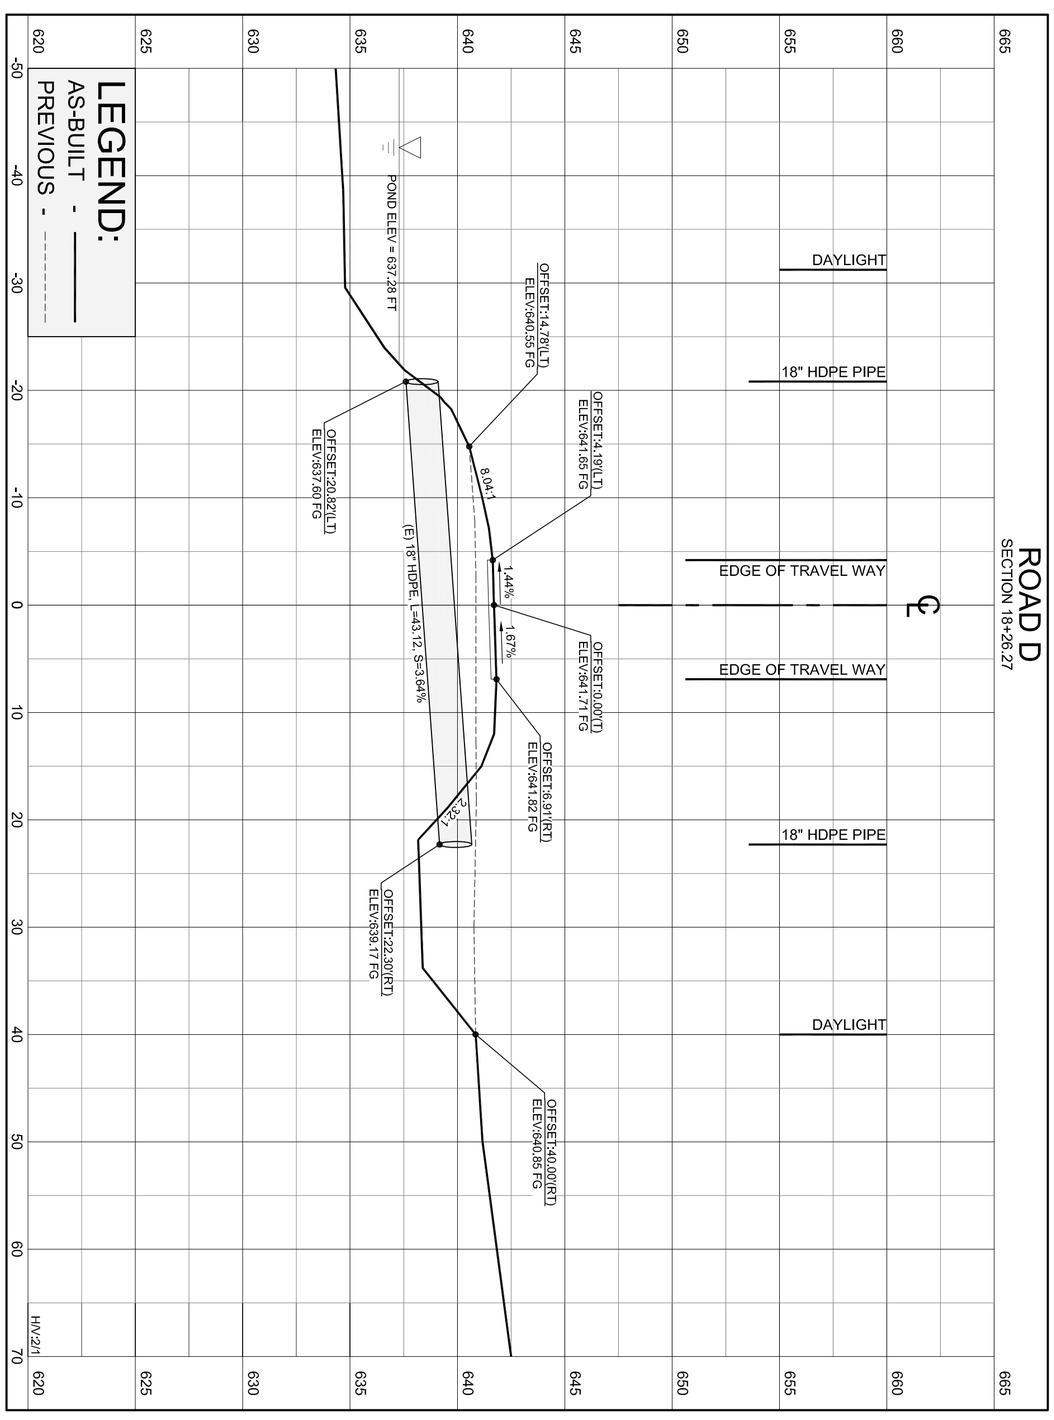

SHEET DATA

Job Name: MIRAMONTE RANCH
Cad File: AS BUILT GRADING
Plot Date: 5-11-2010
Drawn By: MP
Sheet 21 OF 21

VERFIY SCALE
BAR IS ONE INCH
0 1"

GRANITE RIDGE
ENGINEERING GROUP
240 DAFFODIL AVE. NIPOMO CA 93444
(805) 720-2958 www.graniteridgegroup.com

ROAD 'D' SECTIONS
(15+40.50) (18+26.27)

REGISTERED PROFESSIONAL ENGINEER
MATT PRIESS
RCE 69213
Exp. 6/30/10
CIVIL
STATE OF CALIFORNIA

PROJECT ENGINEER

DATED

REVISION

REVISION	DESCRIPTION	ISSUE DATE	BY

THIS DOCUMENT, AND THE IDEAS AND DESIGNS INCORPORATED HEREIN, IN WHOLE OR IN PART, IS THE PROPERTY OF G.R.E.G.